


LOTS 13845 - 13853
 BEING SUBDIVISION OF LOT 1330 (C.P.8681)
 MUKIM OF PETALING
 DISTRICT OF KUALA LUMPUR
 SCALE ONE CHAIN TO AN INCH

NOTE:
 LOT 13853 IS TO BE SURRENDERED
 FOR ROAD RESERVE.

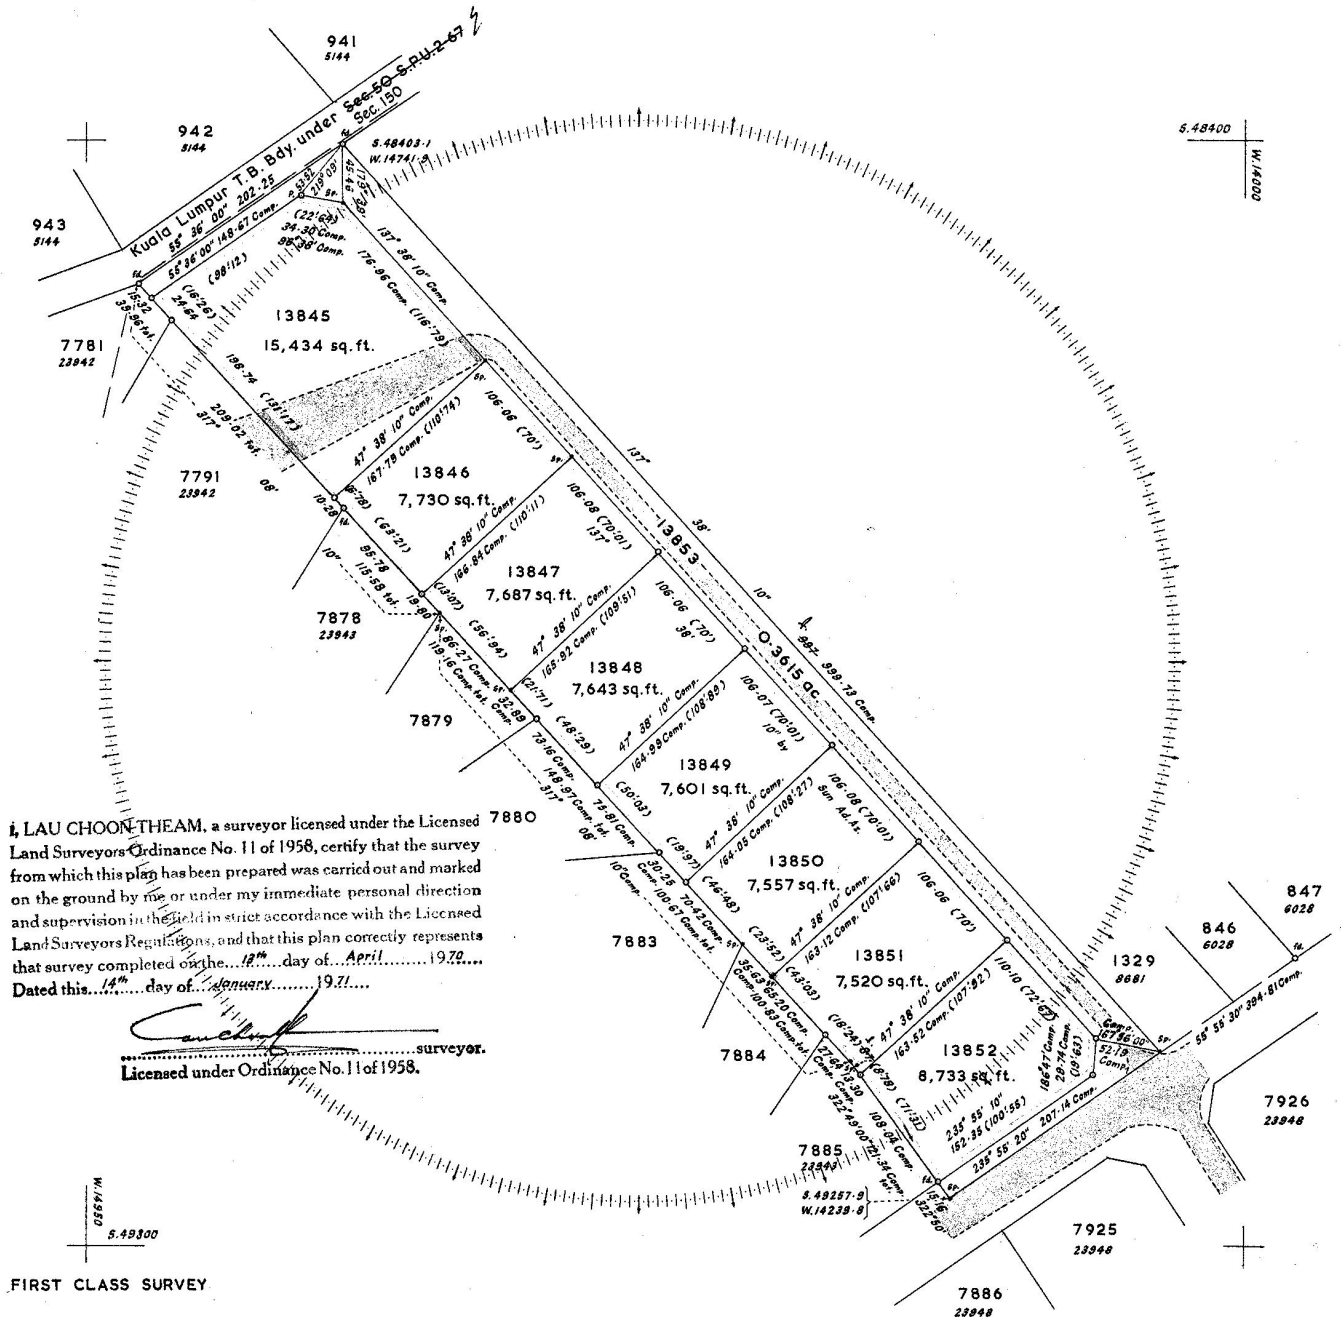

EXAMINED BY *Lee Ren*
 14-6-71

SVY. REF. P.U. BL. SEL. 28-70

SURVEYED BY LAU CHOON THEAM

APPROVED *Law To*
 20. 14. 71

L.O. REF. P.H.T. K.L. 6-833-T

FIELD BOOK 18352

CAL. VOL. 478 pp. 29-34

STD. SHEET B-93

C.P.26118