


LOTS 9757 - 9767
MUKIM OF PETALING
DISTRICT OF KUALA LUMPUR
SCALE ONE CHAIN TO AN INCH

ENLARGEMENT
SCALE FIFTY LINKS TO AN INCH

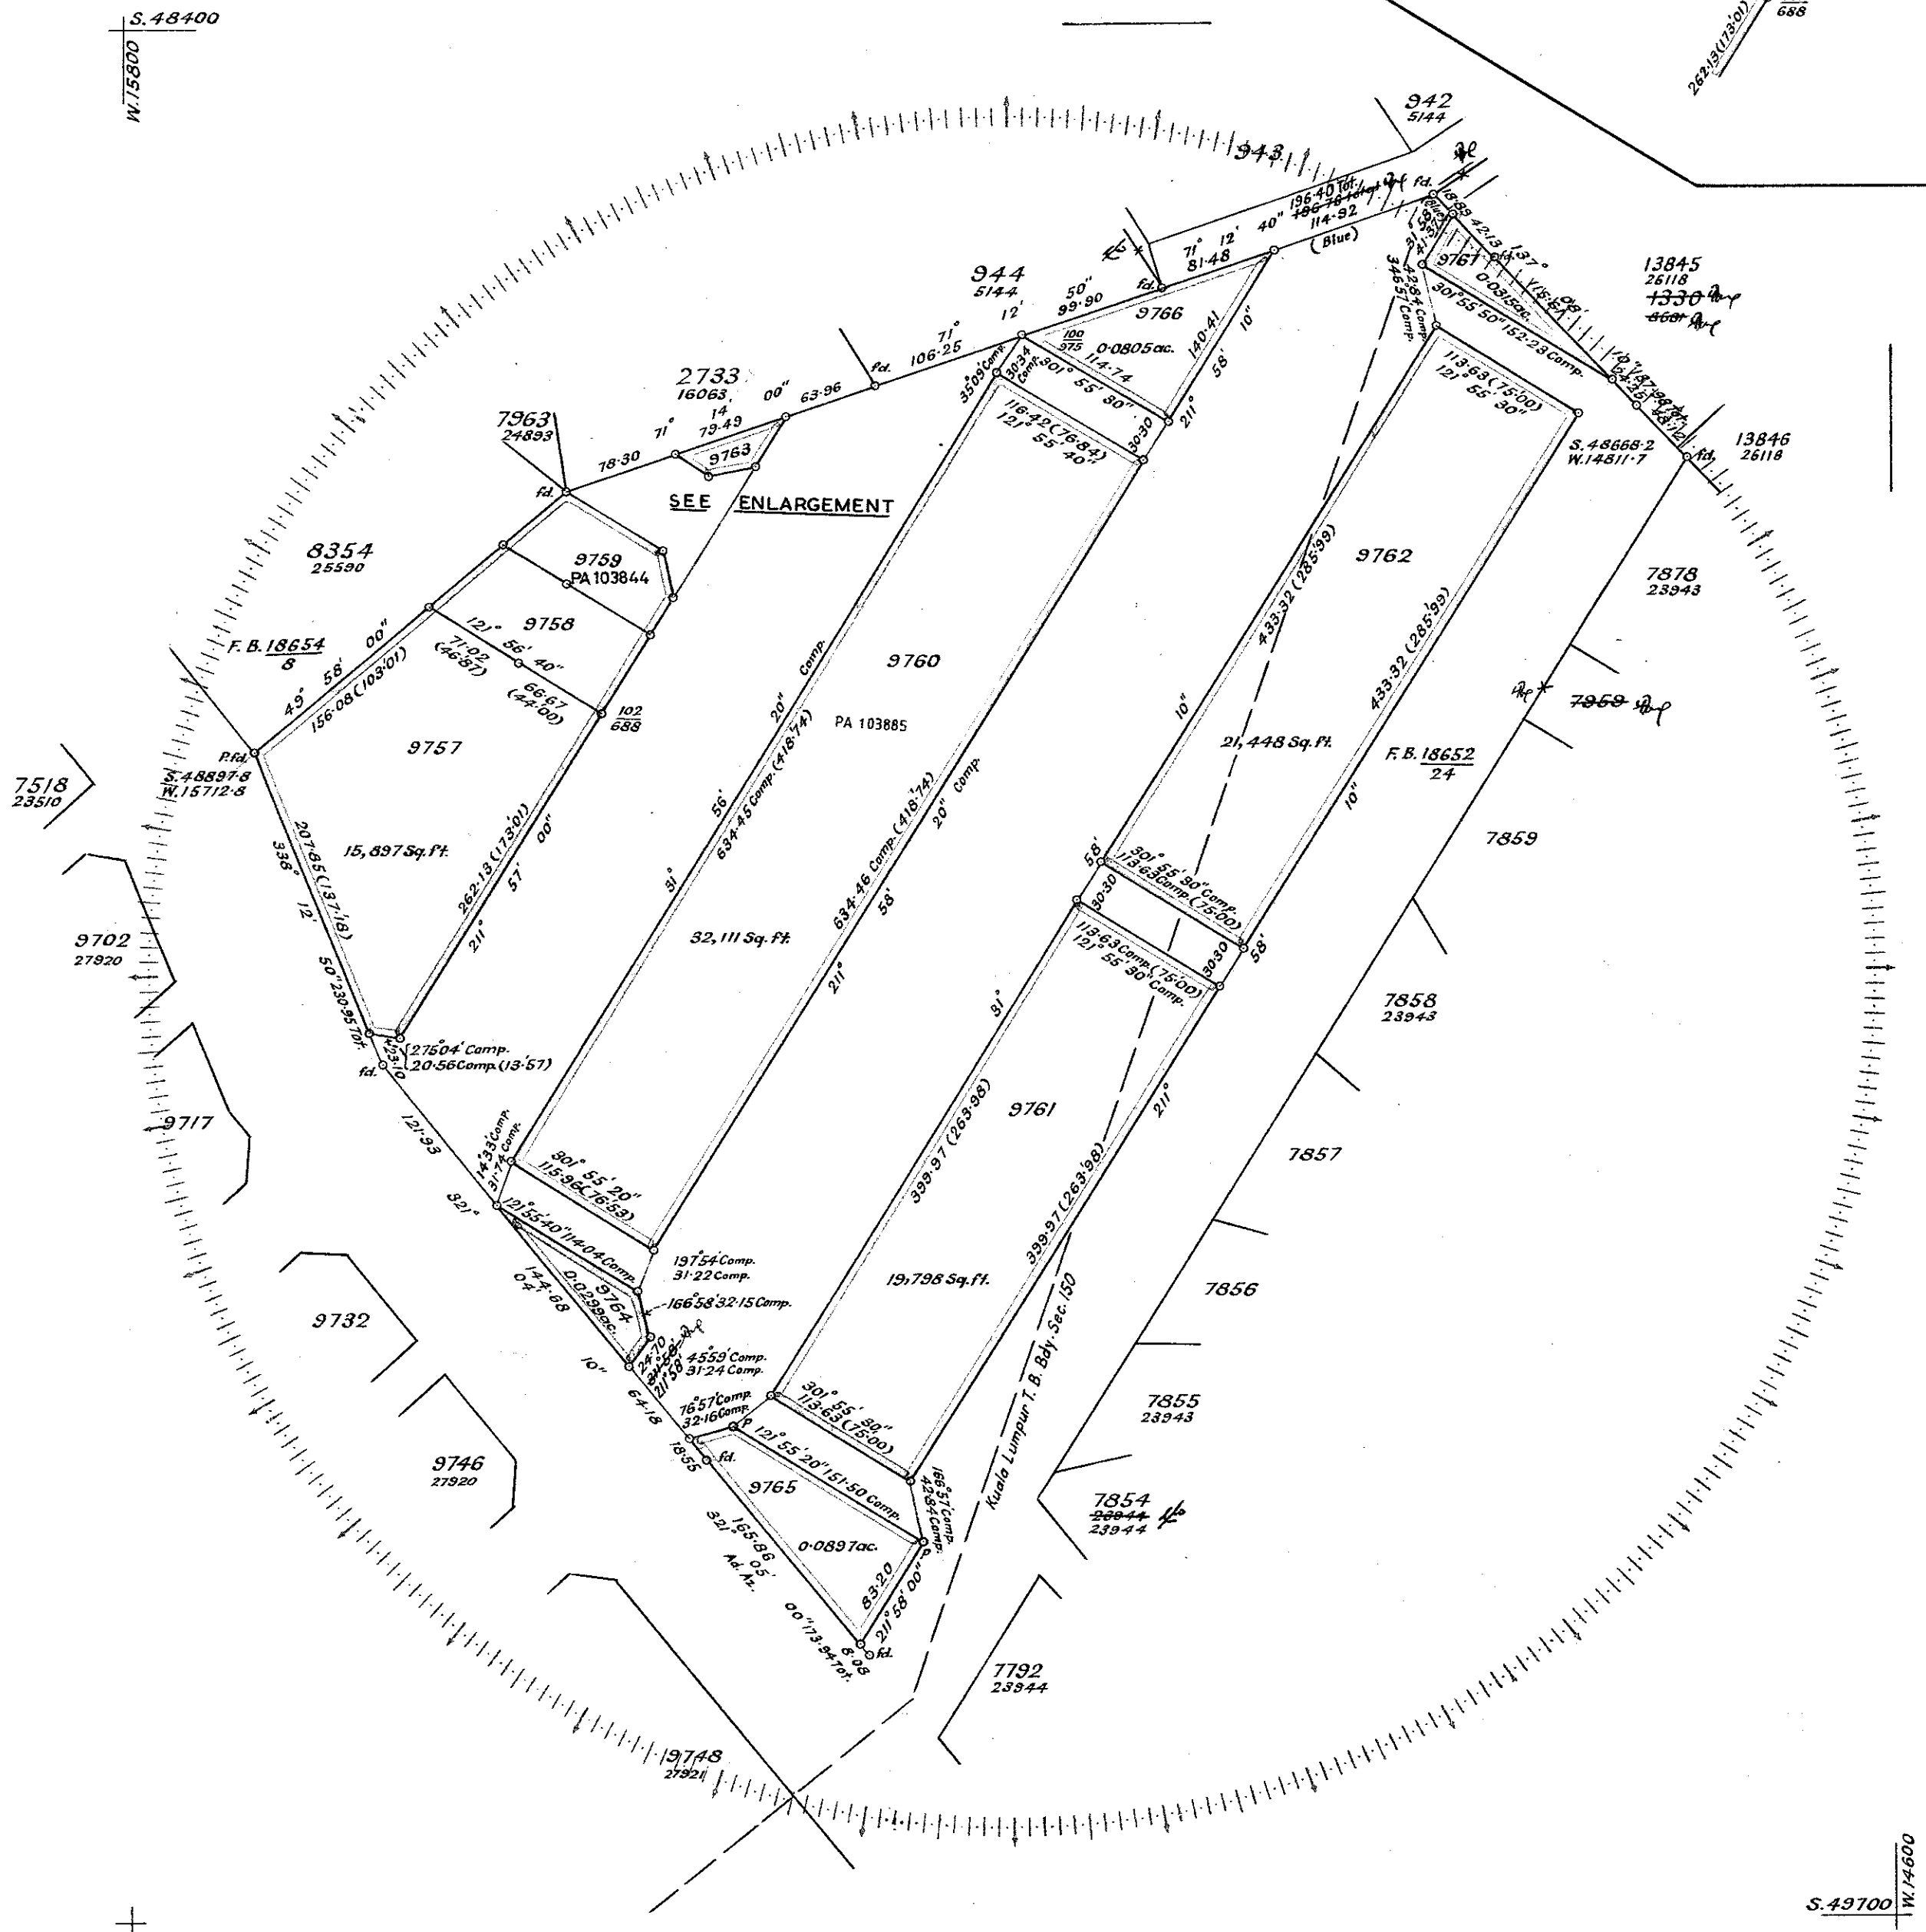

"I, ABDUL WAHAB BIN HAJI DAUD, a surveyor licensed under the Licensed Land Surveyors Ordinance No. 11 of 1958, certify that the survey from which this plan has been prepared was carried out and marked on the ground by me or under my immediate personal direction and supervision in the field in strict accordance with the Licensed Land Surveyors Regulations, and that this plan correctly represents that survey completed on the 16th day of April, 1962.
Dated this 24th day of December, 1962.

[Signature]
Surveyor,
Licensed under Ordinance No. 11 of 1958.

STD. SHEET 93 - B

SVY. REF. P. U. BL. SEL. 43 - 67

L. O. REF. P. H. T. K. L. 6 | 1524 | 68

CAL. VOL. 453 pp. 142 - 147, & 149 - 151 & 2

SURVEYED BY HJ. A. WAHAB B. HJ. DAUD

FIELD BOOKS 18652 & 18654

FIRST CLASS SURVEY

EXAMINED BY *[Signature]*
31/5/72
APPROVED *[Signature]* 8.2.72

CP 27919