


Aug. 279
01

SUB CIRCUIT 3 CIRCUIT 9 K LUMPUR

Scale, 4 Chains to an Inch
882

P.20457

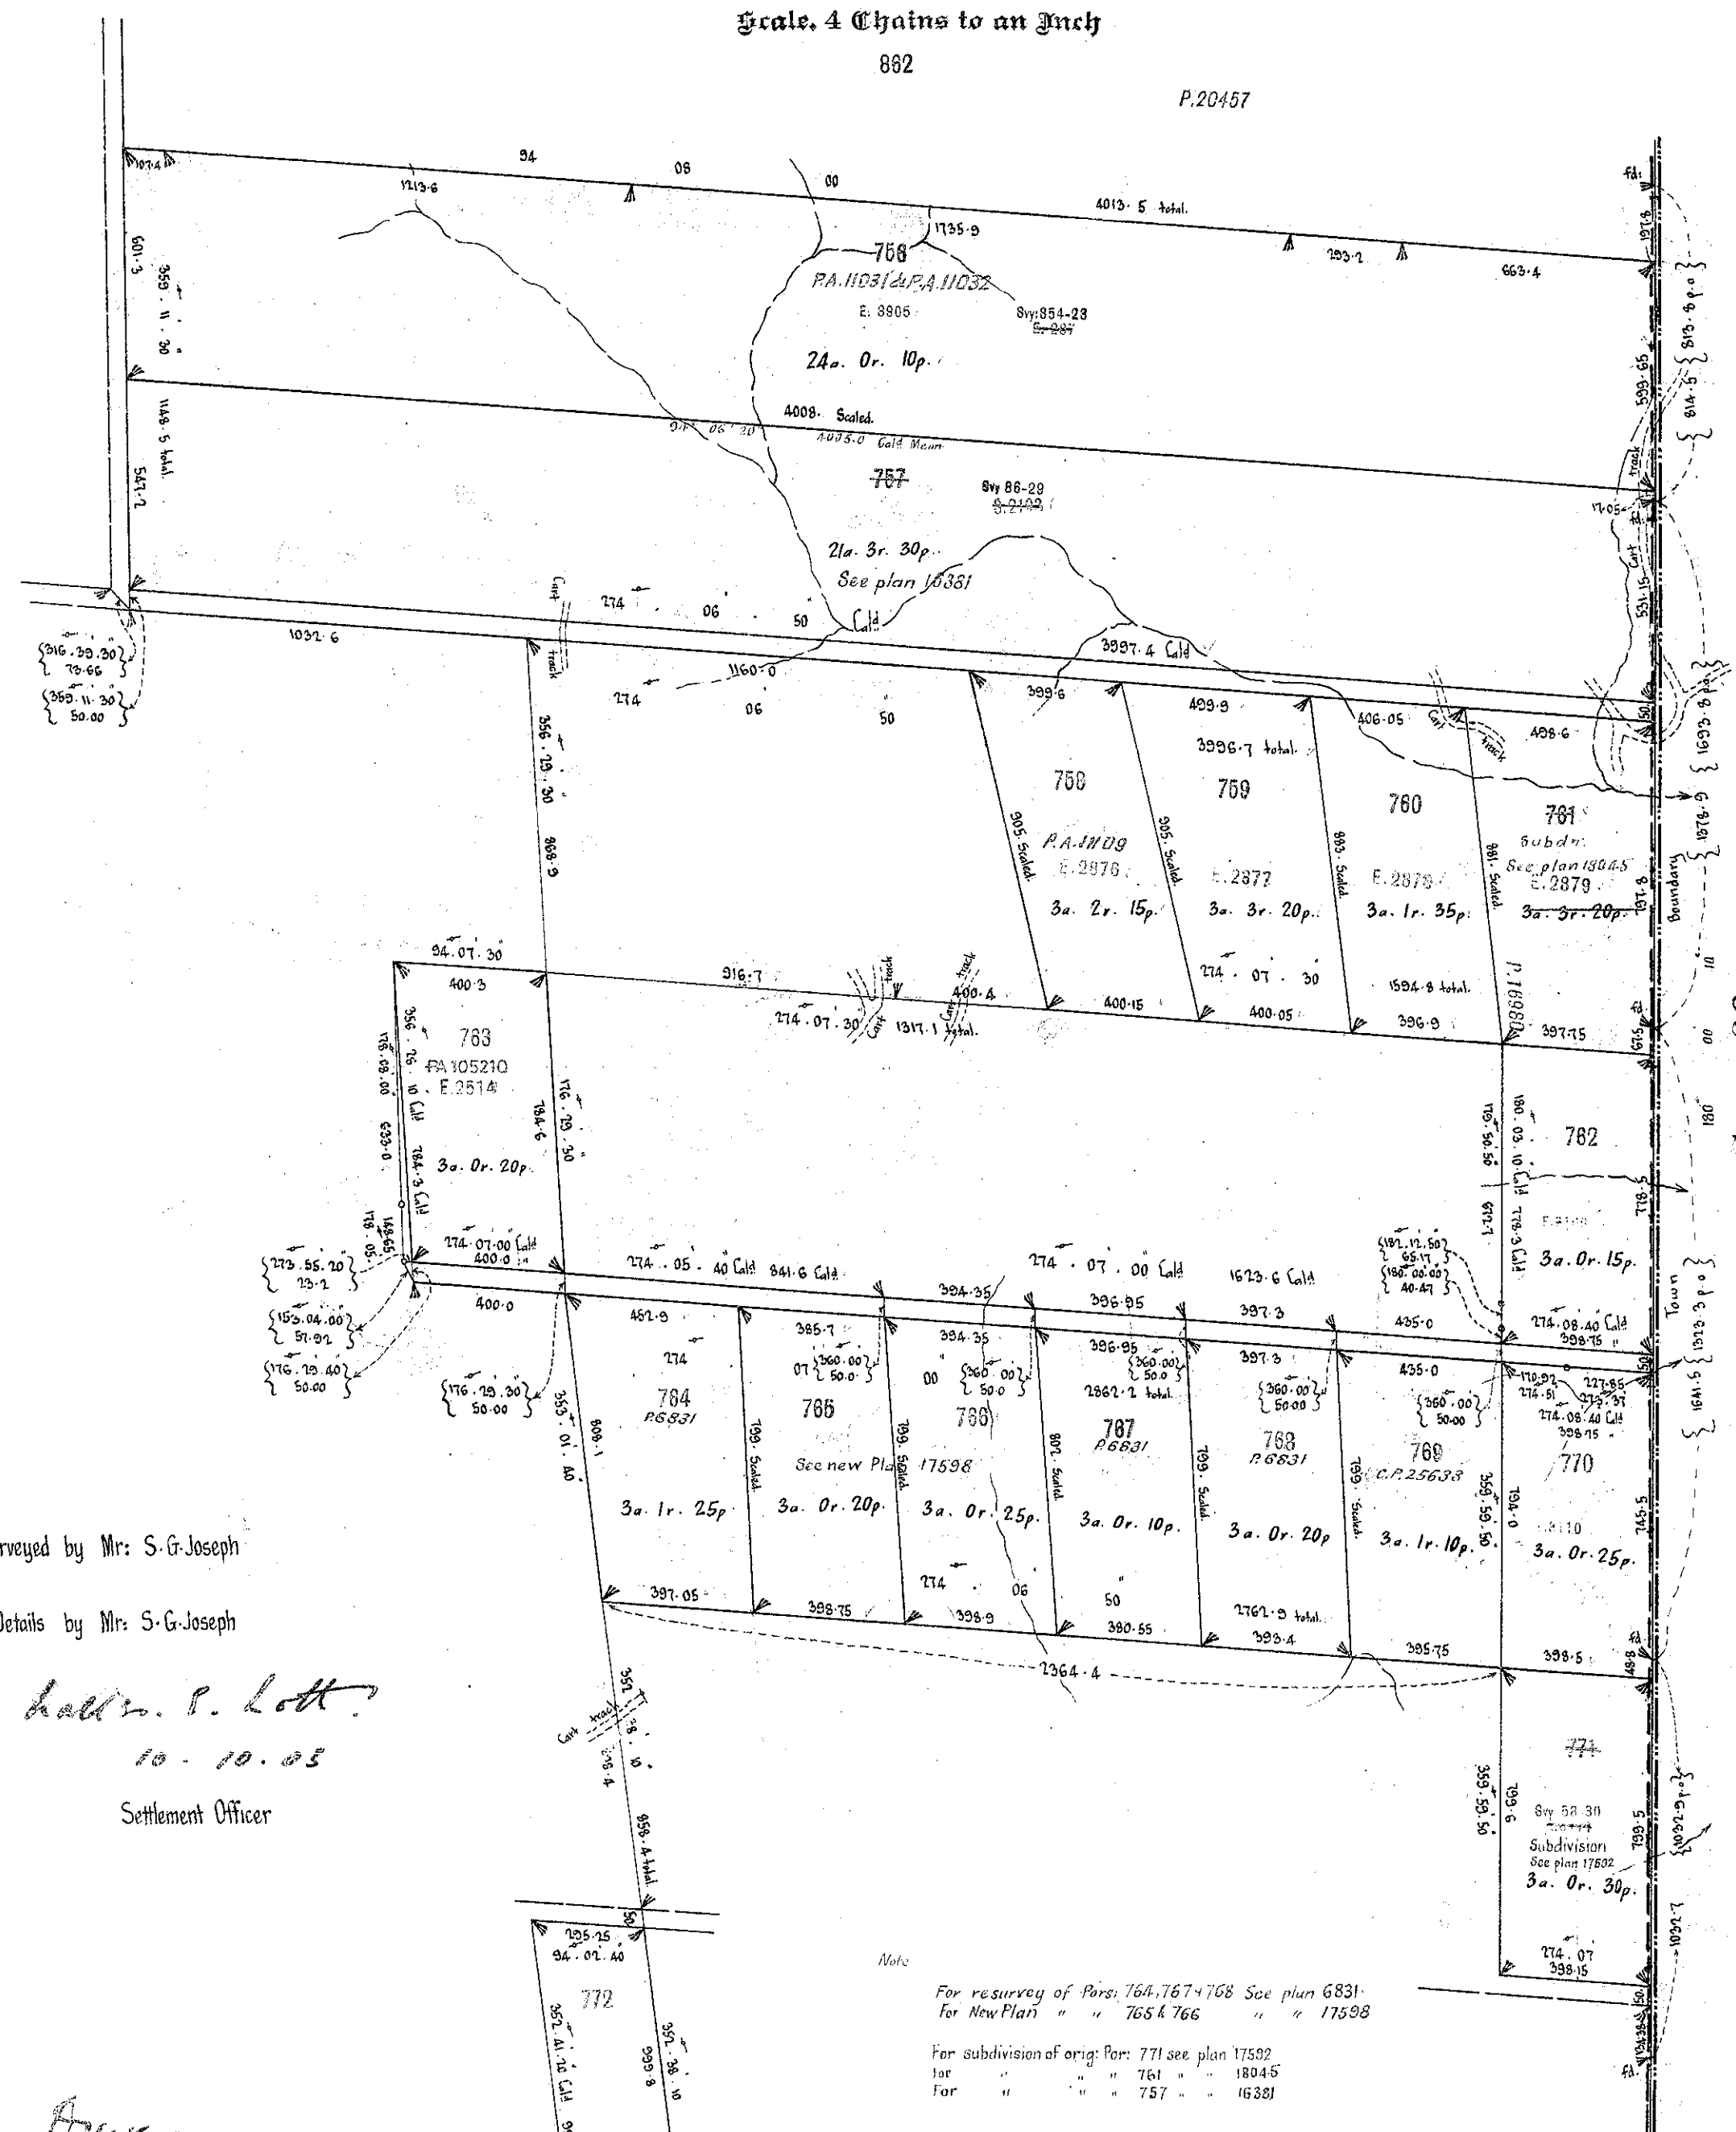

Circuit surveyed by Mr: S.G. Joseph

Interior Details by Mr: S.G. Joseph

Settled by *John P. Lott*
10. 10. 03
Settlement Officer

Drawn by *James*
Examined by *John P. Lott*
Charted by *McGowan*
Plan approved *10. 10. 03*

Field Book 631 pages 21 + 36 + 40 + 45

Note
For resurvey of Pars: 764, 767-768 See plan 6831
For New Plan " " 765 & 766 " " 17598
For subdivision of orig: For: 771 see plan 17592
for " " 761 " " 18045
For " " 757 " " 16381

Sanitary Board Area vide G.O. 112/1902-03

Gas. Not: 92-06 recorded vide G.O. Not: 164-00

B. McGowan
District Surveyor
10. 10. 03

Extract for portion 763 prepared and forwarded Vide Svy: 551-10
Extracts for portions 758 to 761 do 369-13
do 762, 770 & 771 do 1157-15
do 756 do 661-23
do 757 do 138-29

Extracts prepared and forwarded on 10. 10. 03 to G.O. 30.9 (S.C. 30.9 K.L.) G 22 B: 85.