

PLAN
of Section 17
KUALA LUMPUR


Scale 40 Links to an Inch

John Wellford
Chief Surveyor
Selangor

W. H. Treacher
British Resident
Selangor

Allot.	Title	Survey	Area
22		Sy. 555-08 Sy. 757-12	1'6p.
21		Sy. 555-08	3'5p.
20		Sy. 555-08 Sy. 757-12 Sy. 1736-10	2'4p.
18		Sy. 1736-10	1'8p.
17		Sy. 1736-10	4'4p.
16		Sy. 806-07	1'9p.
41			1'34p.

Note: -
For Subdivision of Allots: 1 to 3 See Plan 5873
For Subdivision of Allotment 37 See Plan 6038
For Subdivision of Allotments 20 to 23 See Plan 5310
For resurvey of Allot: 28 Sec. 17 see Plan 9338
For subdivision of Allotments 7, 8, 10, 29 & 39 see Plans 5465 & 9747
Allotments 43 & 44 now formed into Allotment 80 see Plan 3747
For Resurvey of Allotment 4 see plan 11443
For subdivision of Allotments 9 & 29 see Plan 6365
Subdivision of Allot. 29 was done in anticipation see Plan 365
Allot: 29 stands as it is
For subdivision of Allotment 37 see Plan 6038
Allotments 11 to 17 Cancelled see plan 7427
For resurvey of Allotment 32 see plan 13100
Lots 35, 36, 38 cancelled see Plan 18959
For Subdivision of Lot 34 see Plan 16561
Boundaries of Allots in black
Walls, pillars & wooden partition in vermilion
Traverses in blue

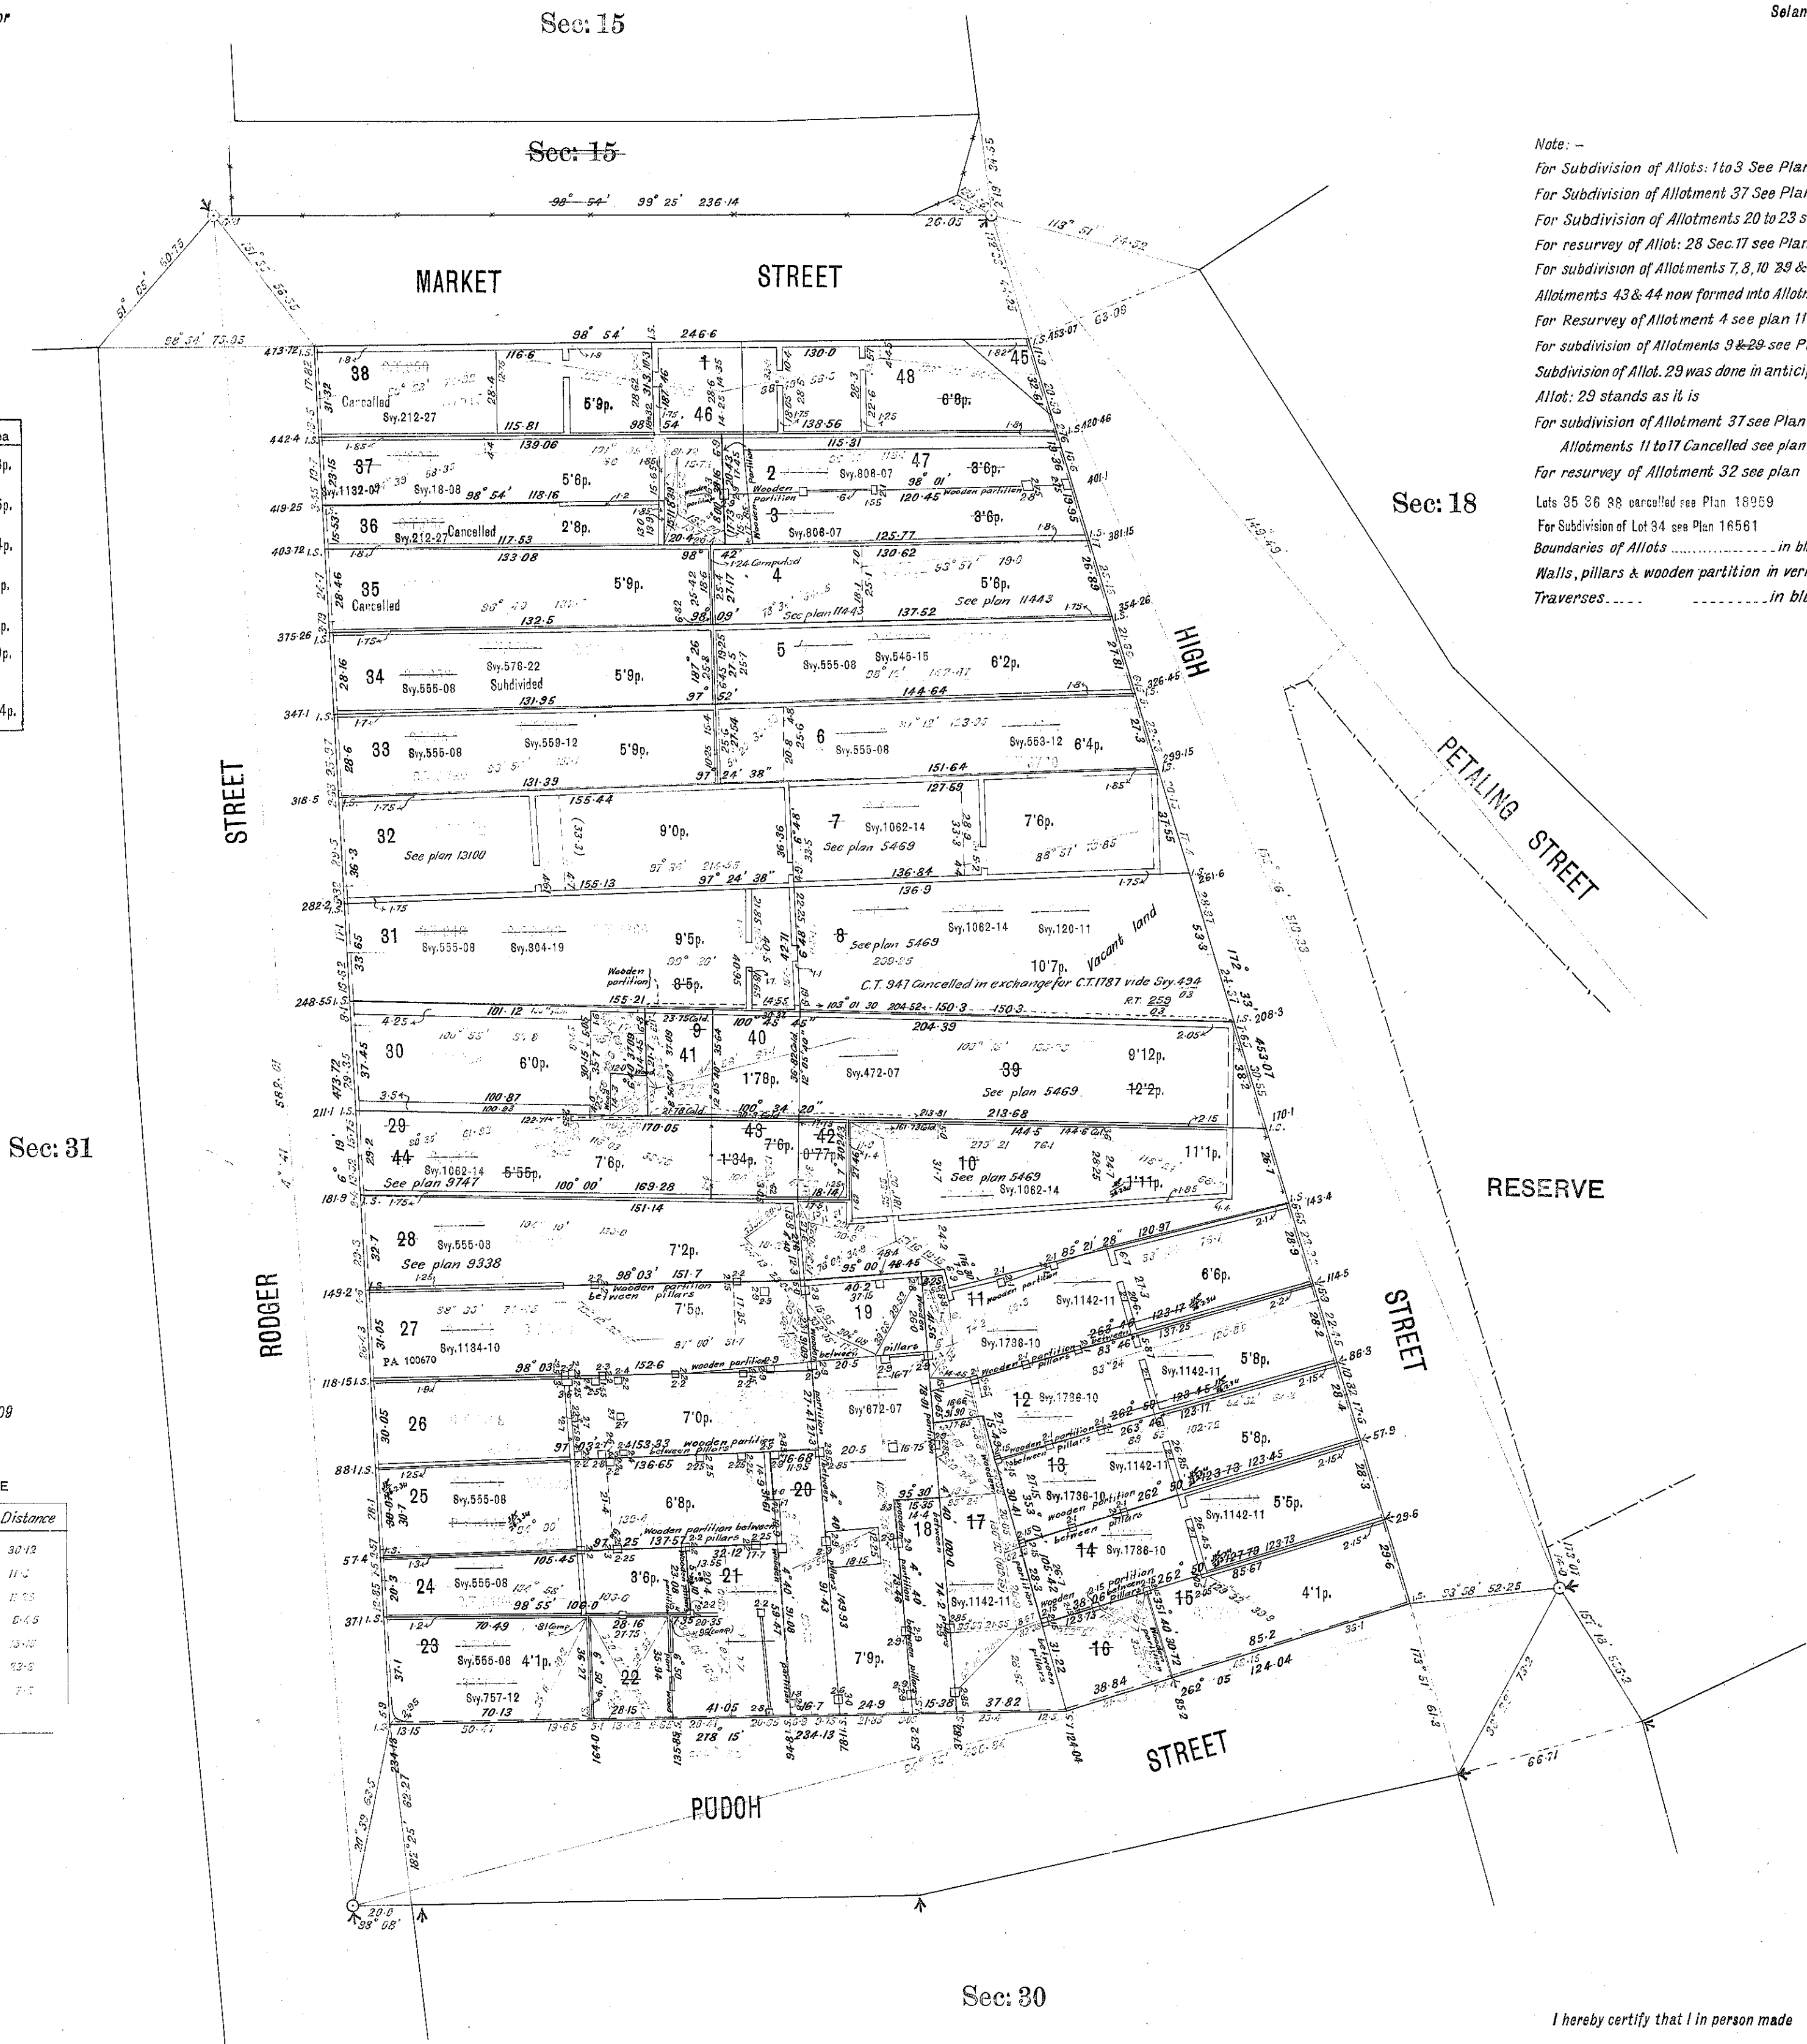

Line	Bearing	Distance
A	12° 37' 00"	30.12
B	72° 00' 00"	11.5
C	0° 00' 00"	11.78
D	81° 38' 11"	0.48
E	3° 11' 15"	13.10
F	7° 11' 08"	23.5
G	77° 46' 30"	7.5

True copy of Plan 27 as at 16. 2. 34 (Orig. Scale 20 Links)

Asst. Supt. Rev. Surveys.

I hereby certify that I in person made
and in October 1892 completed the
Survey represented on this plan on which
are written the bearings and the lengths
of the lines measured by me and I
declare that the survey is correct.

S. T. Debney
Surveyor

Date of Transmission April 1893

Field Book 67 pages 80-49