

Nota:
Sebahagian dari Mukim Klang, Daerah Klang telah diisytiharkan
menjadi Bandar Kota Kemuning, Daerah Klang melalui P.W.K. Negeri,
Selangor No. 451 bertarikh 3.02.2022


Lot 3442 & 3443 masing - masing ditukar menjadi
Lot 3442 & 3443 Bandar Kota Kemuning

(Sr LOOI KAM SENG)
Pegarah Ukur dan Pemetaan
Negeri Selangor

7/10/2024

PLAN
of Portions 3442 & 3443
being subdivision of Portion 1243
surveyed for issue of title by entry in the mukim register
~~MUKIM OF KLANG~~
DISTRICT OF KLANG

Scale Four Chains to an Inch

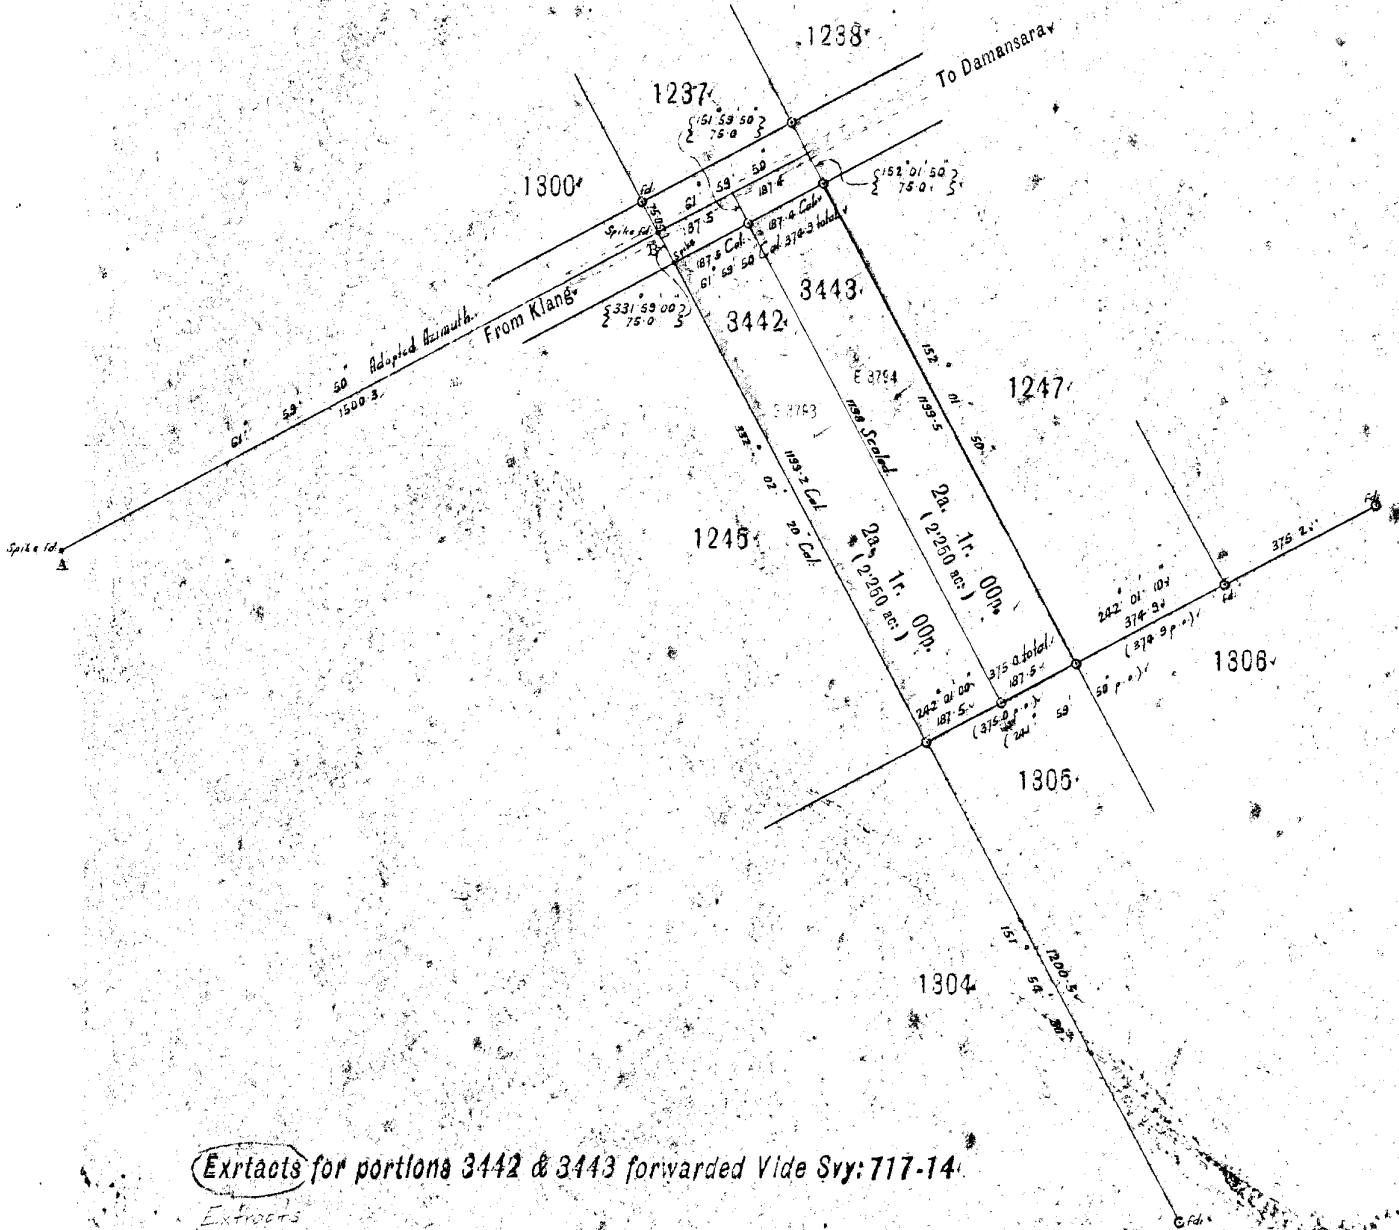

Azimuth taken from A. B.

Third Class Survey

Drawn by *Abdullah*
23/1/15

Examined by *M. B. Johar*
15.2.15

Charted by *Alam*
22/2/15

Plan approved *Rejitha*
5.11.15

Cal. Book Vol. 86 P 108

I hereby certify that I have examined the boundaries
delineated on this plan and that they are correctly located
on the ground and marked as shown hereon.

K. Chellappah
Settlement Officer.
12.4.15

Survey Paper No. 717-14

Field Book 3828 pages 2

Sheet No.

G 31.

Plan No.

10918.

Surveyed by K. Chellappah.

Examined by

H. F. J. Perera

District Surveyor.