

# SUB-CIRCUIT 19

## CIRCUIT 10


### KLANG

Note:

For subdivision of orig. Por: 1305 see F. B. 5522 pp 7&8 Svy: 693 - 19

Ref. 2.20

Scale Four Chains to an Inch

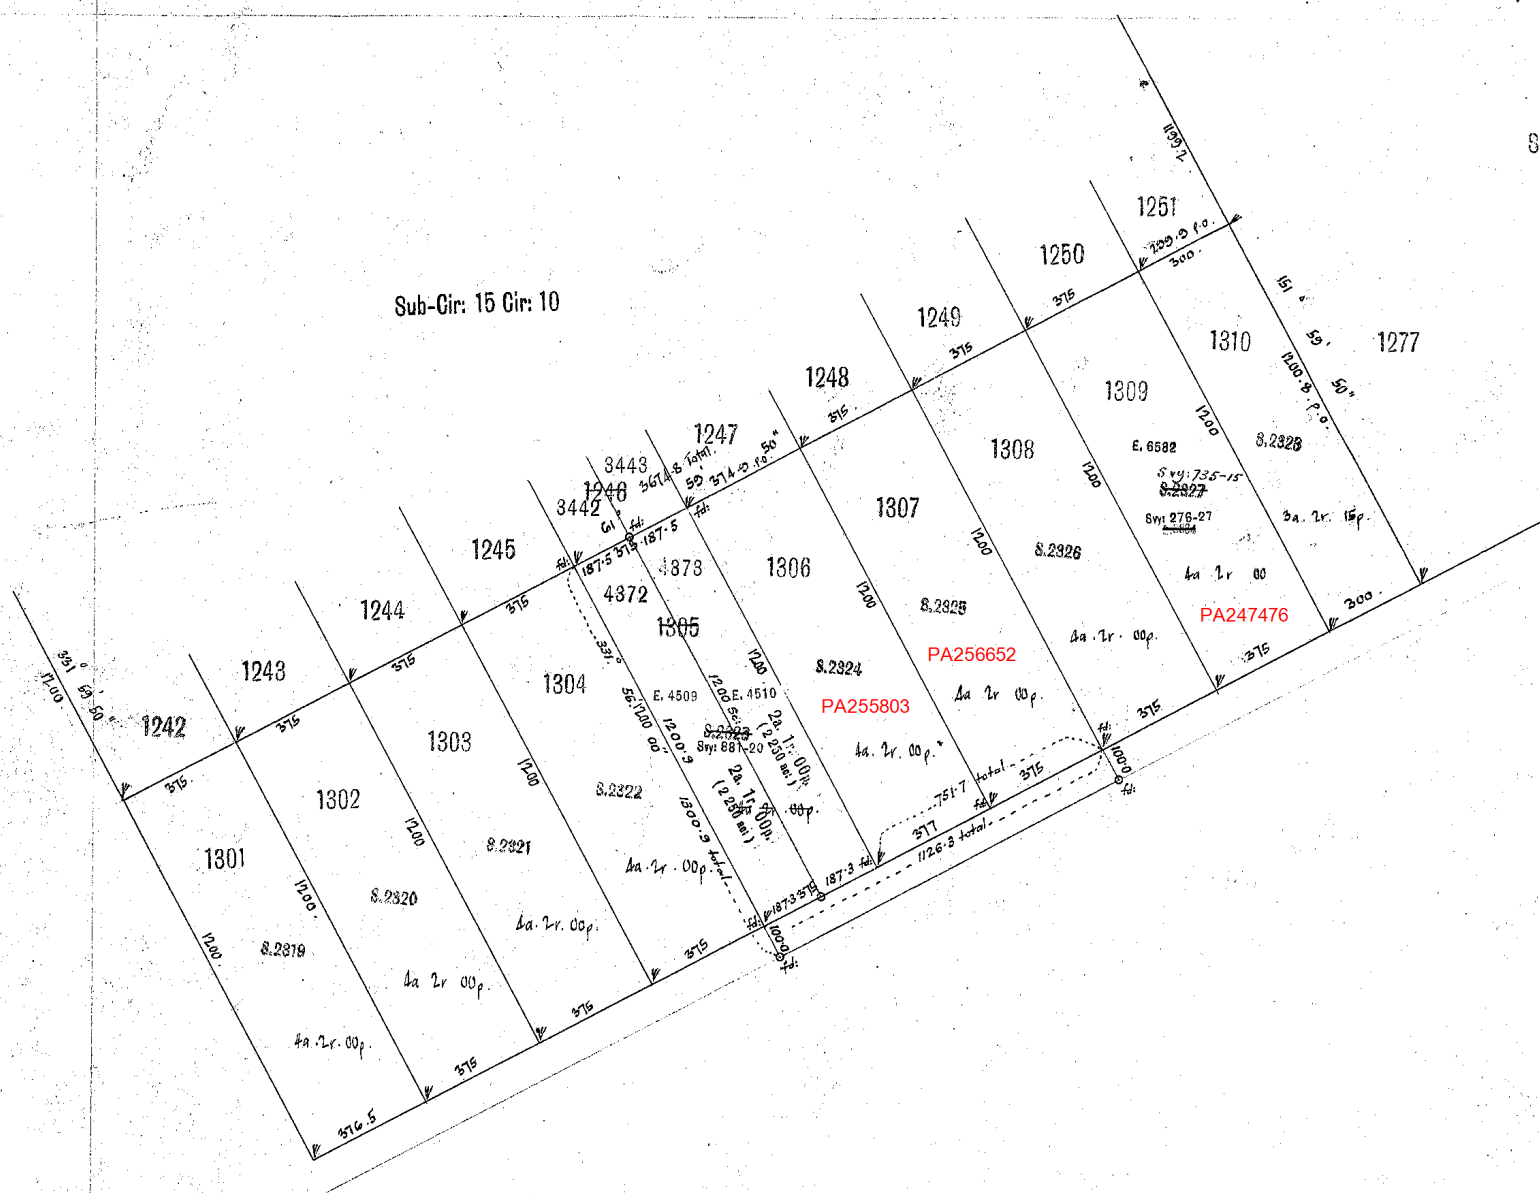

Demarcated by Mr. Jaamat.

Drawn by *Chan Kih Chuk* 10. 6. 04

Charted by *Chan Kih Chuk* 15. 6. 04

Checked by *Do* 18. 6. 04

Plan approved *W. T. W.* 12. 9. 04

F.B. 837 p. 4.

No circuit survey or check around this work.  
(Nide Circular No 12 of 1903.)

Extract for portion 1309 forwarded Vide Svy: 1484-18  
do 1309 do 499-15  
do 4372&4373 do 683-19  
do 1309 do 120-27

Extracts prepared and forwarded on 13. 9. 04 Book No 3 Svy. 453 04

M<sup>r</sup> R. A. Crawford

District Surveyor.

Boundaries examined and found correct

*Esopha Stenher*

Settlement Officer.

30/8/04