


PLAN
of Portions 962 - 971 & 974 - 985
 surveyed for issue of title by entry in the mukim register
MUKIM OF TANJONG DUABLAS
DISTRICT OF KUALA LANGAT

Scale Four Chains to an Inch

Note
 For Subdivision of Por. 975 see Plan 15877
 For Subdivision of Por. 962 see Plan 15997

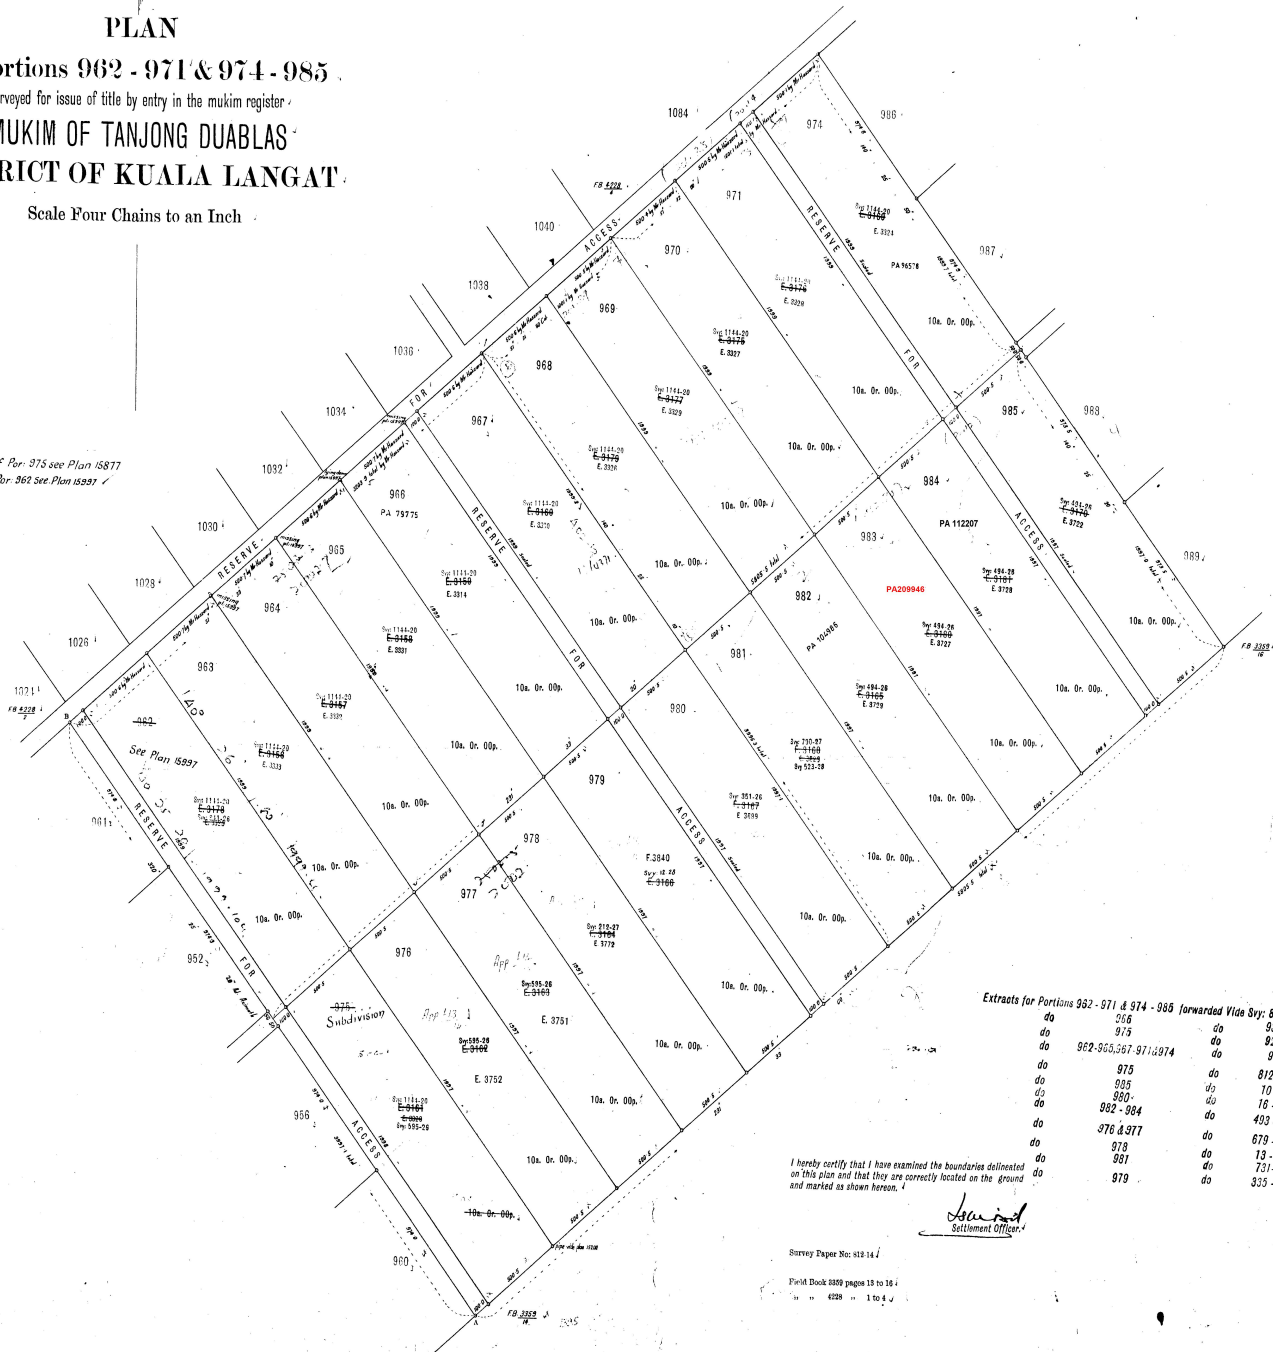

Extracts for Portions 962 - 971 & 974 - 985 forwarded Vide Svy: 812 - 14

do	266	do	933-20
do	975	do	933-20
do	962-965, 967-971, 974	do	934-20
do	975	do	812-14
do	985	do	10-26
do	980	do	16-26
do	982-984	do	403-26
do	376 & 377	do	679-26
do	978	do	13-27
do	981	do	731-27
do	979	do	335-26

I hereby certify that I have examined the boundaries delineated on this plan and that they are correctly located on the ground and marked as shown hereon.

Signature
 Settlement Officer

Survey Paper No: 412-14

Print Book 2859 pages 15 to 16

to 4228 1 to 4

Surveyed by: H. H. San

Examined by:

Signature
 District Survey

Plan No:

12642

Sheet No: A-116

Azimuths taken from A. B.
 Third Class Survey
 Drawn by *Signature*
 Examined by *Signature*
 Charted by *Signature* 30.10.19.
 Plan Approved *Signature* 15.11.19
 Calc. Book Vol. 91 p. 144