

Extracts for portions 894 to 896 forwarded Vide Svy: 1234-11
 2519 & 2520 " " 724-11
 895 " " 64-14
 do " 889 do 587-15
 do " 906 do 1153-16
 do " 890 & 891 do 1453-11
 do " 881 do 1914-18
 do " 898, 900 & 901 do 104-21
 do " 891 do 22-27
 do " 884 do 77-29
 do " 885 & 891 do 44-30

For subdivision of Port: 893 see F.B. 2382 p 6 vide Svy: 724-11
 For subdivision of Port: 882 see Plan 9984
 For sub-division of Port: 896 see Plan 15704

SUB-CIRCUIT 8 CIRCUIT 10 KLANG

Scale Four Chains to an Inch

880 906

Sy 256
89.
437
89

All bearings on this plan are on the Meridian of the Trig on Bkt. 334


For subdivision of Port: 886 see Plan 9678
 For subdivision of Port: 887 see plan 9094
 do 897 do 9683
 do 898 do 11424

Notes: Bearing of East Meridian line, S. 67° 31' E.

Date	Lat. (North)	Long. (East)	Obs. Azimuth	Calc. Azimuth	Calc. Azimuth	Calc. Azimuth	Calc. Azimuth	Calc. Azimuth	Calc. Azimuth
20 th April 1905	1° 53' 30"	101° 01' 00"	154° 49' 30"	154° 49' 30"	154° 49' 30"	154° 49' 30"	154° 49' 30"	154° 49' 30"	154° 49' 30"
	1° 53' 30"	101° 01' 00"	154° 49' 30"	154° 49' 30"	154° 49' 30"	154° 49' 30"	154° 49' 30"	154° 49' 30"	154° 49' 30"
	1° 53' 30"	101° 01' 00"	154° 49' 30"	154° 49' 30"	154° 49' 30"	154° 49' 30"	154° 49' 30"	154° 49' 30"	154° 49' 30"
Solar Observation for Azimuth

Sub-Cir: 9
Cir: 10

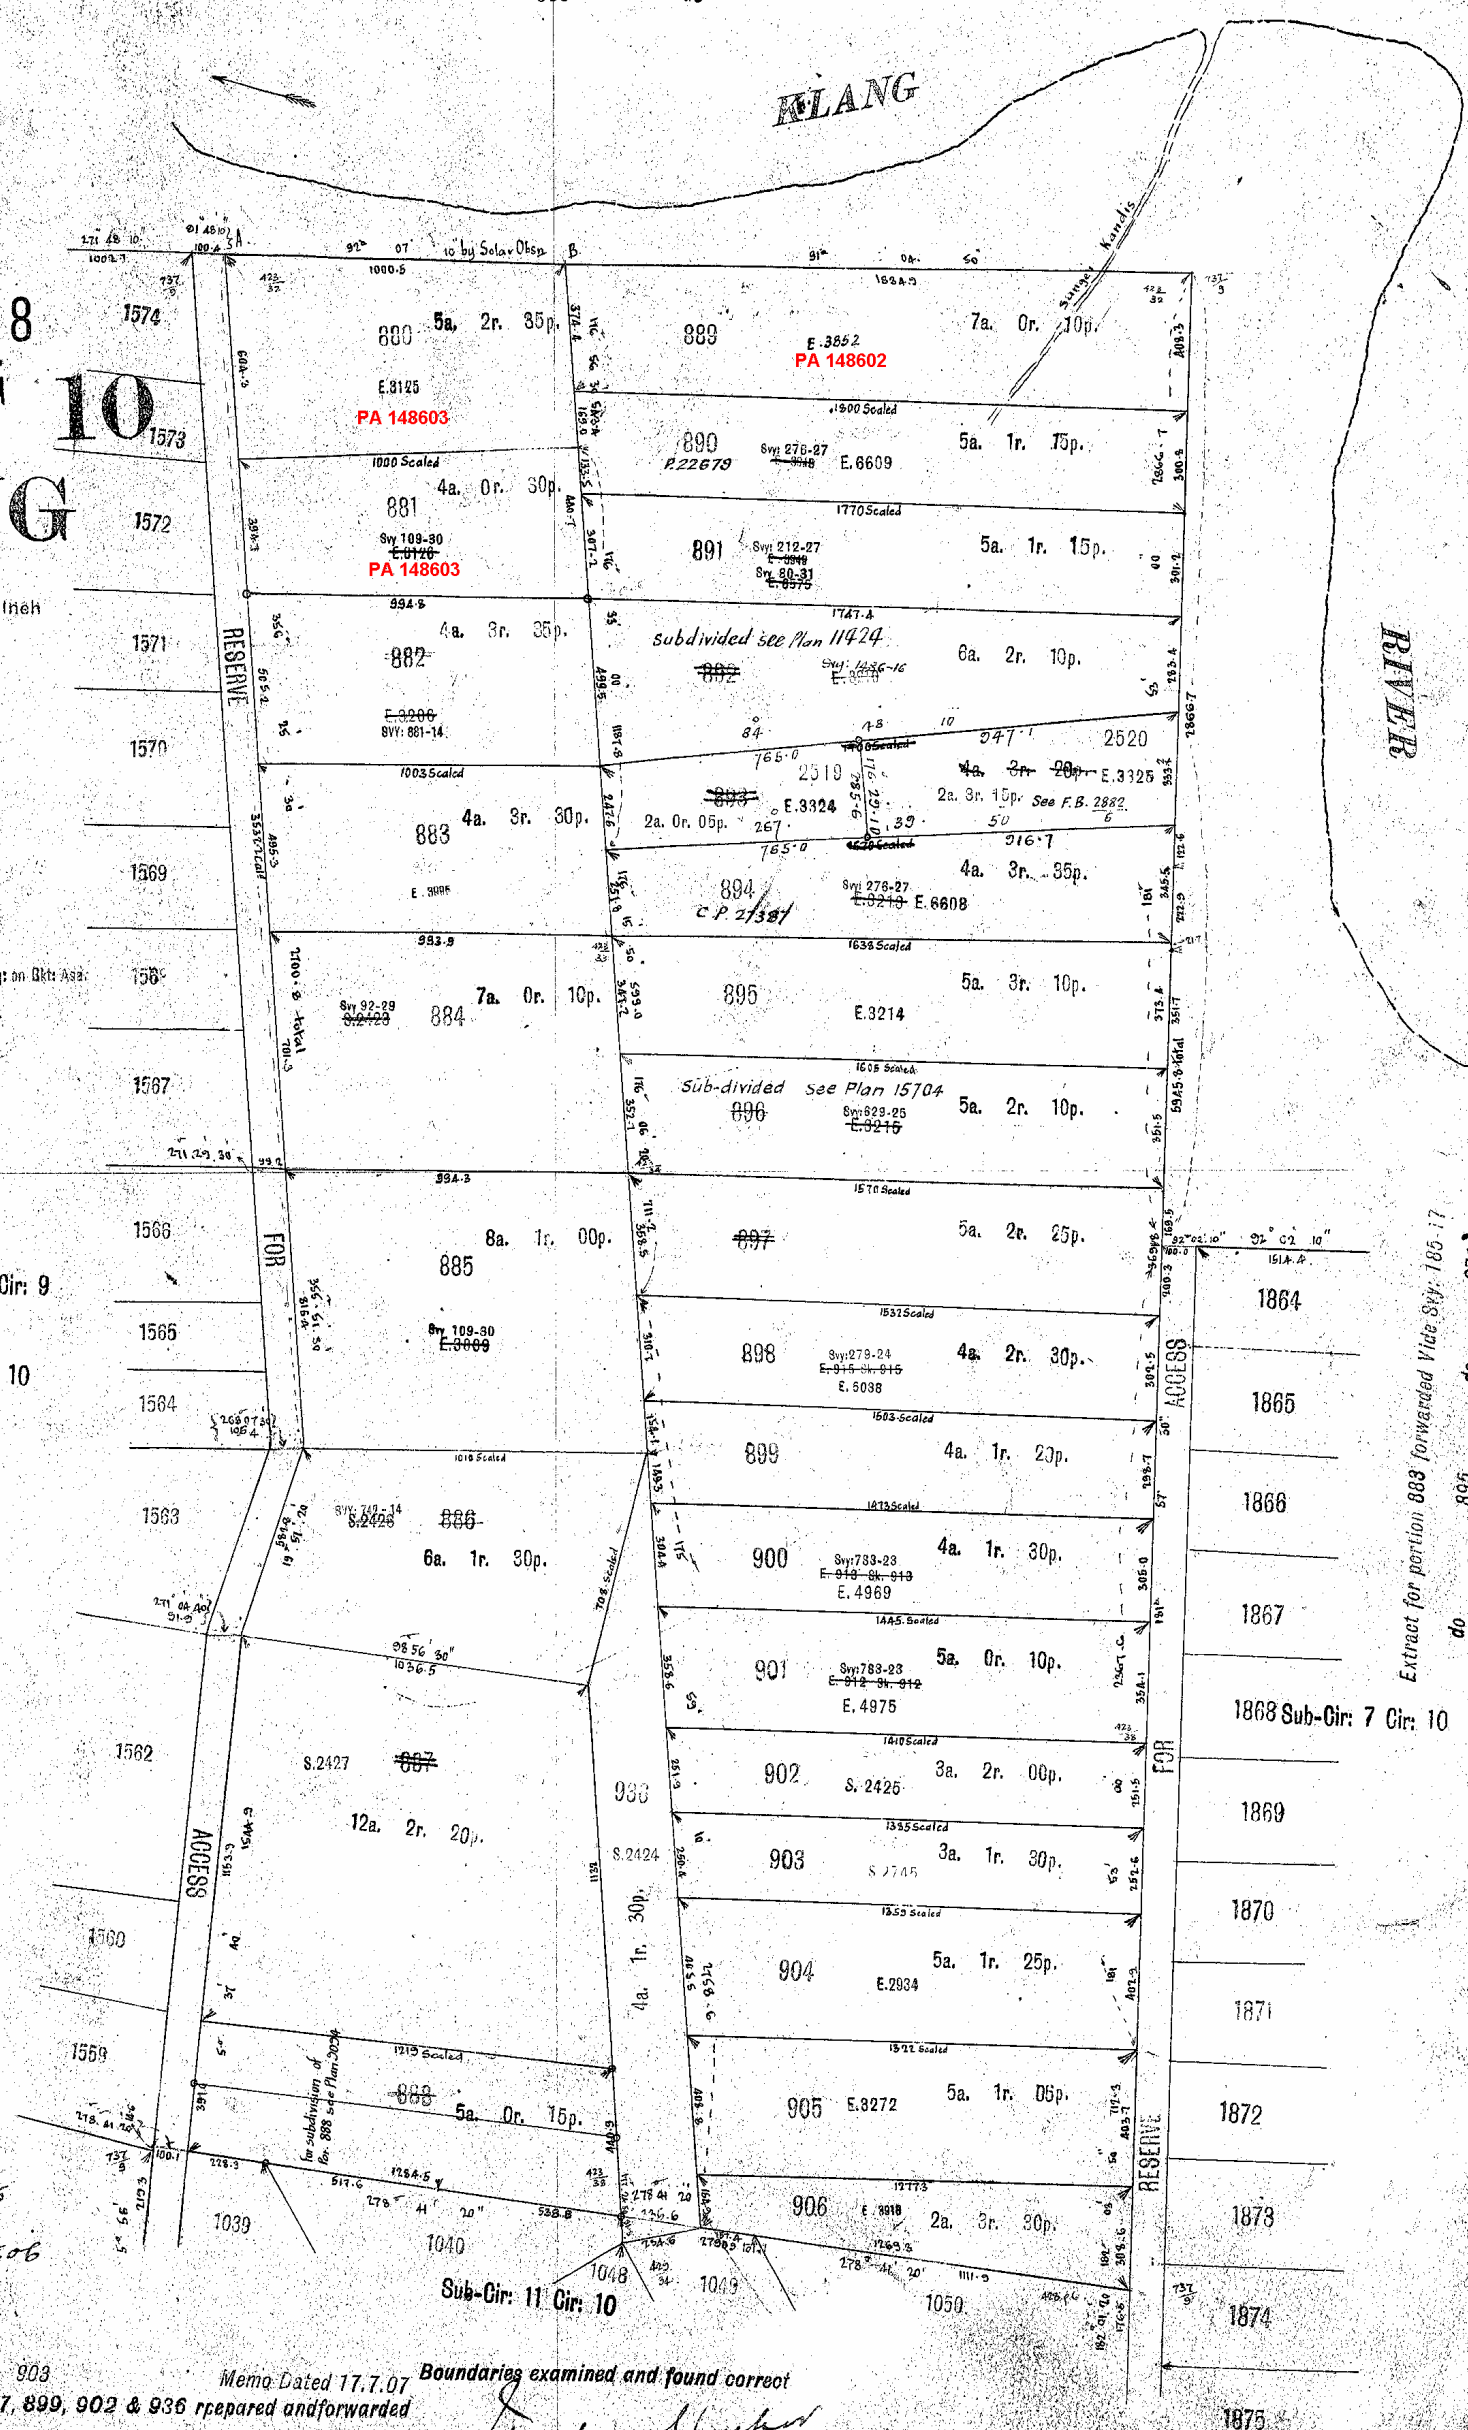

Extract for portion 883 forwarded Vide Svy: 185-17
 do do 271-18
 do do 888-26
 do do 890-894
 do do 428-29

Circuit surveyed by
 Drawn by *Wales*
 Checked by *W. Chan* 9.10.05
 Charted by *W. Chan* 16.5.06
 Plan Approved *W. Chan* 8.1.06

Extracts for portions 884, 886, 897, 899, 902 & 936 prepared and forwarded
 Memo Dated 17.7.07
 Boundaries examined and found correct
 Vide Svy: 437-05

Extract for portion 904 prepared and forwarded Vide Svy: 842-09

Extracts for portions 880 & 881
 Extract for portion 892
 " " 882
 " " 885

Gal. Book Vol: 7 p 202

Settlement Officer 14.2.06
 Gal. Book Vol: 25 pp 82-84 & 93, 52 & 55

W. Chan
District Surveyor