

SCALE 1:600
STANDARD SHEET : 66 - C - III



TBM H2




1



2

2 & 3

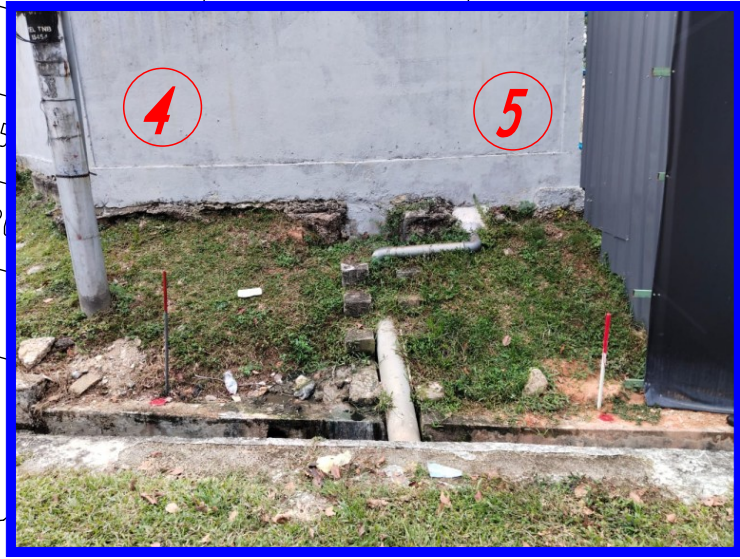

4

5



TBM H3



6



15



16



17




10



12



13

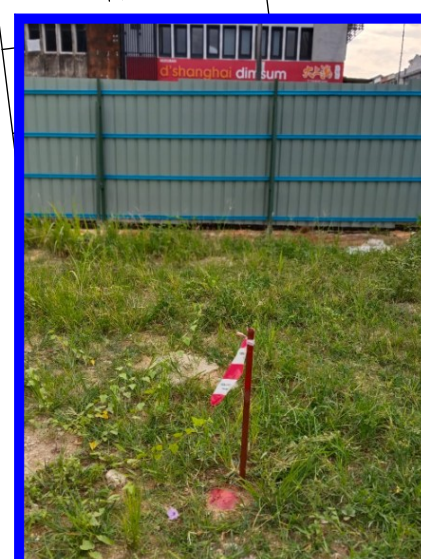

14



8



7

16996
SITE

LOCATION PLAN
NOT TO SCALE

TITLE
DEMARICATION SURVEY
ON LOT PTD 255588 & PT 255589
(OLD LOT 16996),
TAMAN PELANGI ,
MUKIM OF PLENTONG ,
DISTRICT OF JOHOR BAHRU ,
JOHOR DARUL TAKZIM

NOTE:
ALL LEVELS ARE BASED ON BM 10526 (R.L.=5.395m). DI KANAN JALAN
ULU TIRAM - JOHOR BAHRU. BERADA 20m SELEPAS SMPANG MASUK KE
TAMAN ISTIMEWA DAN BERHADAPAN DENGAN BANGUNAN HARTA DAN
REALTY BOO LEONG. OBSERVED FROM GPS 1 GEOD MODEL WEGOOD 04 I.

LEGEND:
OCM - OLD CONCRETE MARK
OP - OLD PIPE
NP - NEW PIPE
NNL - NEW NAIL
ONL - OLD NAIL

FIELD BOOK NO. F01955

SURVEYED BY : CHING

COMPUTED BY : FRZ

DRAWN BY : FRZ 15/08/2025

CHECKED BY : H.K.P



LSr H'NG KIM POR B.Sur. (Hons.) (Land) MIS (M)
Land Surveyor Licensed Under Act 458 (Revised 2024)

JURUKUR MURNI
LICENSED LAND SURVEYOR
NO. 35A, JALAN 16/155C,
BUKIT JALIL,
57000 Kuala Lumpur, Malaysia
TEL : 03-89940029/69 FAX : 03-89940039
EMAIL : jnmurni@gmail.com

PLAN NO. : JM/E/24/JOH/024/C

DIGITAL FILE : JMJOH024C