

Browser tabs: Laman Utama, JUPEM2U, Google

Address bar: jupem2u.nsn.jupem.gov.my/j2u_mp/jupem2u.html?SessionId=clL0kz7PUQbwbvIVJ7d5

Bookmarks: Google, Gmail - Inbox - pan..., Google Maps, Google Translate, Log Masuk | eBiz JU..., SmartKADASTER 2D

Maklumat

Lokasi (x, y): (1124.026712, -33.258822)
WGS84 (lat, lon): (2.711820, 101.949811)

- > Indexmap
- > Mukim
- > Daerah
- > Fail Ukur
- > Fail Ukur(1)
- > Fail Ukur(2)
- > Laam Block
- > Fail Ukur(3)
- > Fail Ukur(4)
- > Fail Ukur(5)
- ▼ NDCDB Lot

No. Lot	8610
UPI	0505400008610
Keluasan	778.096
Keluasan PA	0
Unit Keluasan PA	
Tujuan Ukur	
Kegunaan Tanah	2 - PERUMAHAN/KEDIAMAN


Center: (x=1086.491389, y=-40.009441) Zoom: 18
Peta asas adalah sebagai rujukan sahaja.

PA 19040
PA 19025
PA 1221

PA 8426

PA 8610
Town of Seremban
Bukit Jambak

PA 86-A

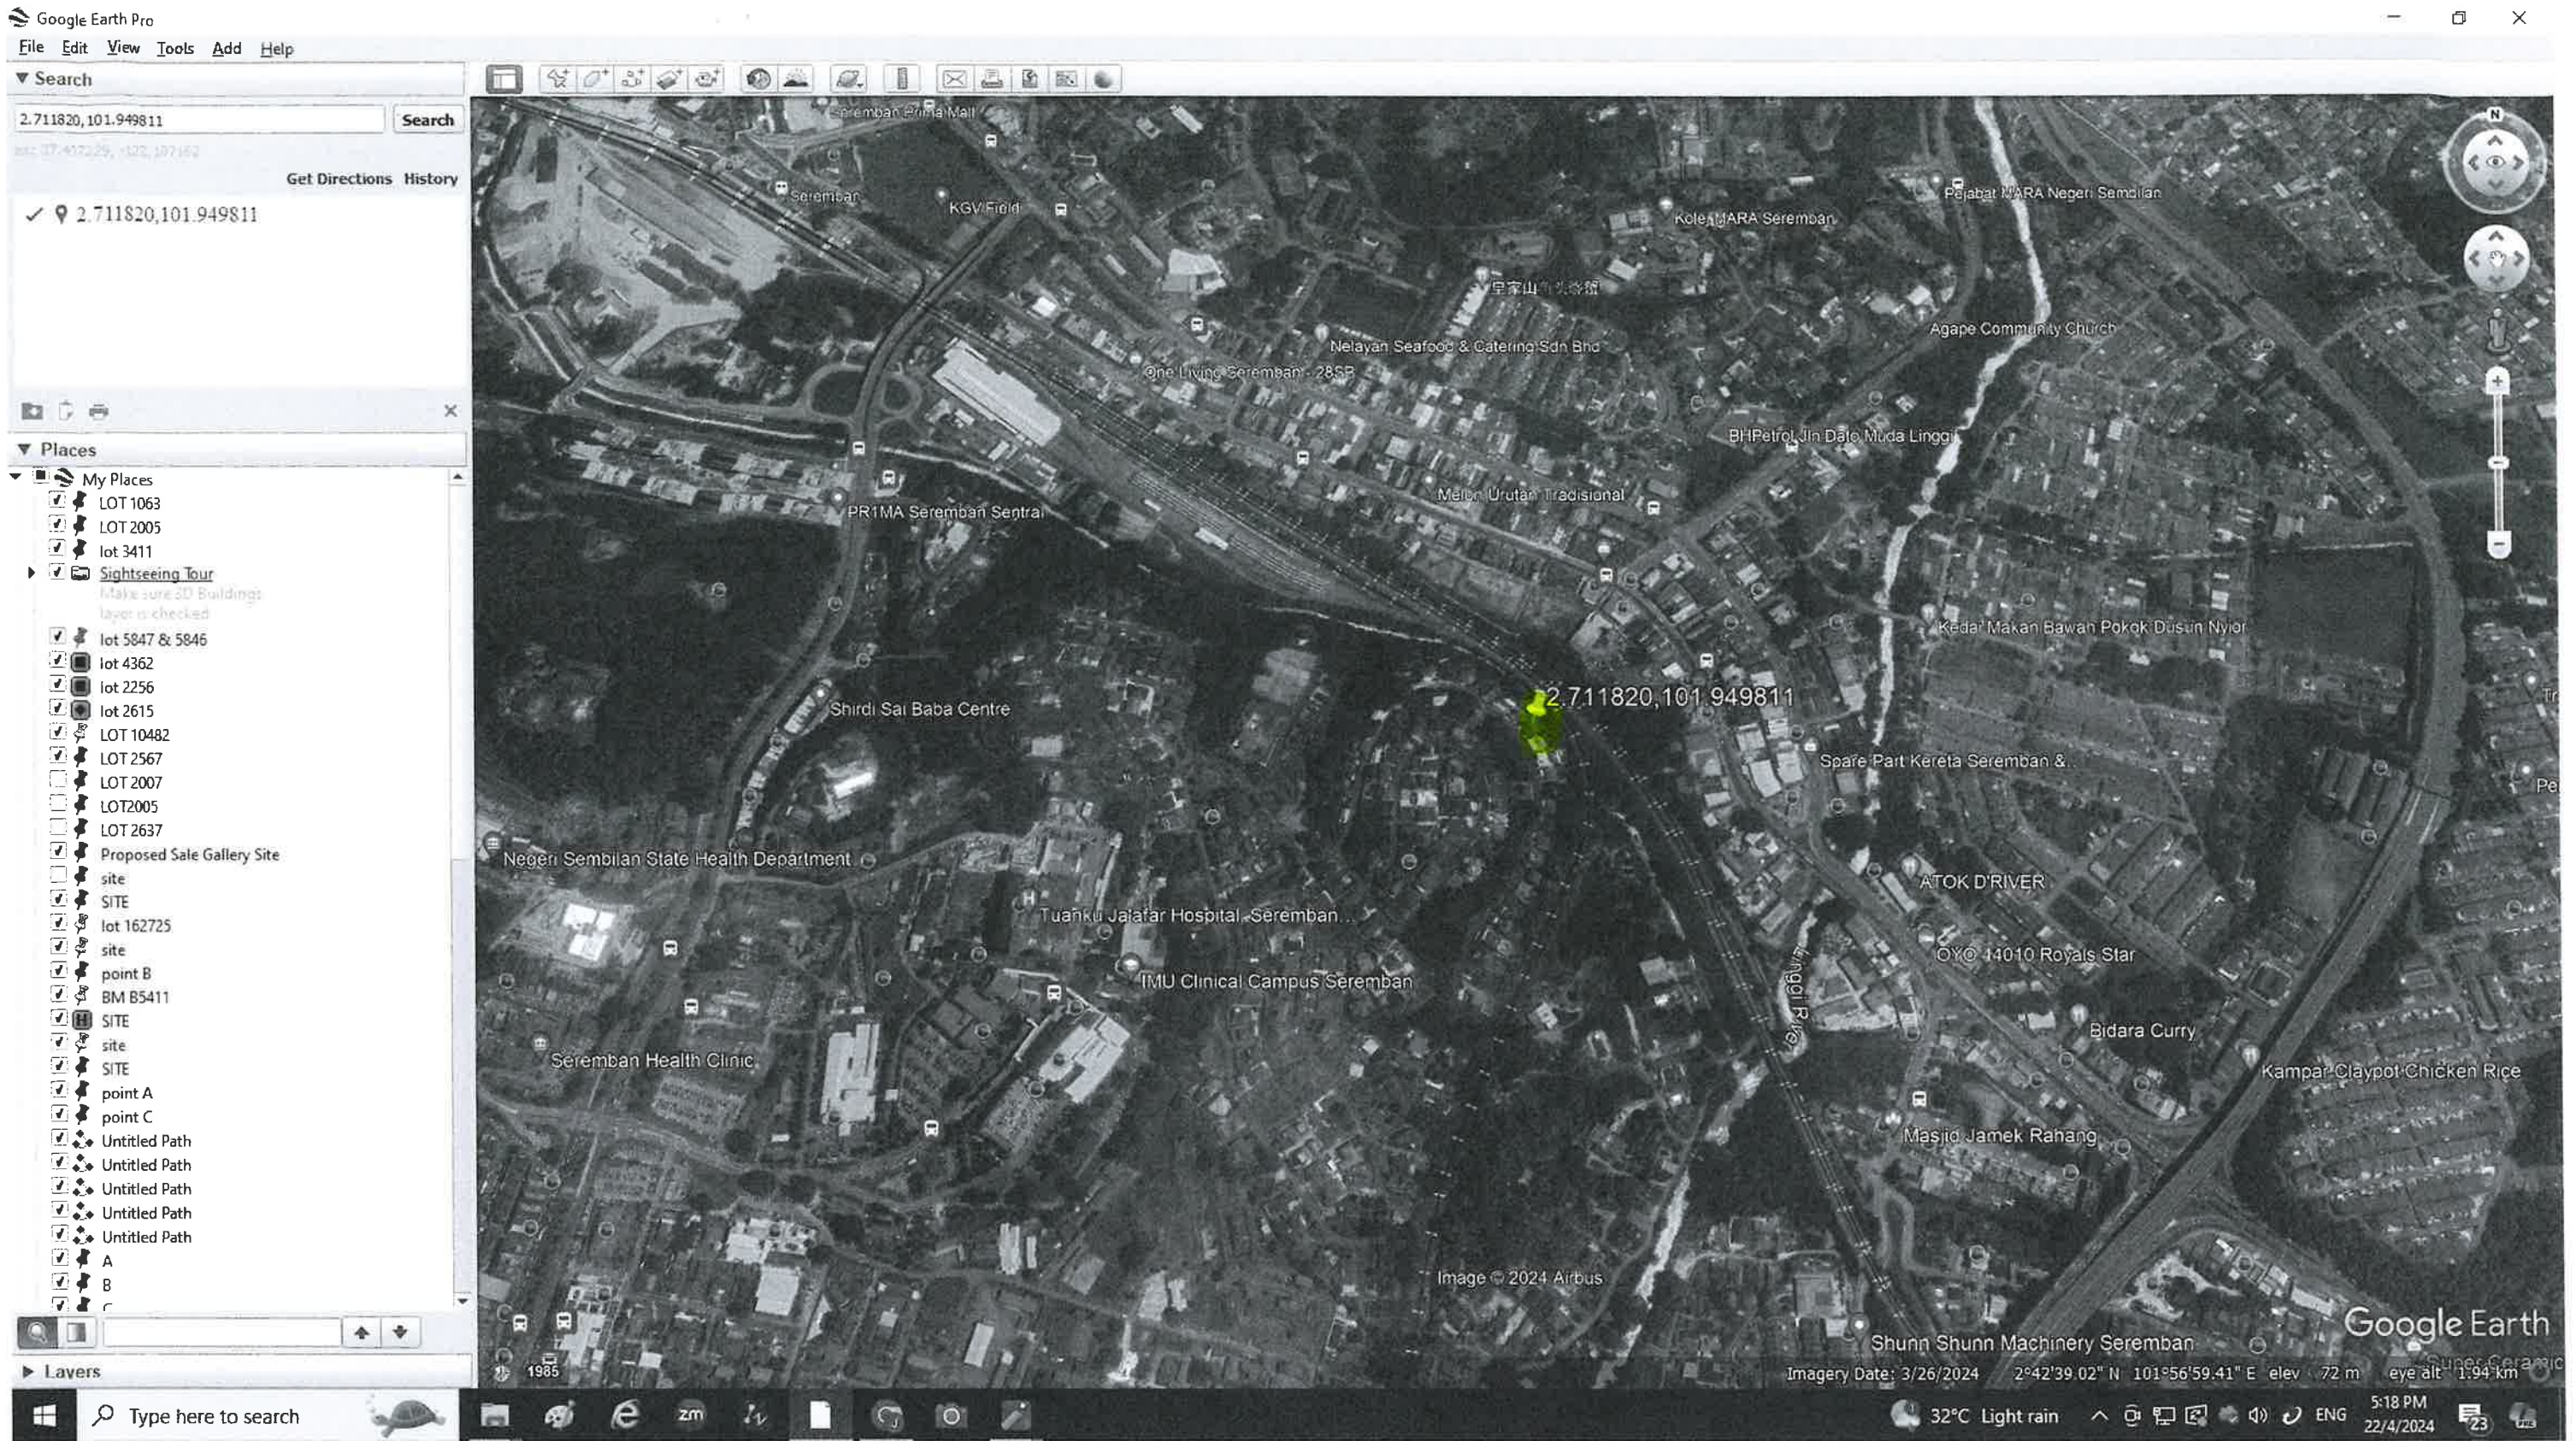

LOT 8509-8522, 8608-8665 & 8667-8677

SEBAHAGIAN
ADALAH PECAHAN LOT 8502 (P.A. 18861)

BANDAR SEREMBAN

DAERAH SEREMBAN


SEKIL SATU RANTAI SEINCI

NOTA
SEMUA JARAK DALAM UKURAN METER

6-A-1-5
6-A-1-9

LIHAT P.A. 19039

8596

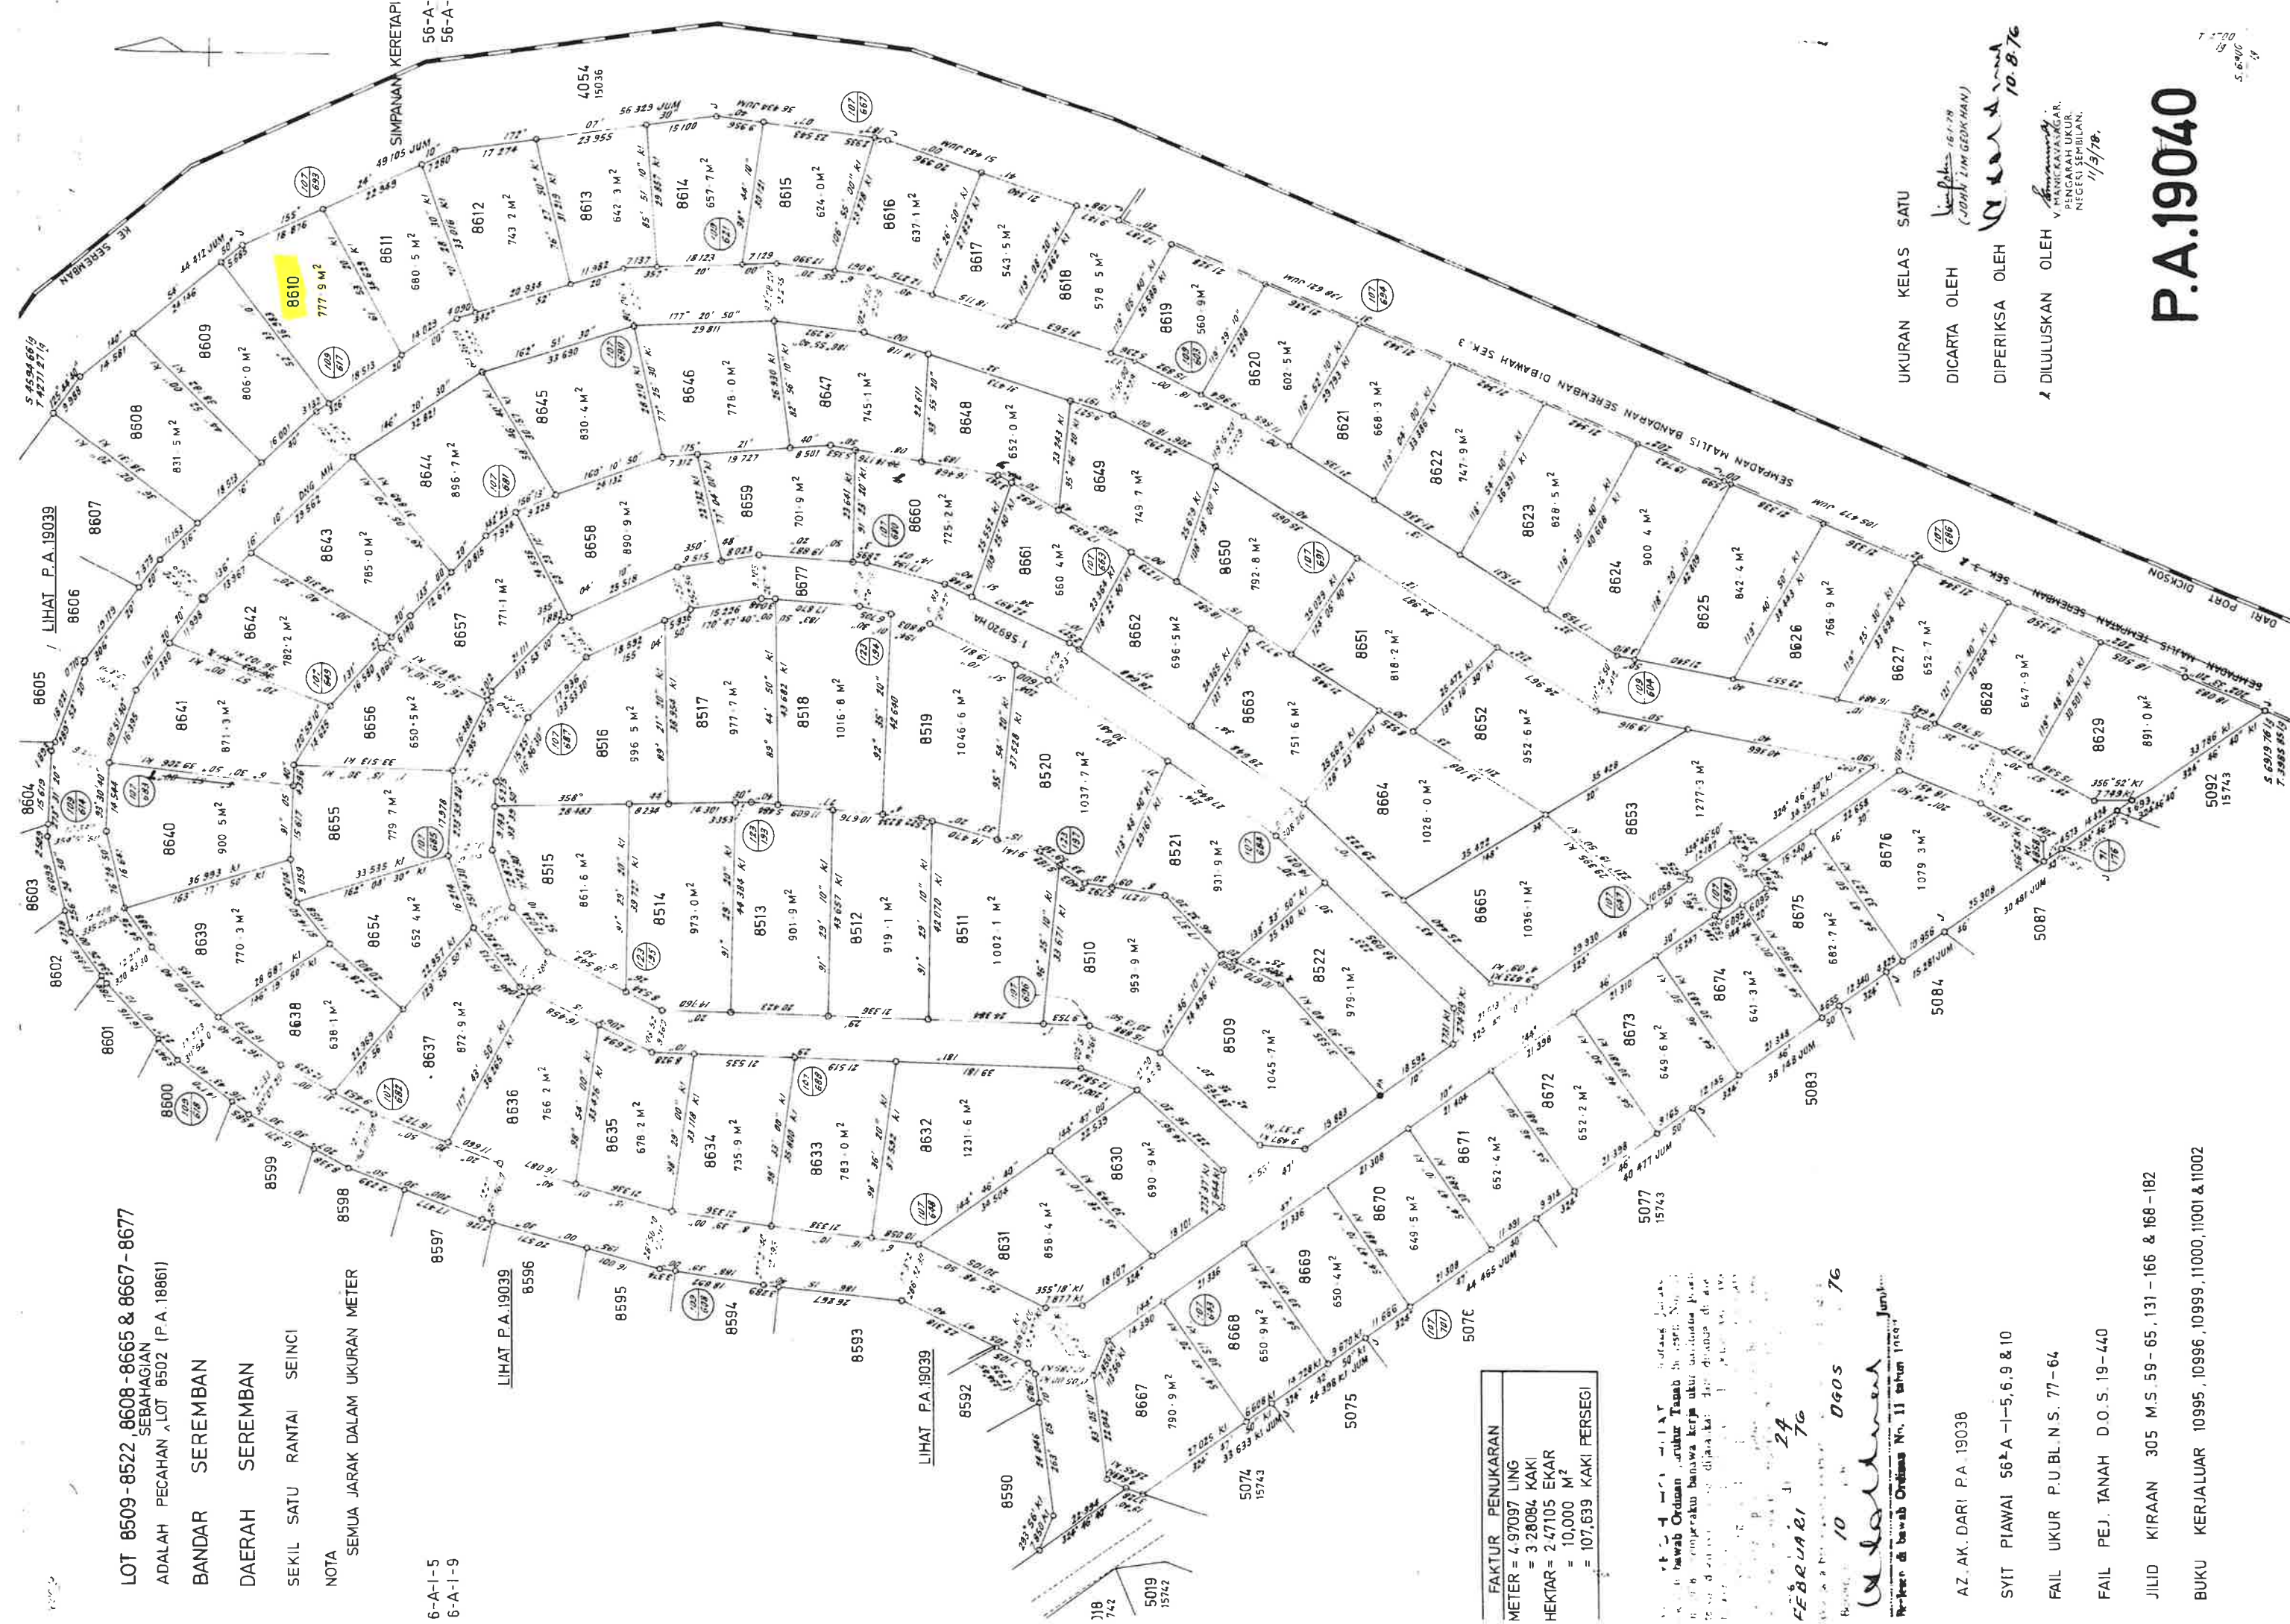

FAKTUR PENUKARAN	
METER = 4,97097 LING	
= 3,28084 KAKI	
HEKTAR = 2,47105 EKAR	
= 10,000 M²	
= 107,639 KAKI PERSEGI	

FAKTUR PENUKARAN
METER = 4,97097 LING
= 3,28084 KAKI
HEKTAR = 2,47105 EKAR
= 10,000 M²
= 107,639 KAKI PERSEGI

FEBRUARI 24 76

10 0605 76

10 0605 76

AZ. AK. DARI P.A. 19038

SYIT PIAWAI 56-A-1-5, 6, 9 & 10

FAIL UKUR PUBL.N.S. 77-64

FAIL PEJ. TANAH D.O.S. 19-440

JILID KIRAAN 305 M.S. 59-65, 131-166 & 168-182

BUKU KERJALUAR 10995, 10996, 10999, 11000, 11001 & 11002

UKURAN KELAS SATU

DICARTA OLEH


DIPERIKSA OLEH

2 DILULUSKAN OLEH

MANIKAVANAR,
PENCARAH UKUR,
NEGERI SEMBILAN,
11/3/78.

P.A.19040

6.4200
S. 4200

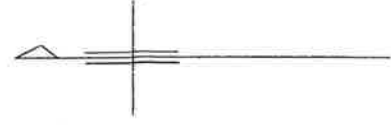


LOTS 3951 - 3974

being subdivision of Lot 3975 (See Inset)

TOWN OF SEREMBAN DISTRICT OF SEREMBAN

Scale One Chain to an Inch

Nota :
Lot 12821 Rizab kawasan lapang
menurut Wk 305-2009

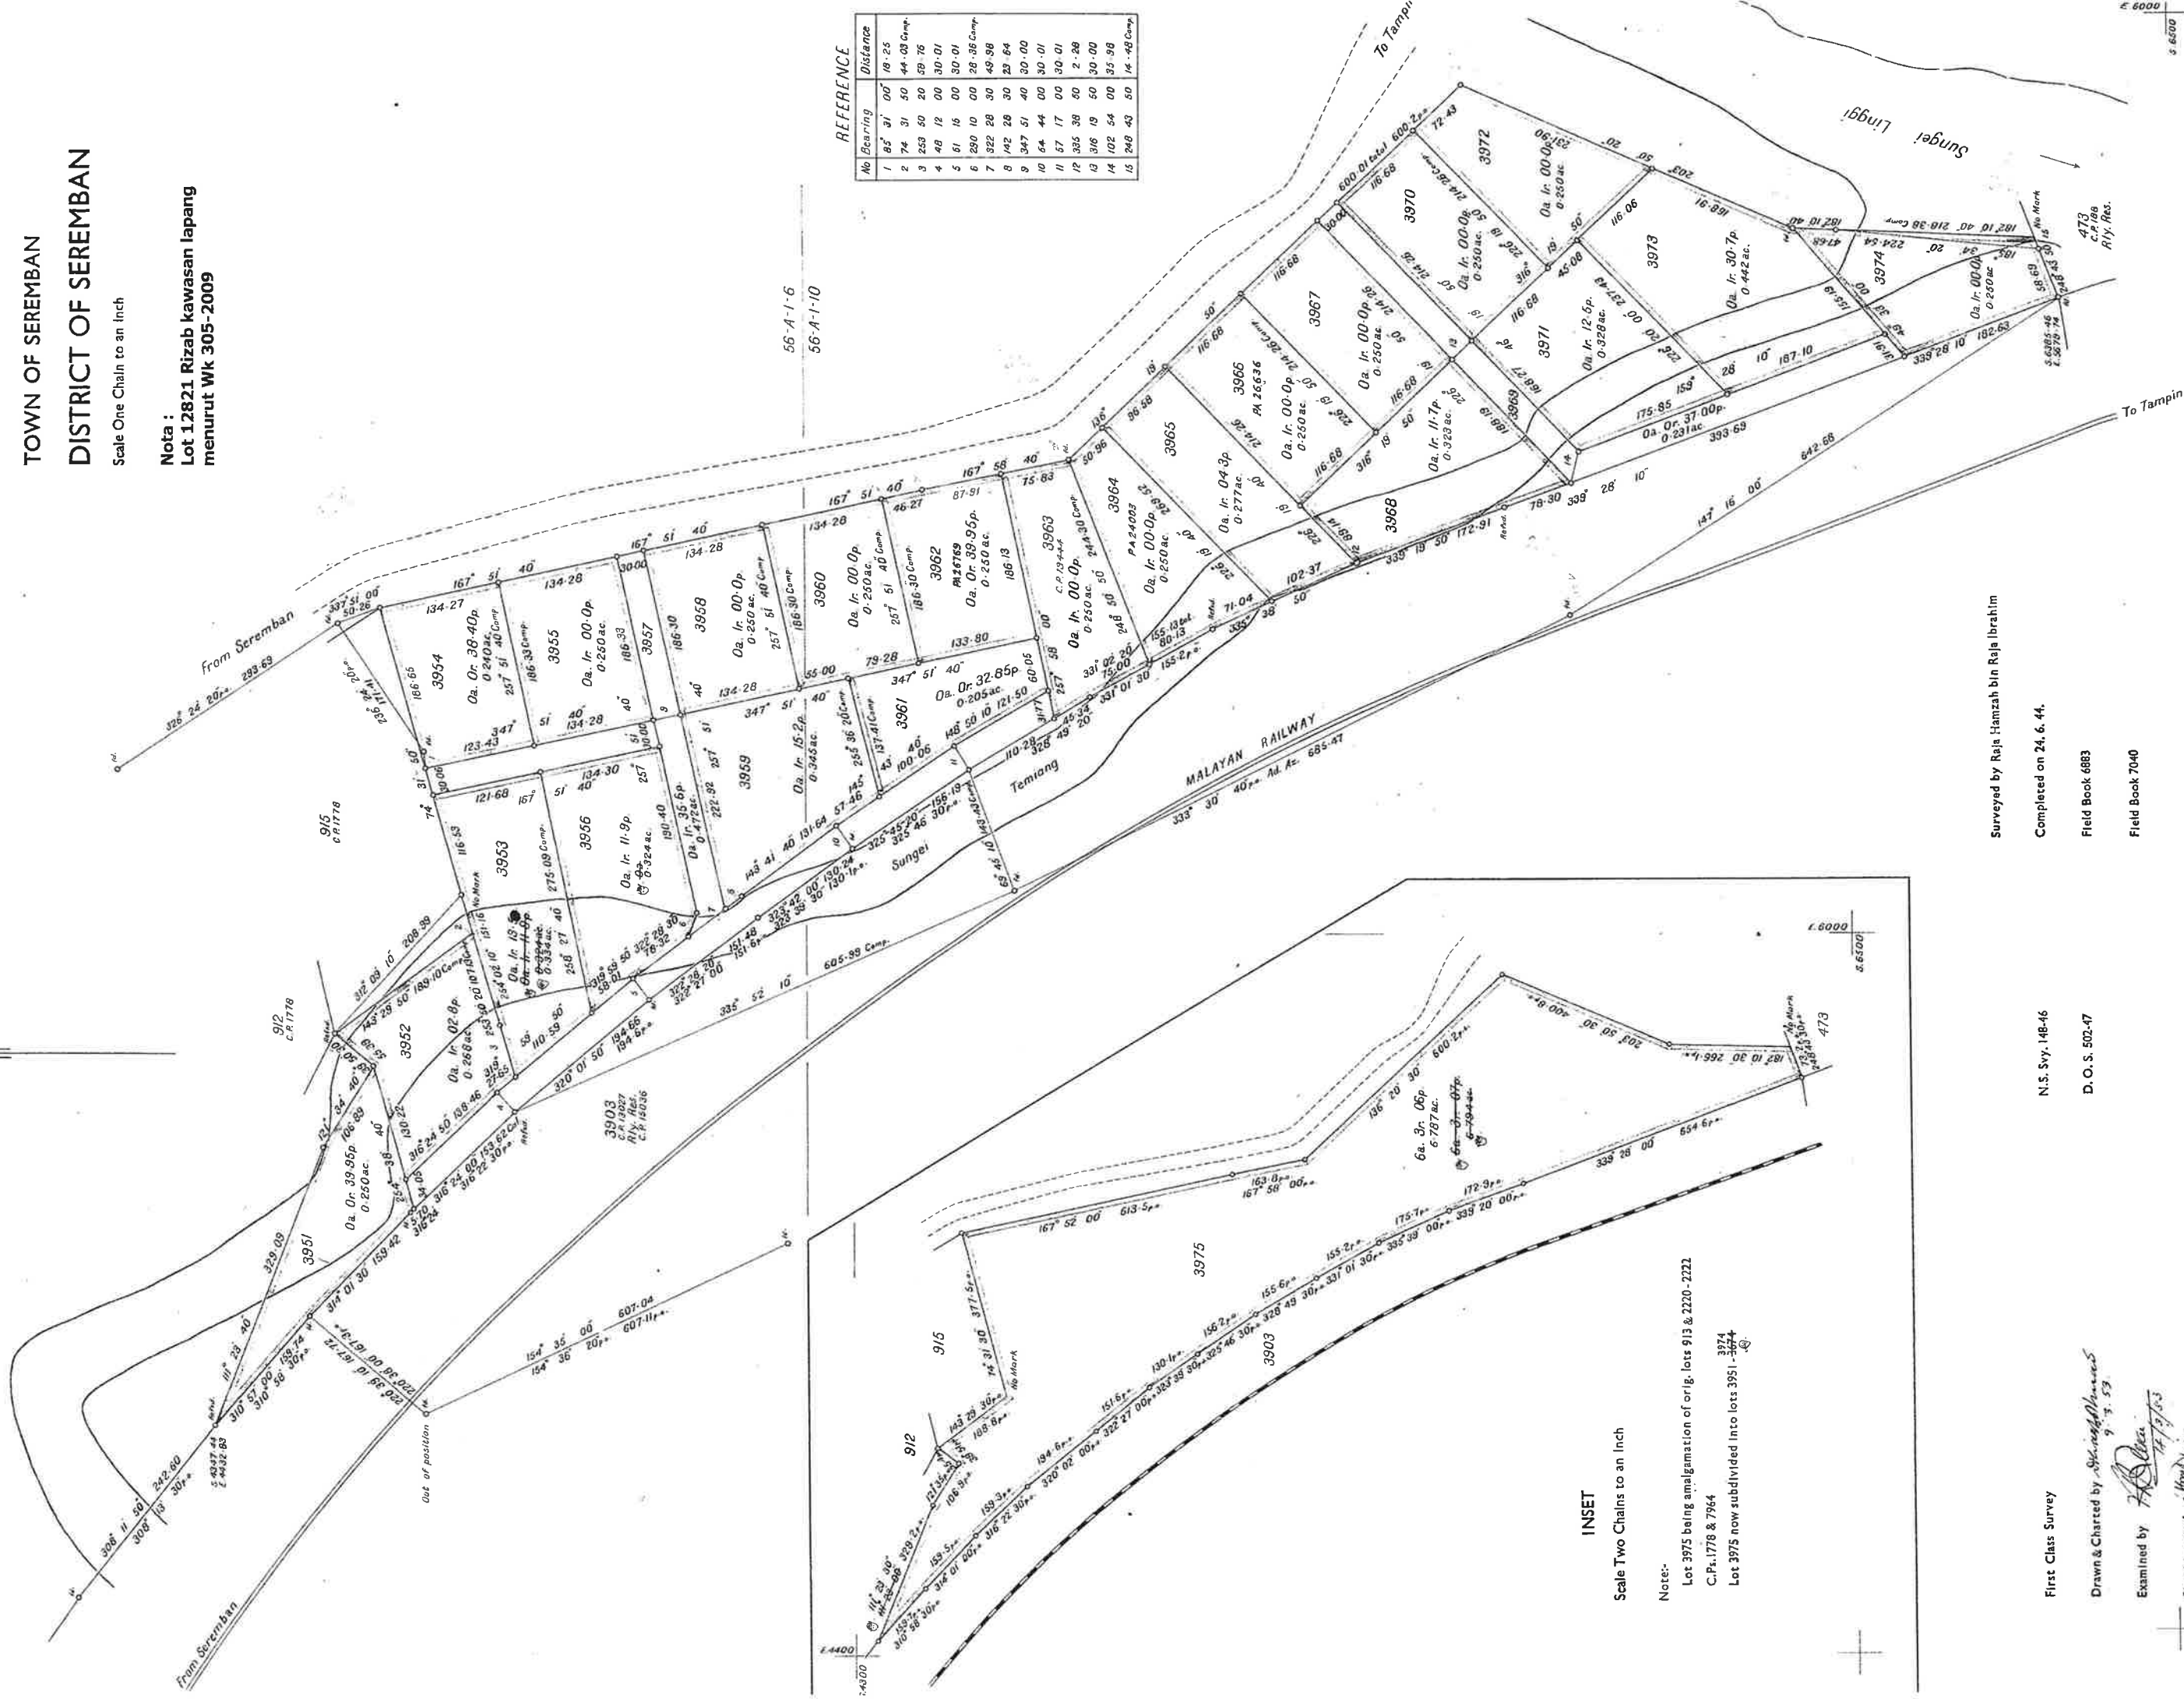

No	Bearing	Distance
1	85° 31' 00"	18.25
2	74° 31' 50"	44.08 Comp.
3	253° 50' 20"	59.76
4	48° 12' 00"	30.01
5	61° 16' 00"	28.36 Comp.
6	290° 10' 00"	28.36 Comp.
7	322° 28' 30"	49.98
8	142° 28' 30"	23.64
9	347° 51' 40"	30.00
10	64° 44' 00"	30.01
11	57° 17' 00"	30.01
12	335° 38' 50"	2.28
13	316° 19' 50"	30.00
14	102° 54' 00"	35.98
15	248° 43' 50"	14.48 Comp.

REFERENCE

INSET

Scale Two Chains to an Inch

Notes:-
Lot 3975 being amalgamation of orig. lots 913 & 2220 - 2222
C.Ps. 1778 & 7964
Lot 3975 now subdivided into lots 3951 - 3974

First Class Survey

Drawn & Charted by *Shahzad Khan*

Examined by *H. D. Khan*

Plan Approved *Shahzad Khan*

Cal. Vol. 206 pp. 73 - 86

Surveyed by Raja Hamzah bin Raja Ibrahim

Completed on 24. 6. 44.

Field Book 6883

Field Book 7040

N.S. Svy. 148-46

D. O. S. 502-47

Sheet Nos. 56-A-I-6 & 10

C.P. 12821




PLAN

of Allotments 2317 to 2319
Subdivision of Allotment 2243 (Plan 6646)

SEREMBAN TOWN

DISTRICT OF SEREMBAN

Scale Four Chains to an Inch

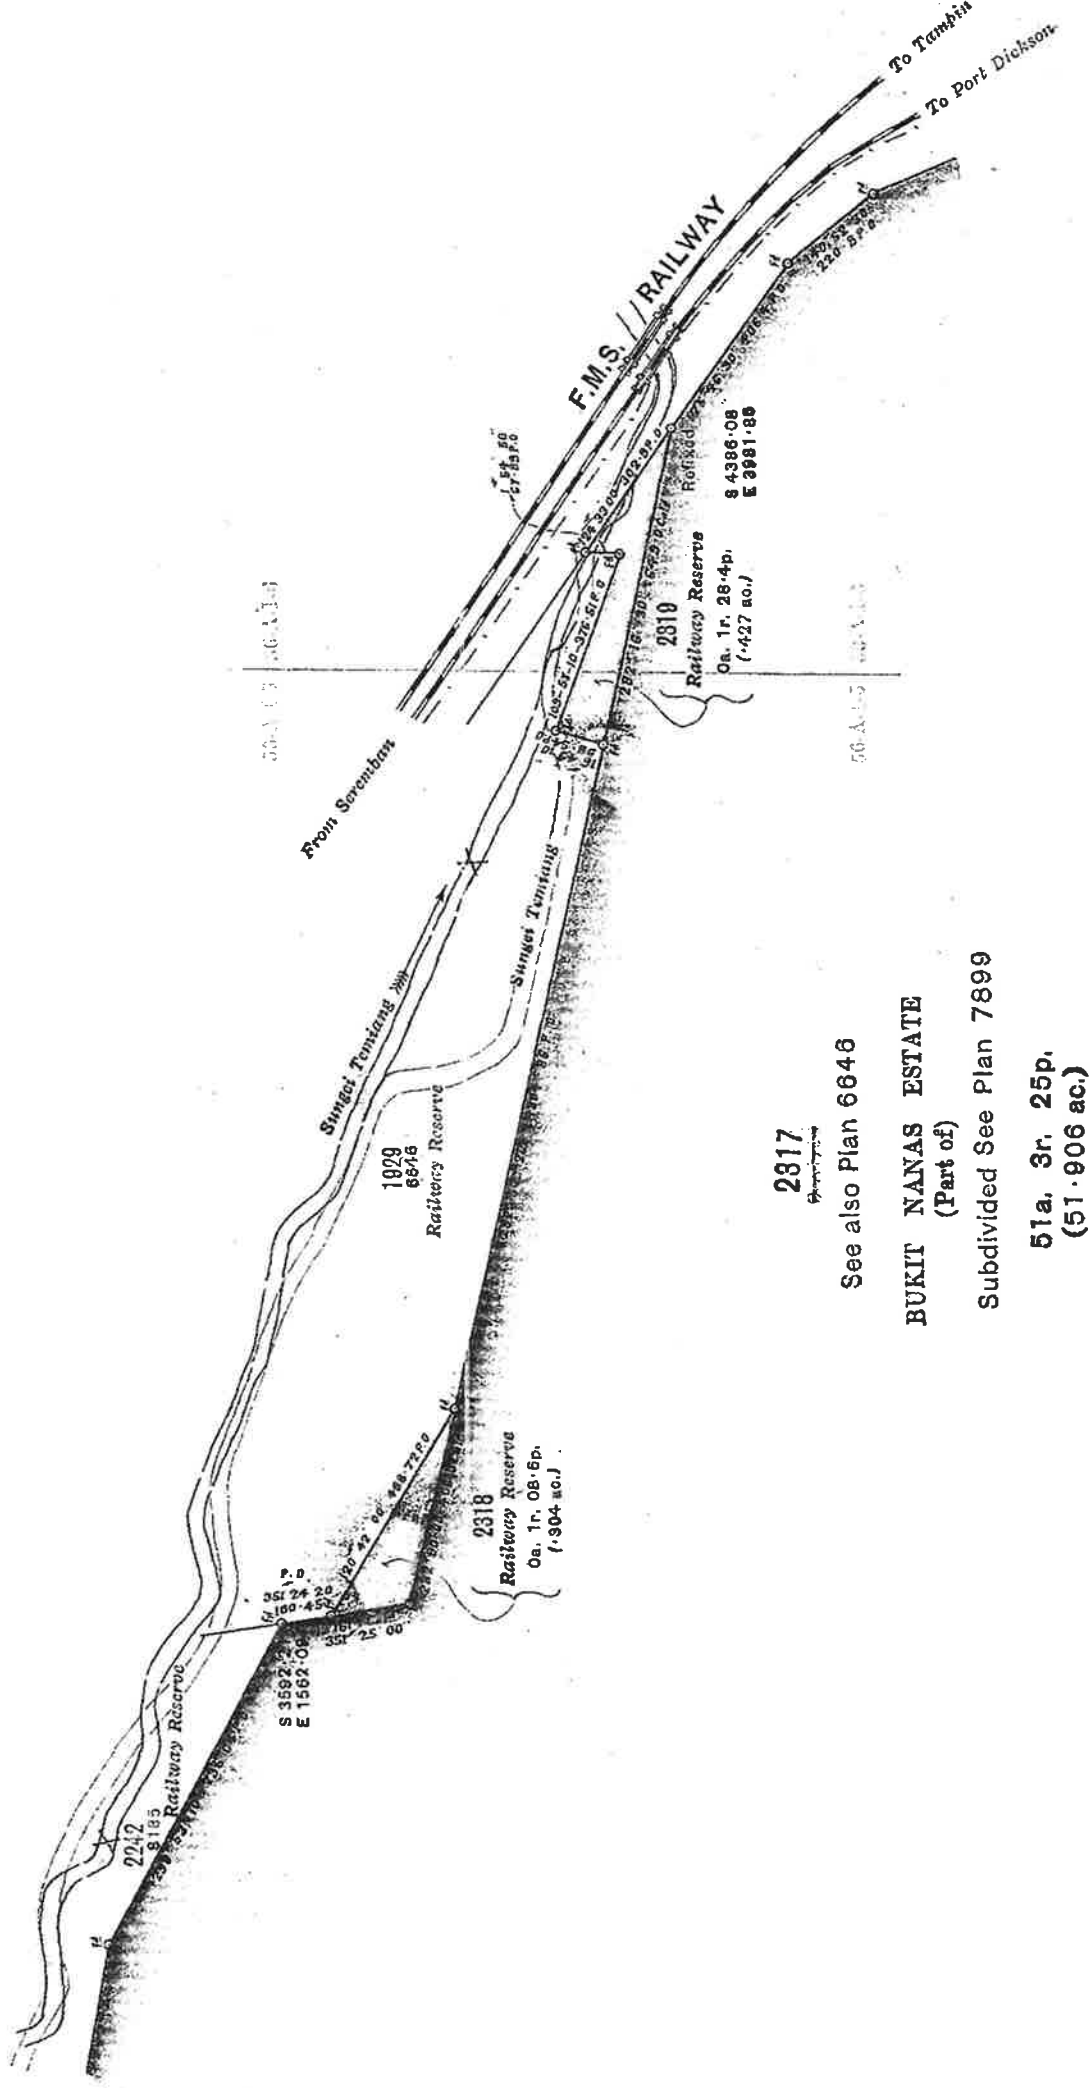

Azimuth taken from Plan 6643

First Class Survey

Drawn by *Abdullah* 23/7/22

Examined by *[Signature]* 23/7/22

Charted by *[Signature]* 23/7/22

Plan approved *[Signature]* 23/7/22

Cal. Book Vol. 104 p. 128

Survey Paper No. 162-23

Field Book 4444 pages 1 to 7

Sheet No. 56-A-1-5 & 6

Plan No. 8426

Certified that this plan correctly represents a survey completed **23.4.22** by me personally, in accordance with the regulations of the Survey Department of the Federated Malay States, and that the Boundary Marks have been properly placed and numbered under my supervision.

[Signature]
Surveyor