


Appendix " Block Paving "

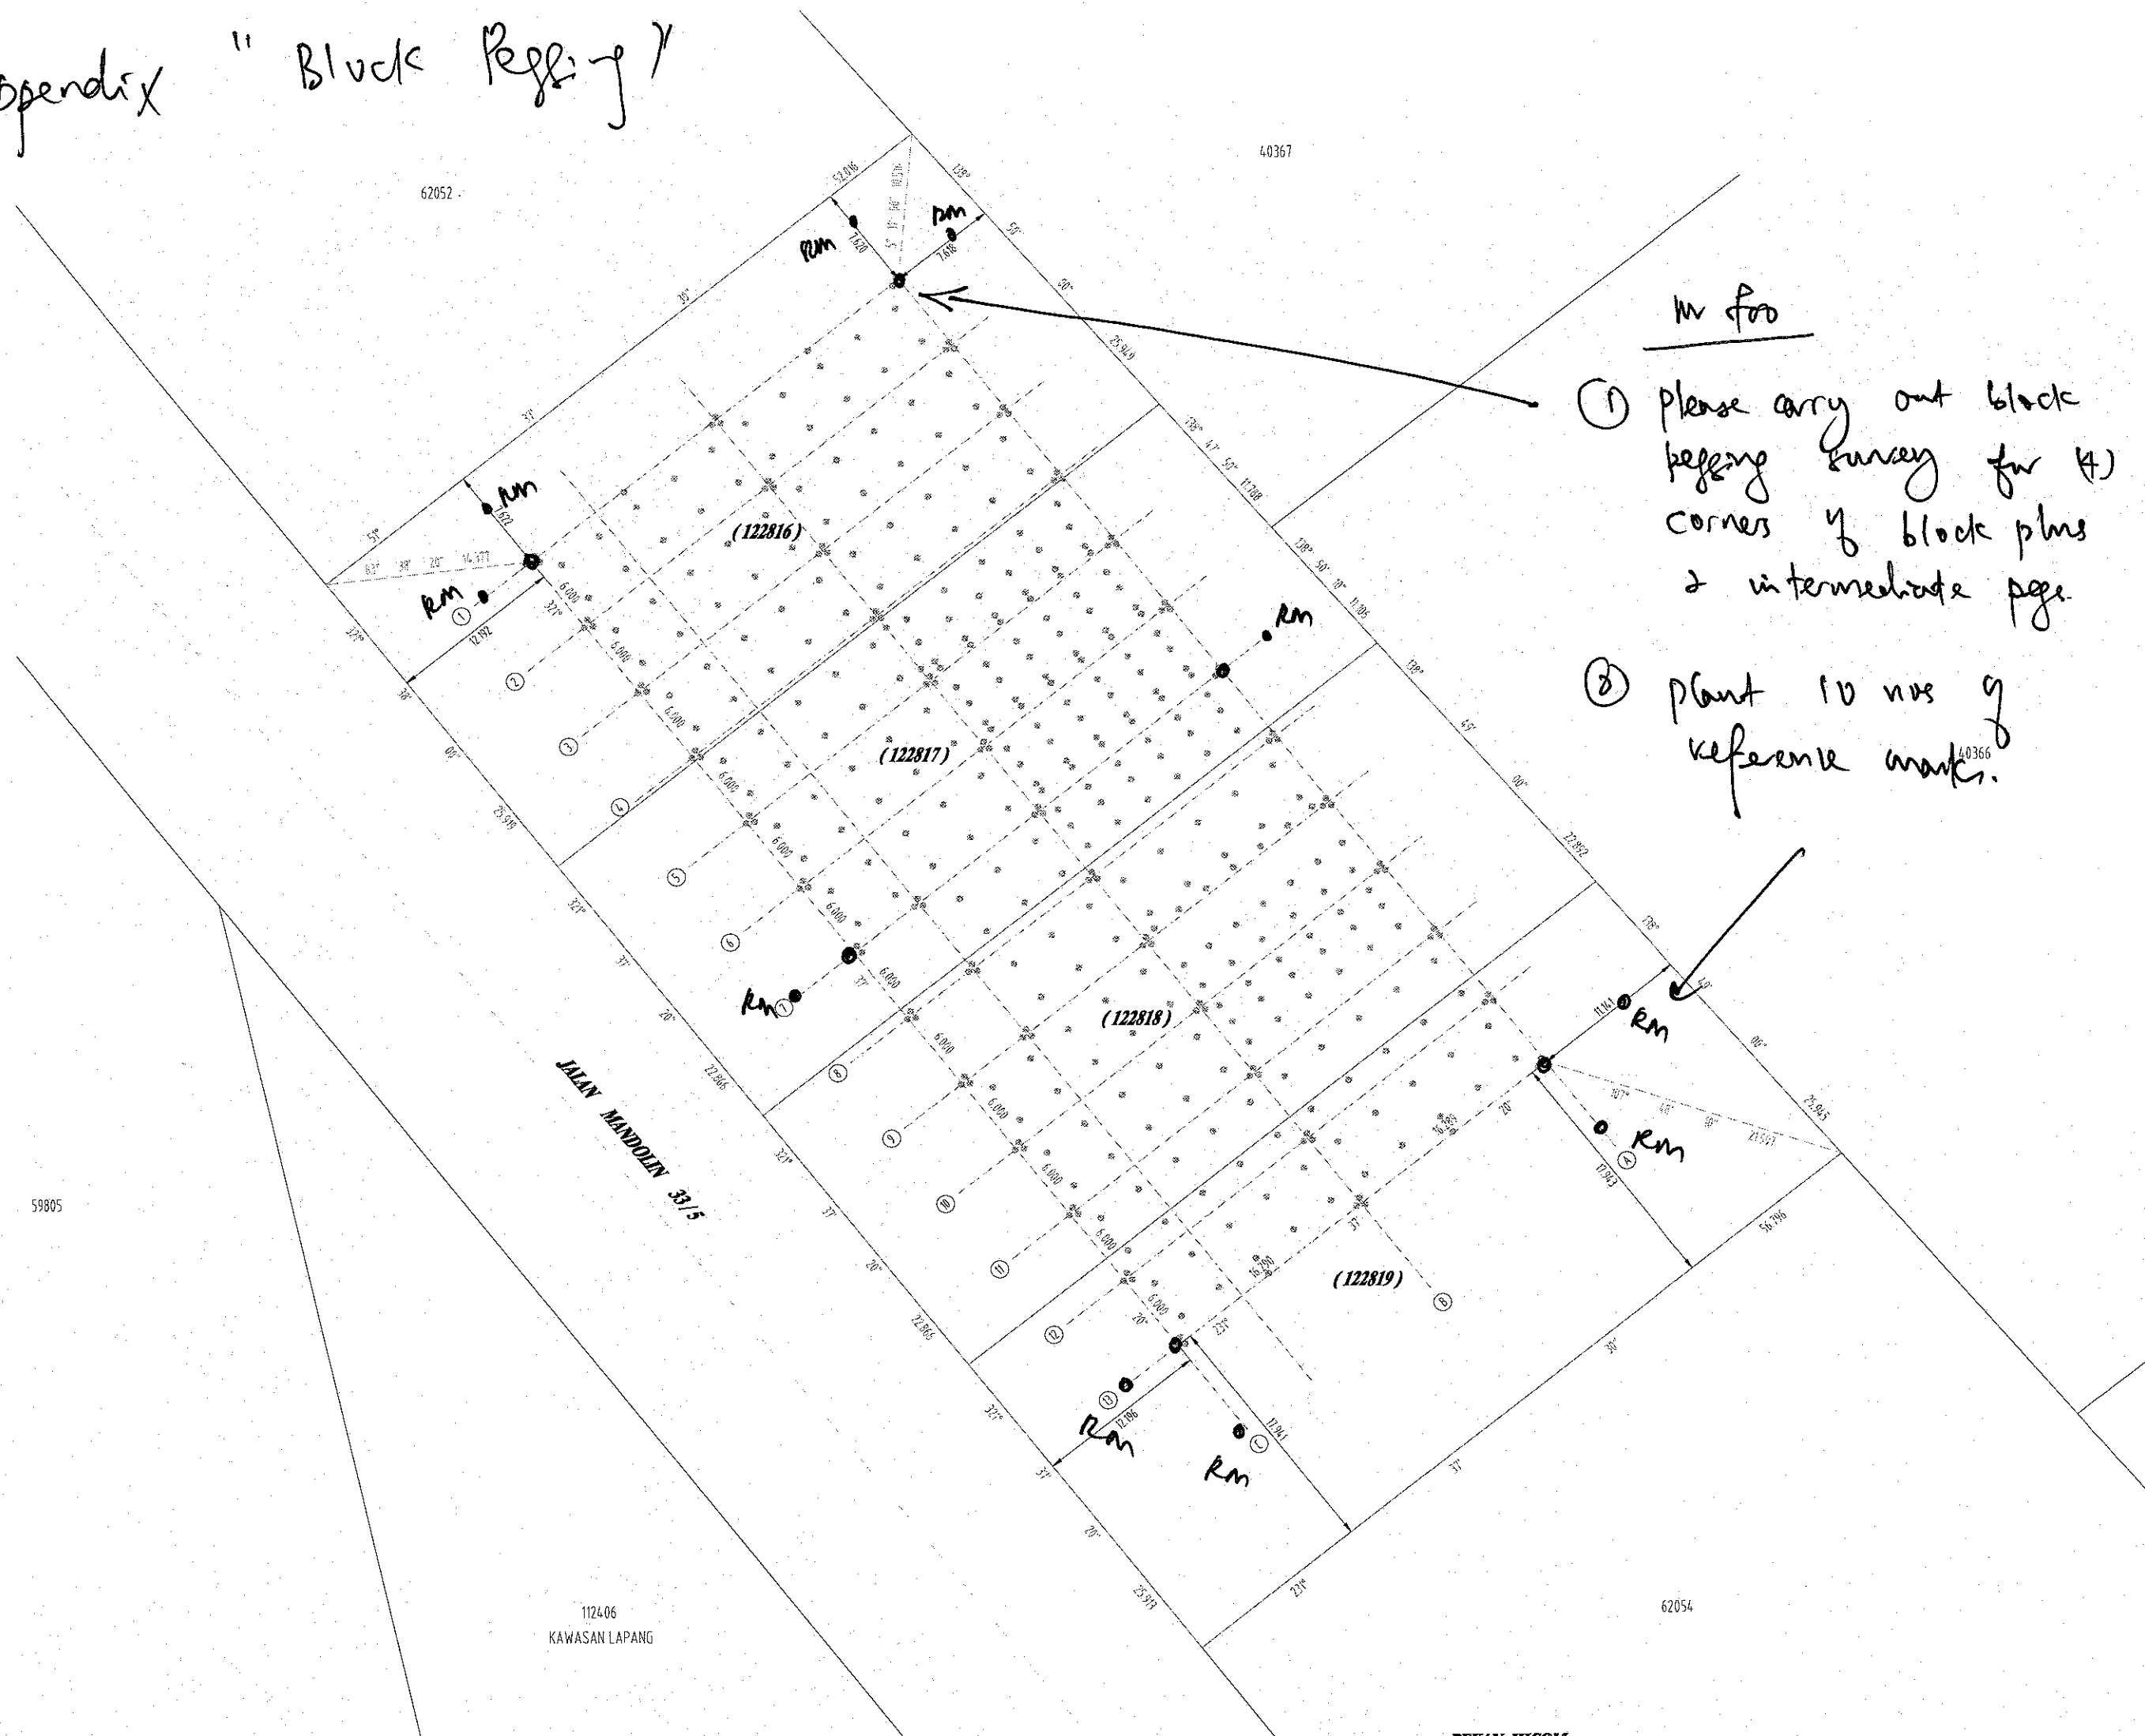

- m for
- ① Please carry out block paving survey for (4) corners of block plus 2 intermediate pgs.
 - ② plant 10 nos of reference marks.