


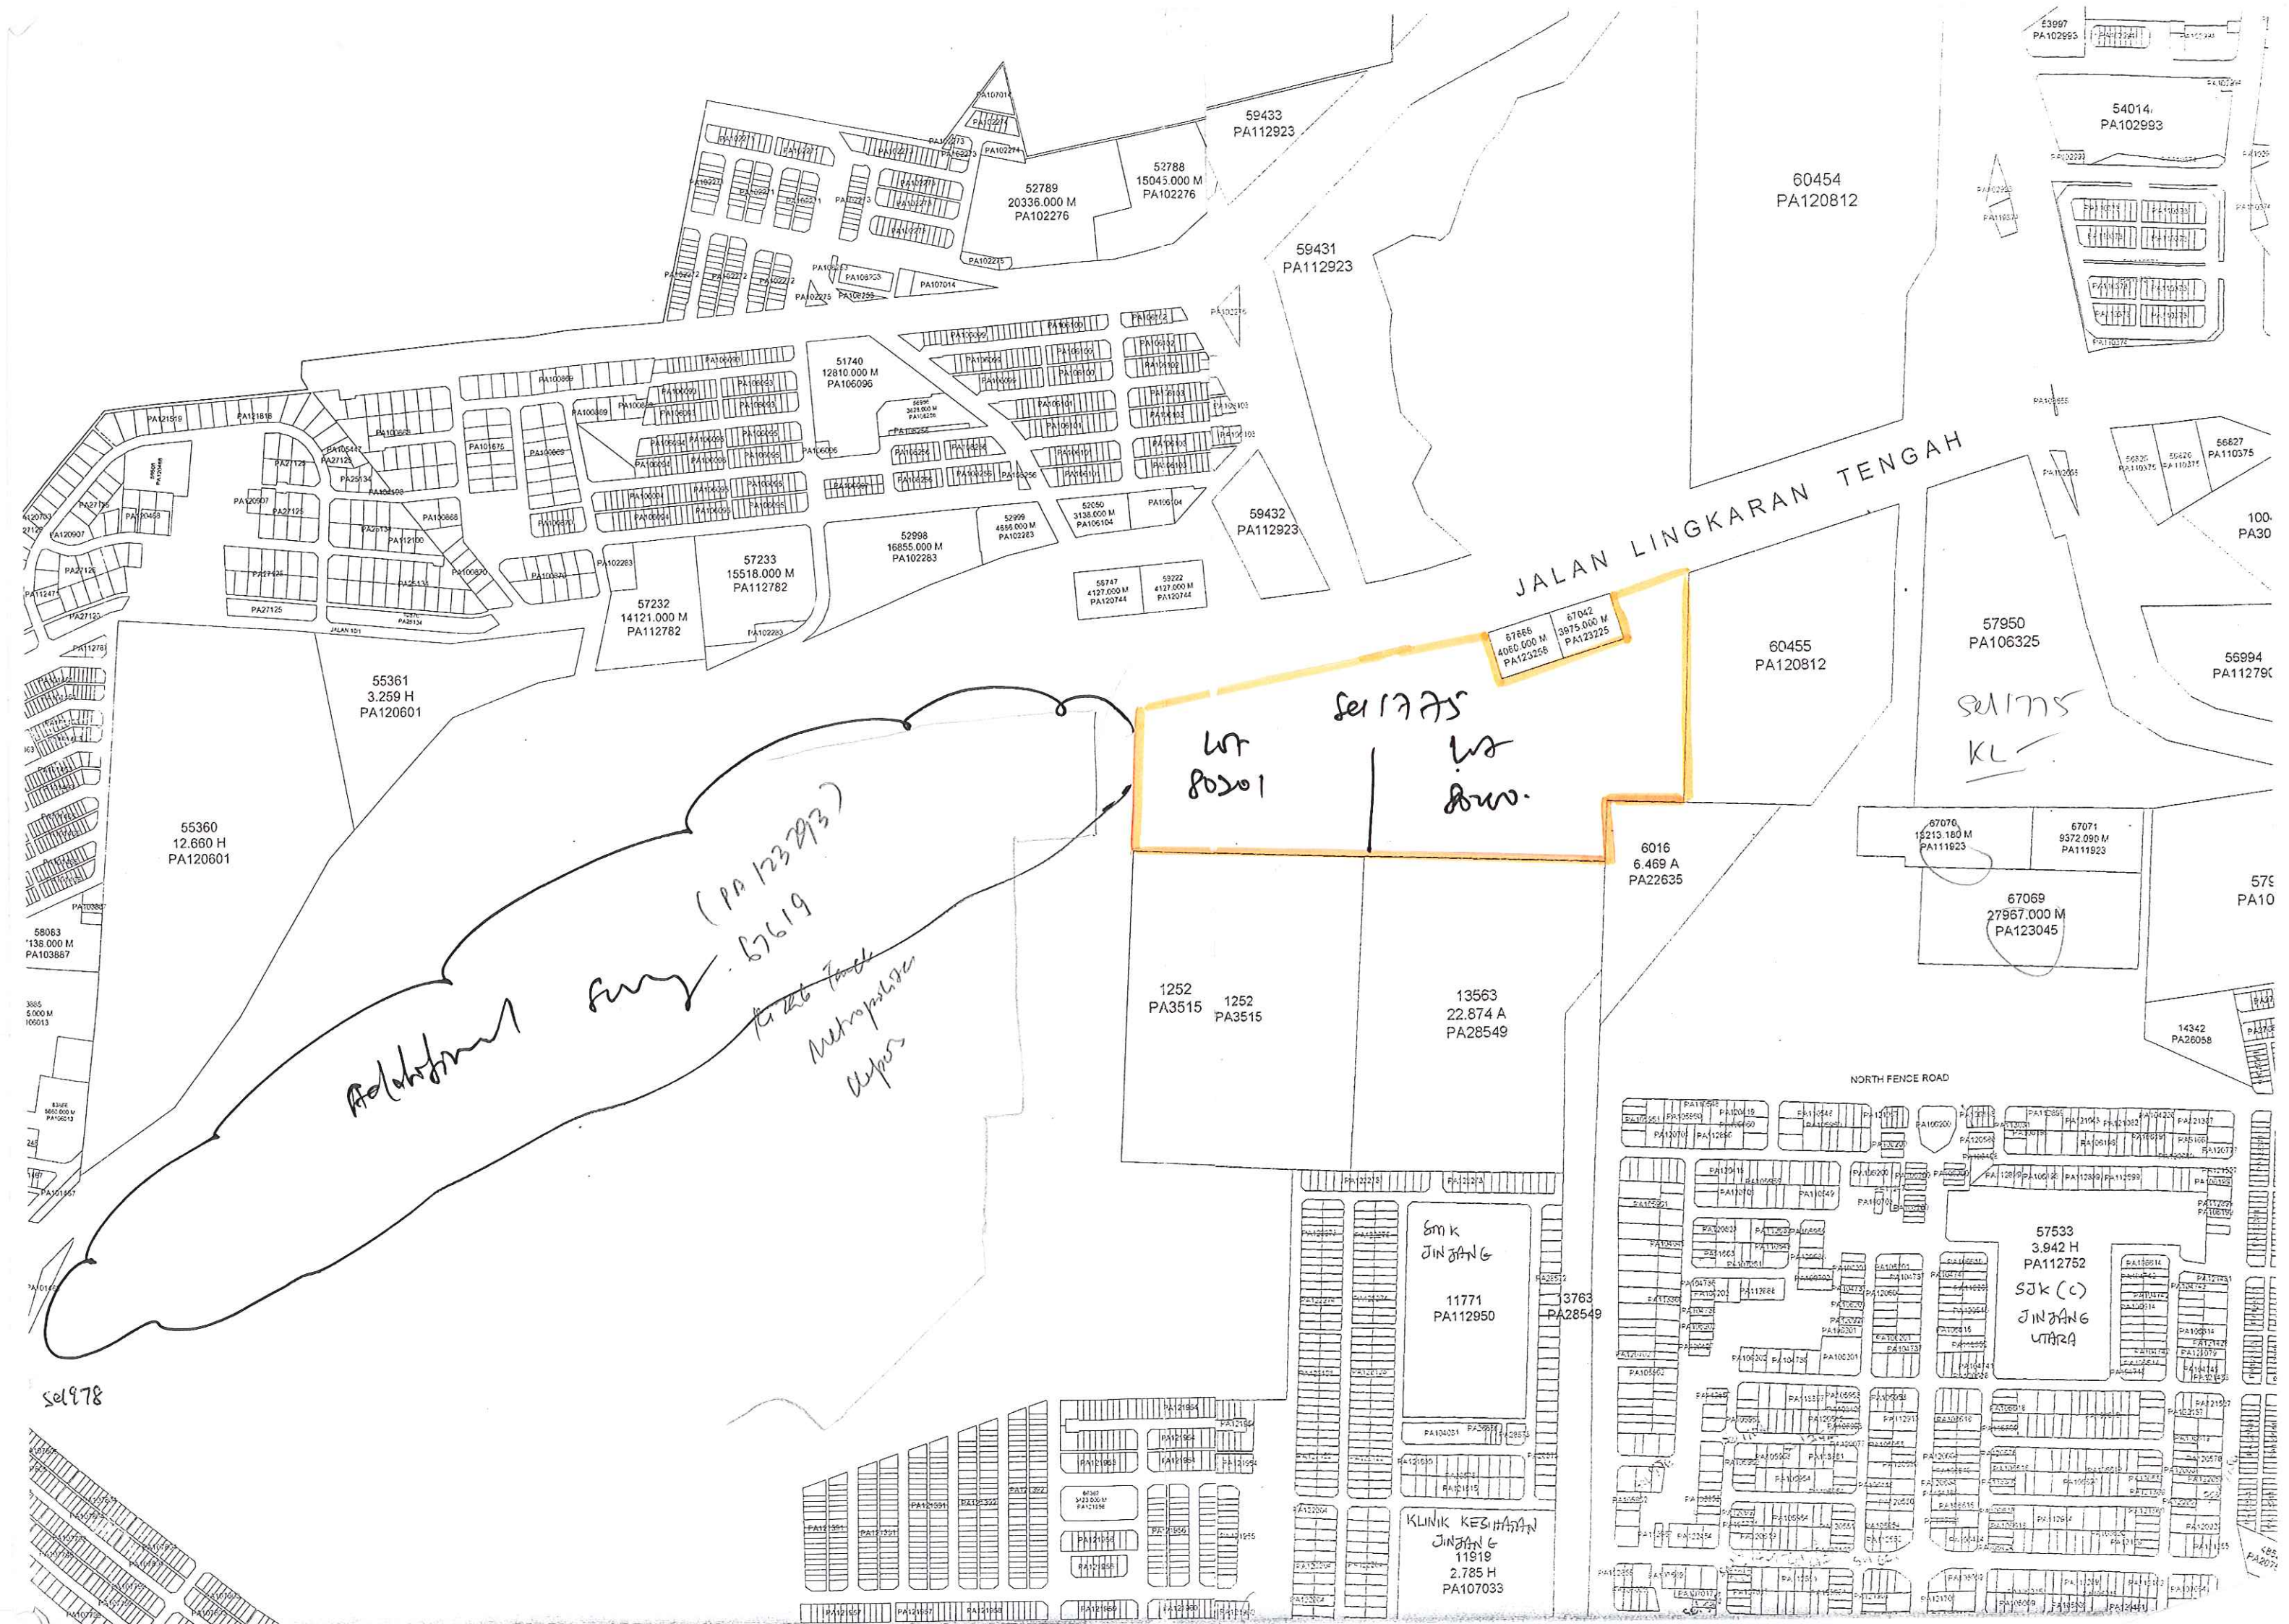

IKIM BATU

77-1

SEL 1775

Site
Sel 1775
(refer Jukem
Main
Survey plan.)

1252
PA3515

KL Standard
sheet

Additional strip survey area

refer
SELANGOR
Std-sheet



