

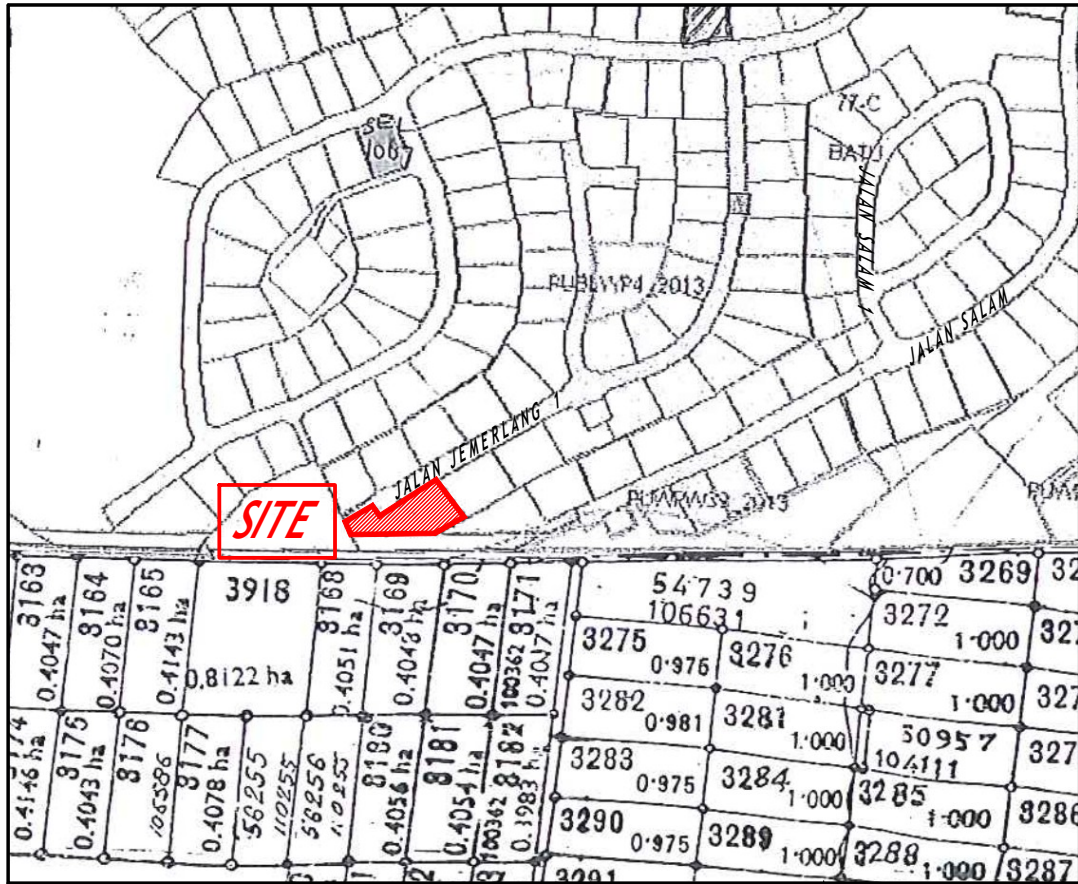


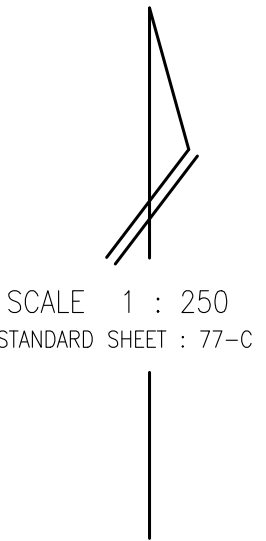

PELAN LOKASI
TANPA SKALA

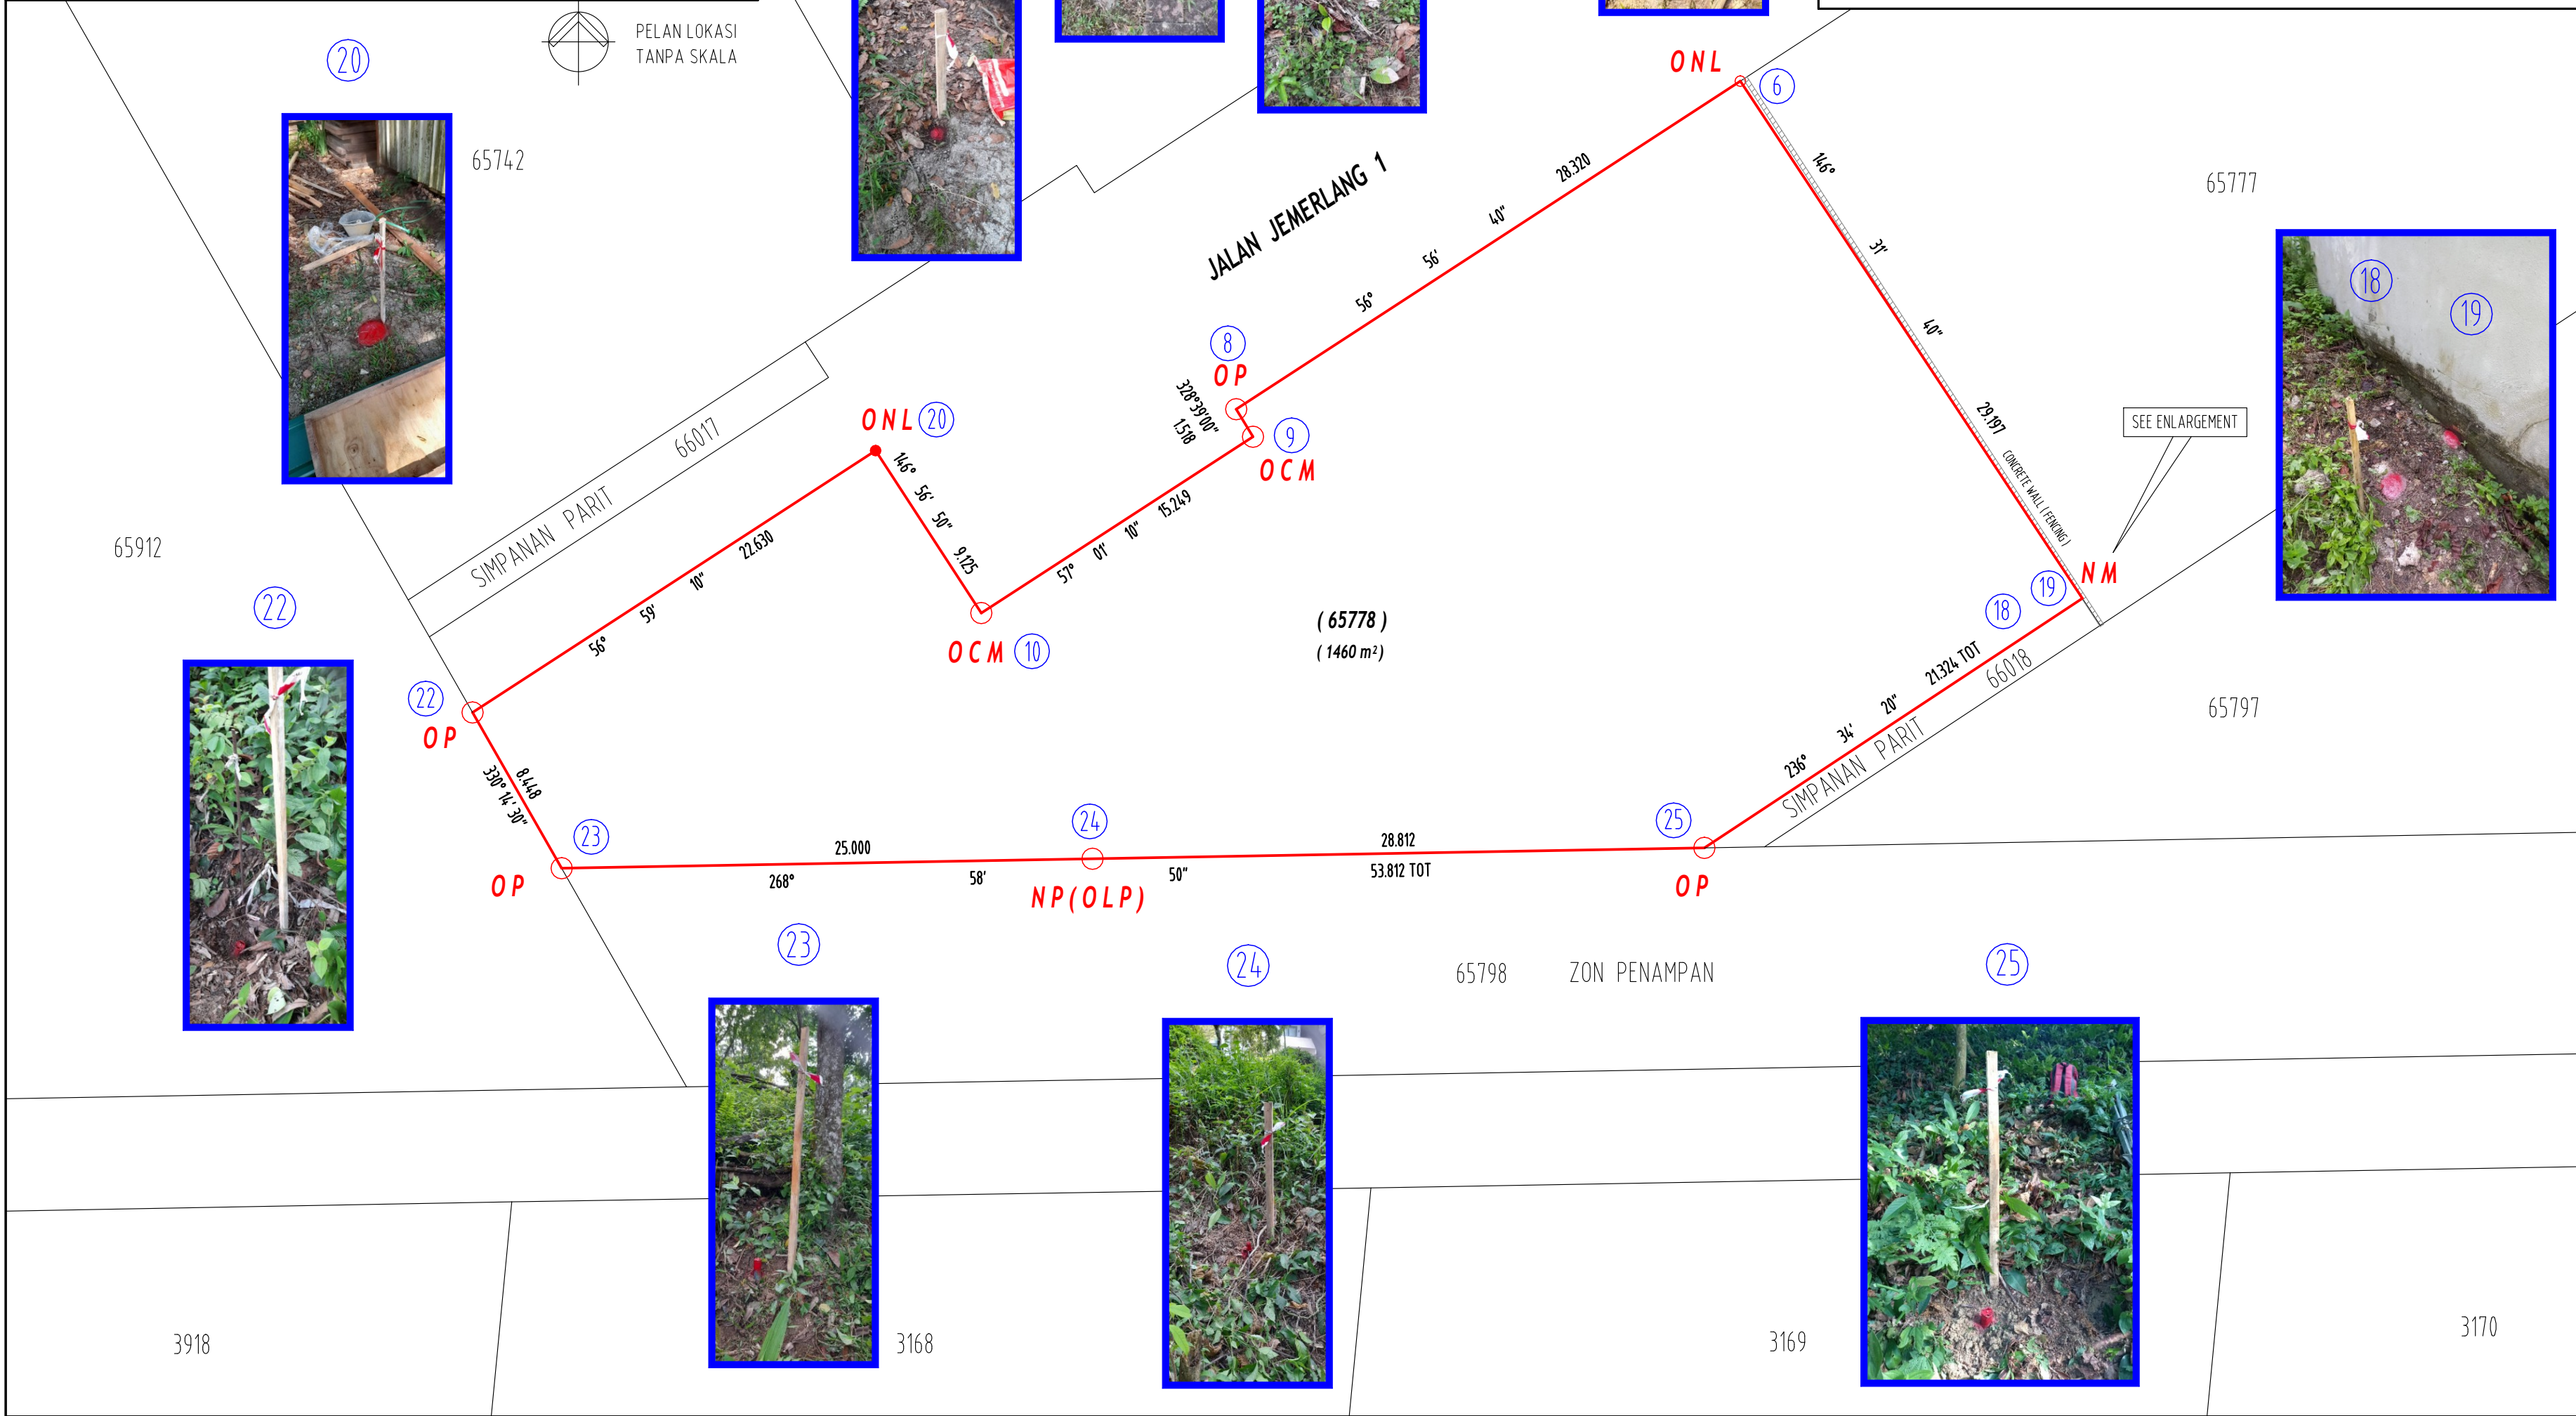

SCALE 1 : 250
STANDARD SHEET : 77-C

TITLE
DEMARICATION SURVEY
ON LOT 65778,
MUKIM OF BATU,
WILAYAH PERSEKUTUAN,
KUALA LUMPUR.

- LEGEND:
- OCM - OLD CONCRETE MARK
 - ONL - OLD NAIL
 - OP - OLD PIPE
 - NP - NEW PIPE
 - NM - NO MARK POSITION
 - OLP - ON LINE PEG
 - RM - REFERENCE MARK (NEW NAIL)

FIELD BOOK NO. F01300

SURVEYED BY : MAZLAN

COMPUTED BY : FRZ

DRAWN BY : FRZ 10/07/2023

CHECKED BY : K.P.H'NG



H'NG KIM POR B.Sur. (Hons.) (Land) MS (M)
Land Surveyor Licensed Under Act 458 (Revised 1991)



No. 35-1, Jalan 16/155C, Bandar Bukit Jalil
57000, Kuala Lumpur, Malaysia
Tel : 03-89940029 / 89940069
Fax : 03-89940039
Email : jnmurni@gmail.com

PLAN NO. : JM/E/23/SEL/3067/A

DIGITAL FILE : JMSSEL3067A