
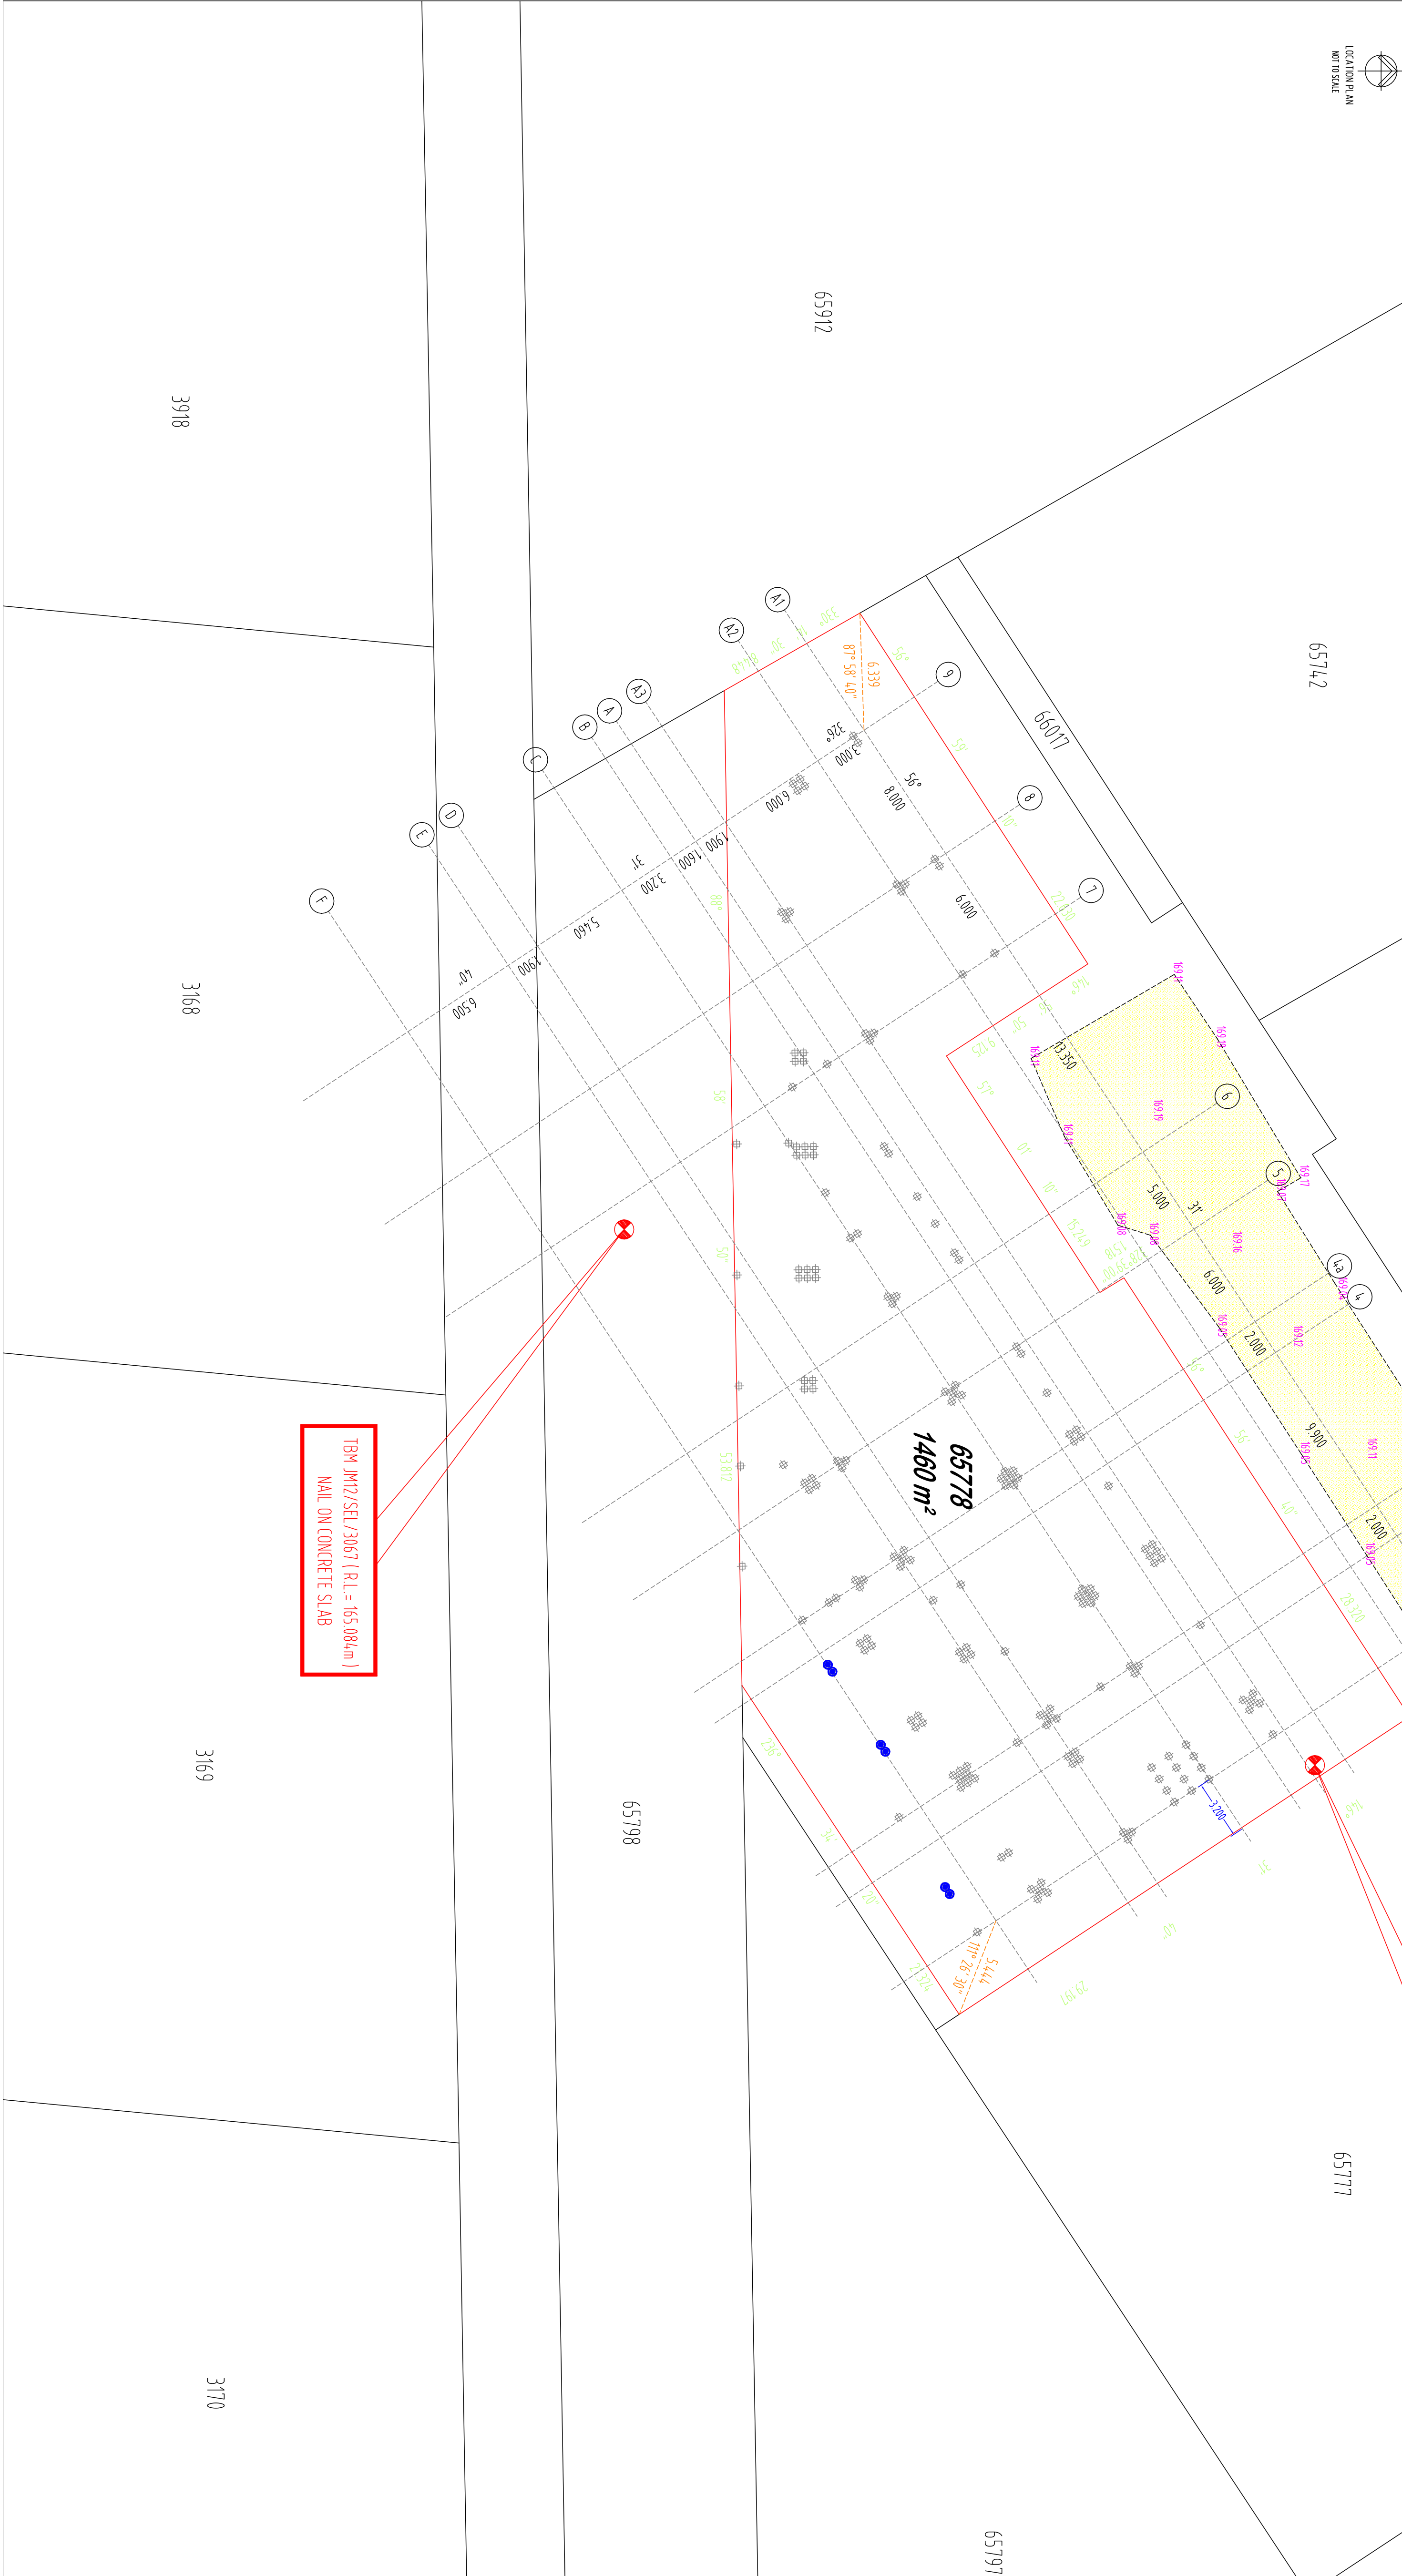


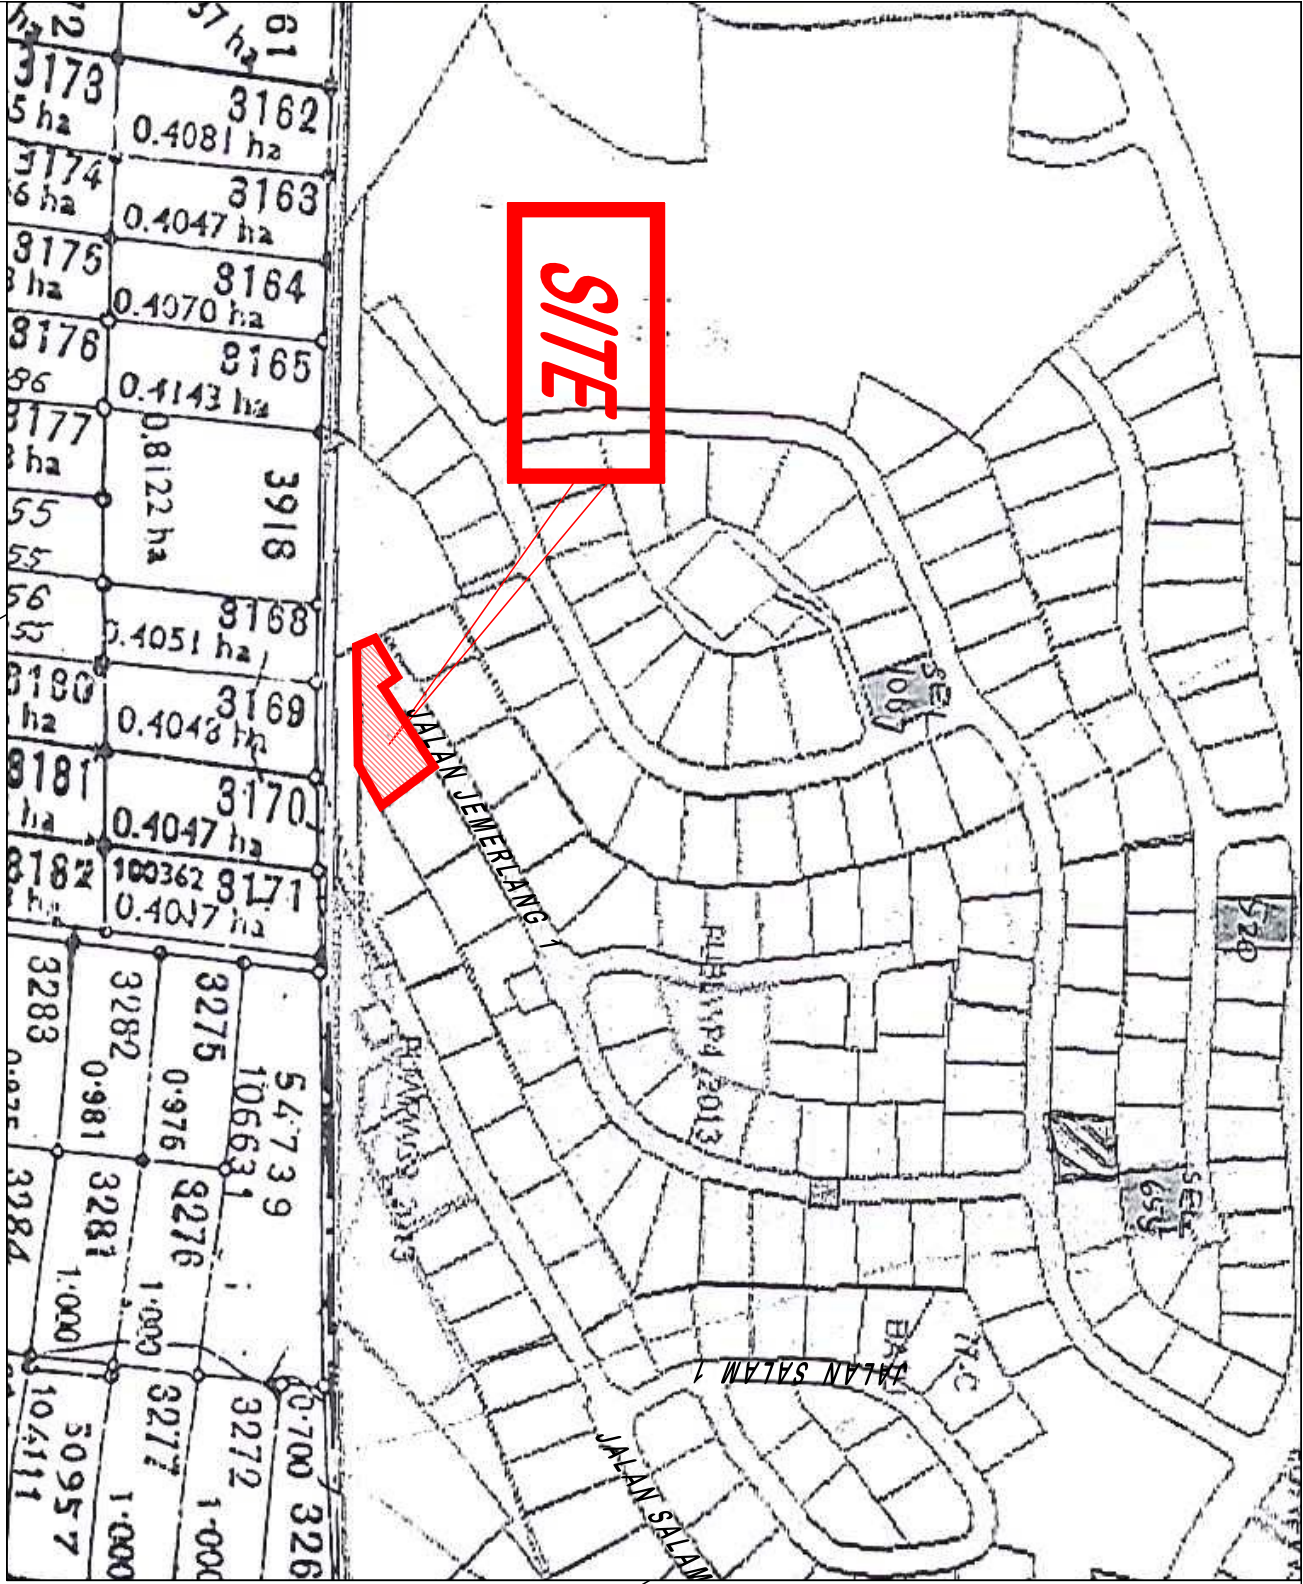

SCALE 1 : 200
STANDARD SHEET : 77-C

TITLE
SETTING OUT SURVEY & ESTABLISHMENT OF TBMS
ON LOT 65778,
MUKIM OF BATU,
WILAYAH PERSEKUTUAN KUALA LUMPUR

NOTE :
ALL LEVELS ARE BASED ON BM 4700 (R.L. 52.79m) LOCATED AT
DUAAPUAN STEEN WYKAK RMA BUKIT LAMUAN, DUNANSARA RETAILING

LEGEND :
- PROPOSED NEW PILE POSITIONS
- IRON ROD

SURVEYED BY : MAZLAN
COMPUTED BY : HAYATI
DRAWN BY : HAYATI / LIN
CHECKED BY : K. P. HING



HING KIM POR, B.Sc. (Hons.) (Land MS (M)
Land Surveyor Licensed Under Act 158 (Revised 1991)

JURUKUR MURNI
LICENSED LAND SURVEYOR
NO. 354, JALAN 16/155C,
BUKIT TALL,
57000 Kuala Lumpur, Malaysia
TEL: 03-8994002/69 FAX: 03-89940039
EMAIL: jmur@gmail.com

PLAN NO. : JME/23/SEL/3067/D
DIGITAL FILE : JMSEL3067/D