


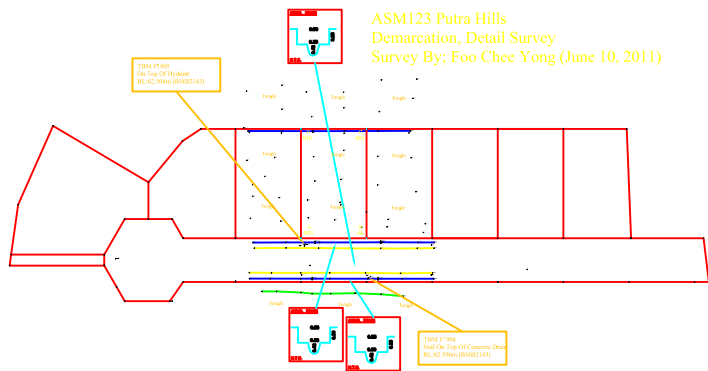

ASM123 Putra Hills
Demarcation, Detail Survey
Survey By; Foo Chee Yong (June 10, 2011)