
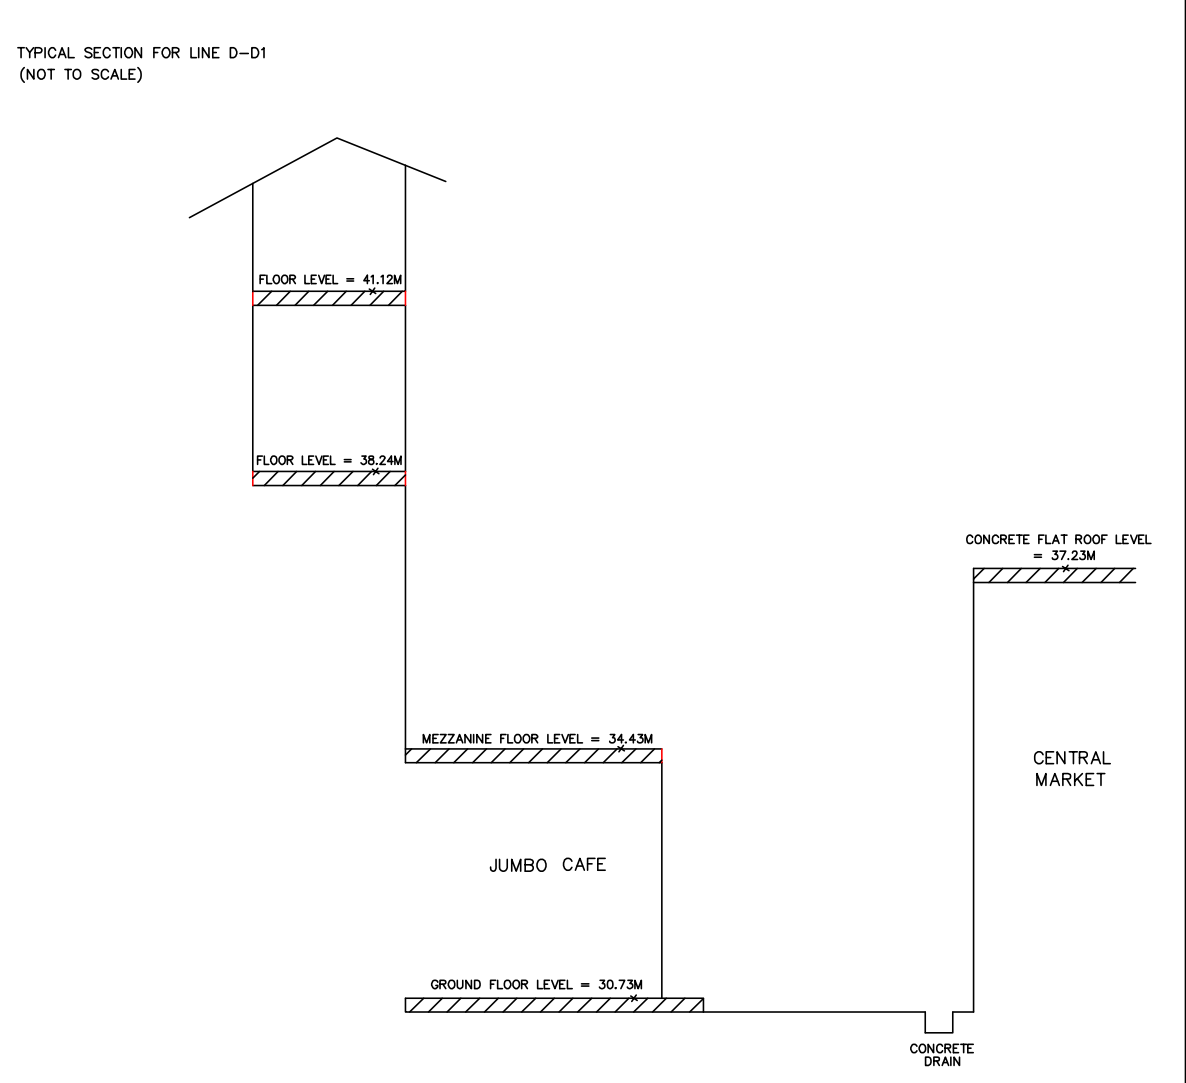
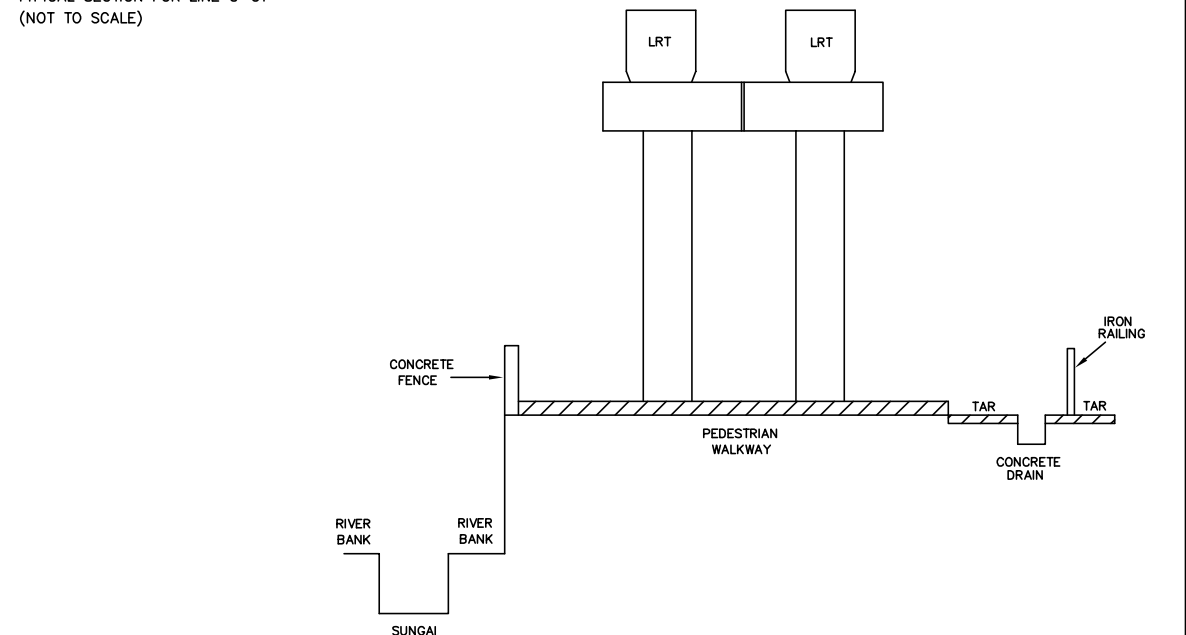
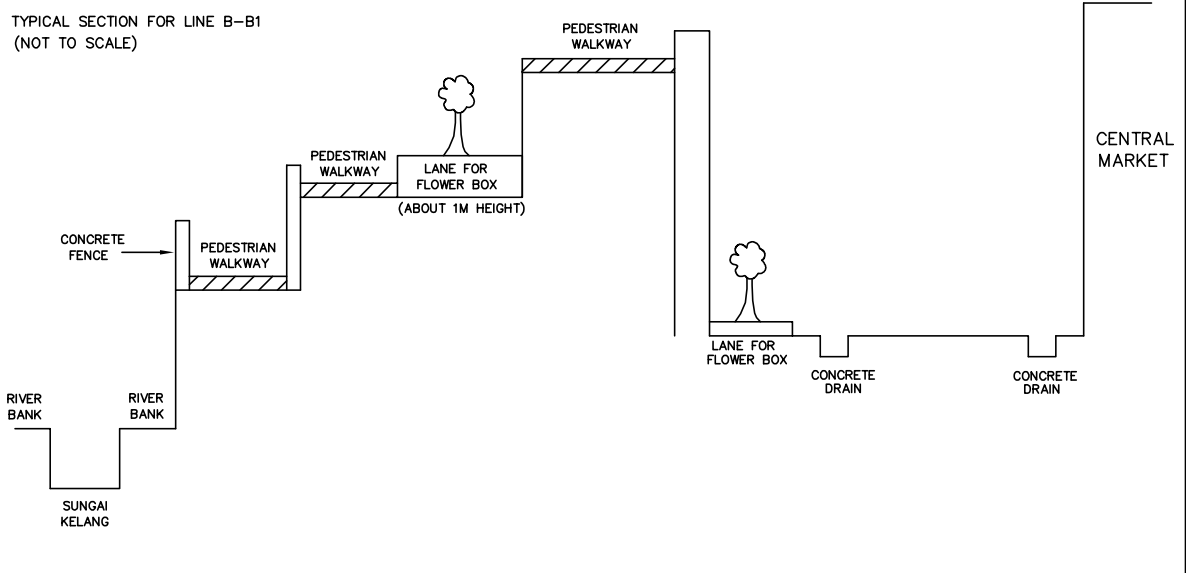
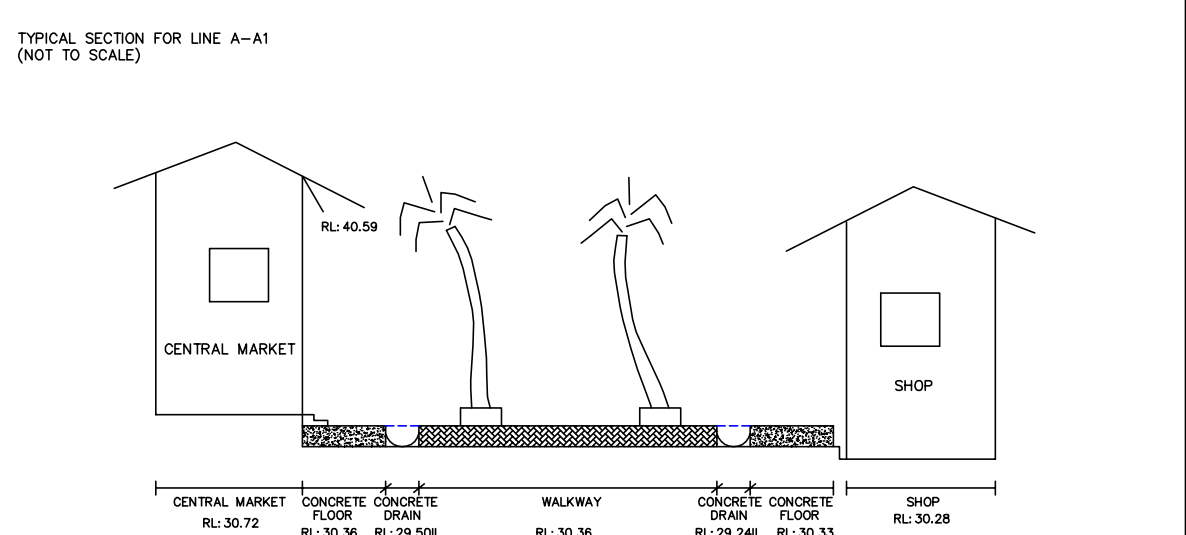
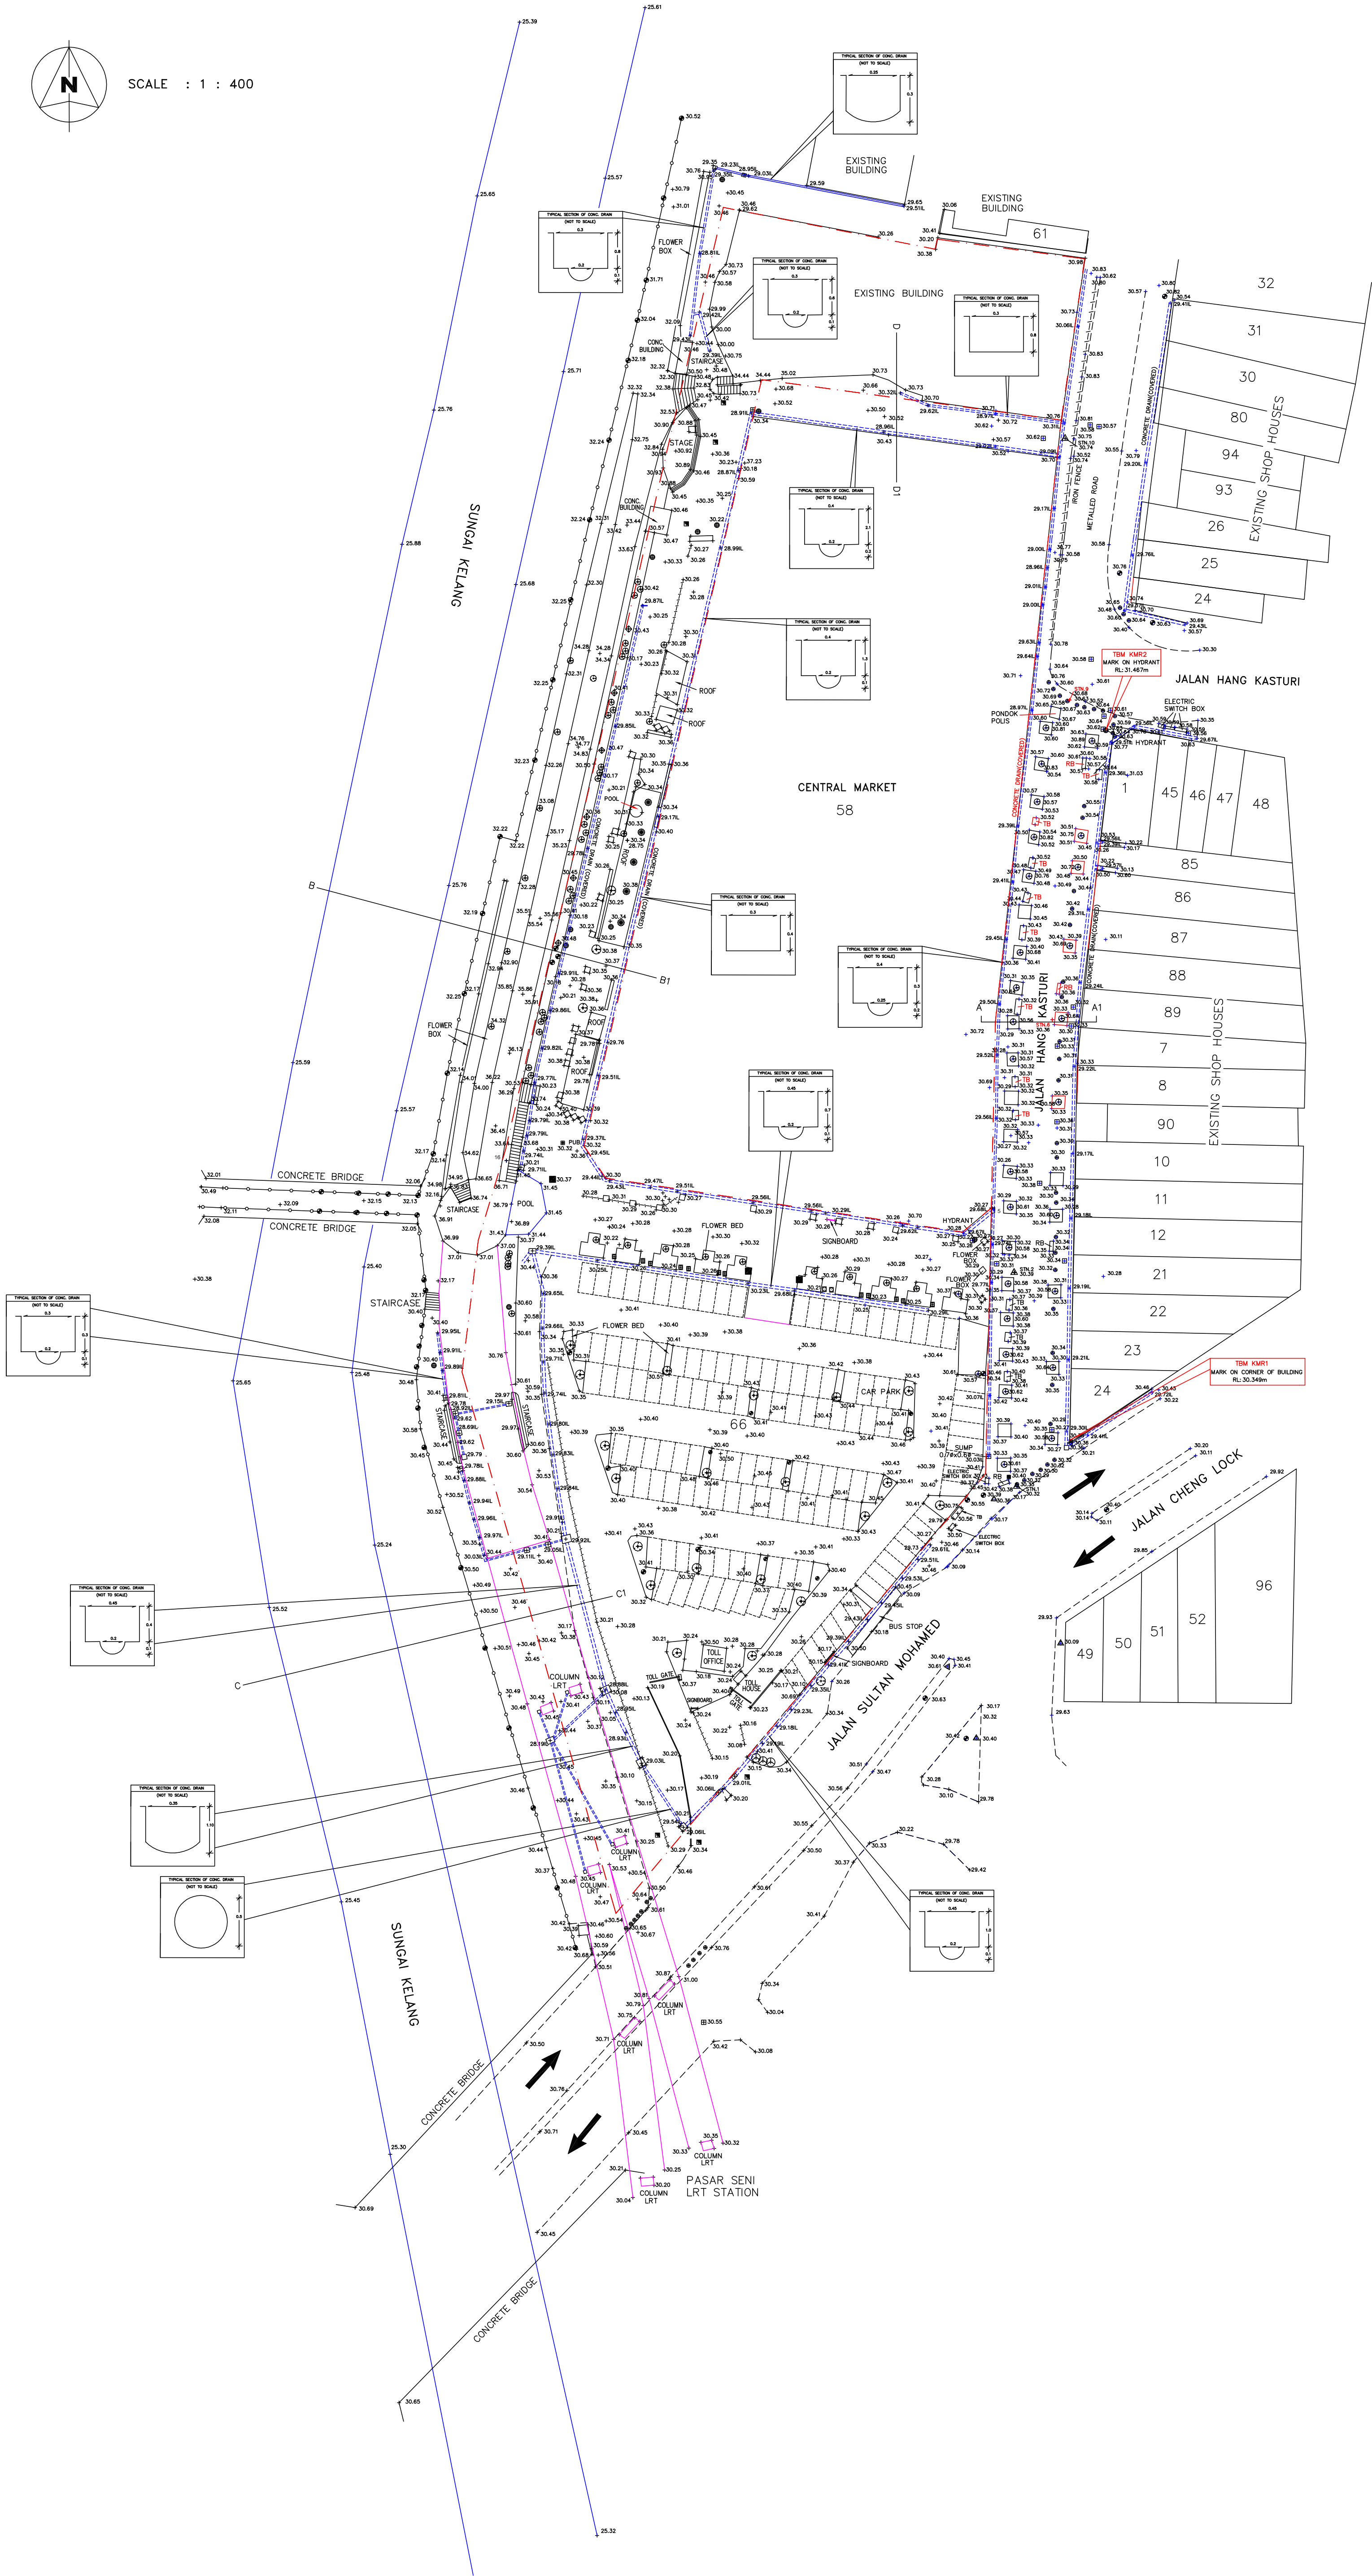


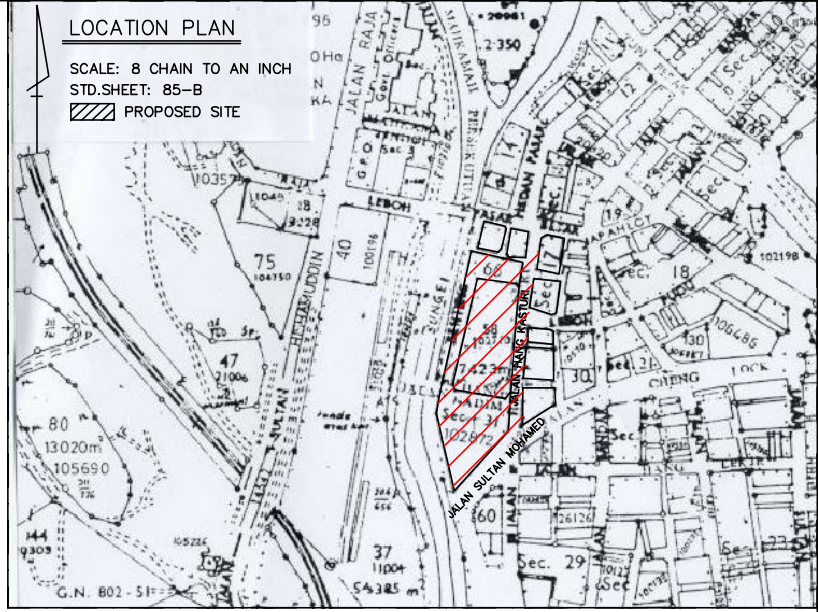

- NOTES :
1. ALL HEIGHTS ARE BASED ON TBM W4 (RL 37.173m).
 2. FIELD BOOK NO. 1914
 3. LEVEL BOOK NO. 321
 4. TACHY BOOK NO. 1813
 5. TB TELEPHONE BOOTH
 6. RB RUBBISH BIN
 7. TS TRAVEL STATION
 8. MH MANHOLE
 9. SB SIGNBOARD
 10. TL TRAFFIC LIGHT
 11. IB IRON BAR
 12. T TREE
 13. LP LAMP POST
 14. TM TELECOM MANHOLE
 15. U UMBRELLA
 16. S SPOTLIGHT
 17. SM SEWERAGE MANHOLE
 18. IR IRON RAILING
 19. CF CONCRETE FENCE
 20. B Boundary

DETAIL AND SPOT LEVEL SURVEY FOR CENTRAL MARKET

KUALA LUMPUR, WILAYAH PERSEKUTUAN

LICENSED SURVEYOR :			
SURVEYED BY : RAHIM, GEOFFREY 23.08.2004		PLAN NO. JK/04/WP/545/G2	
DRAWN BY : MOHAN, GEOFFREY 2.09.2004			
CHECKED BY :			