



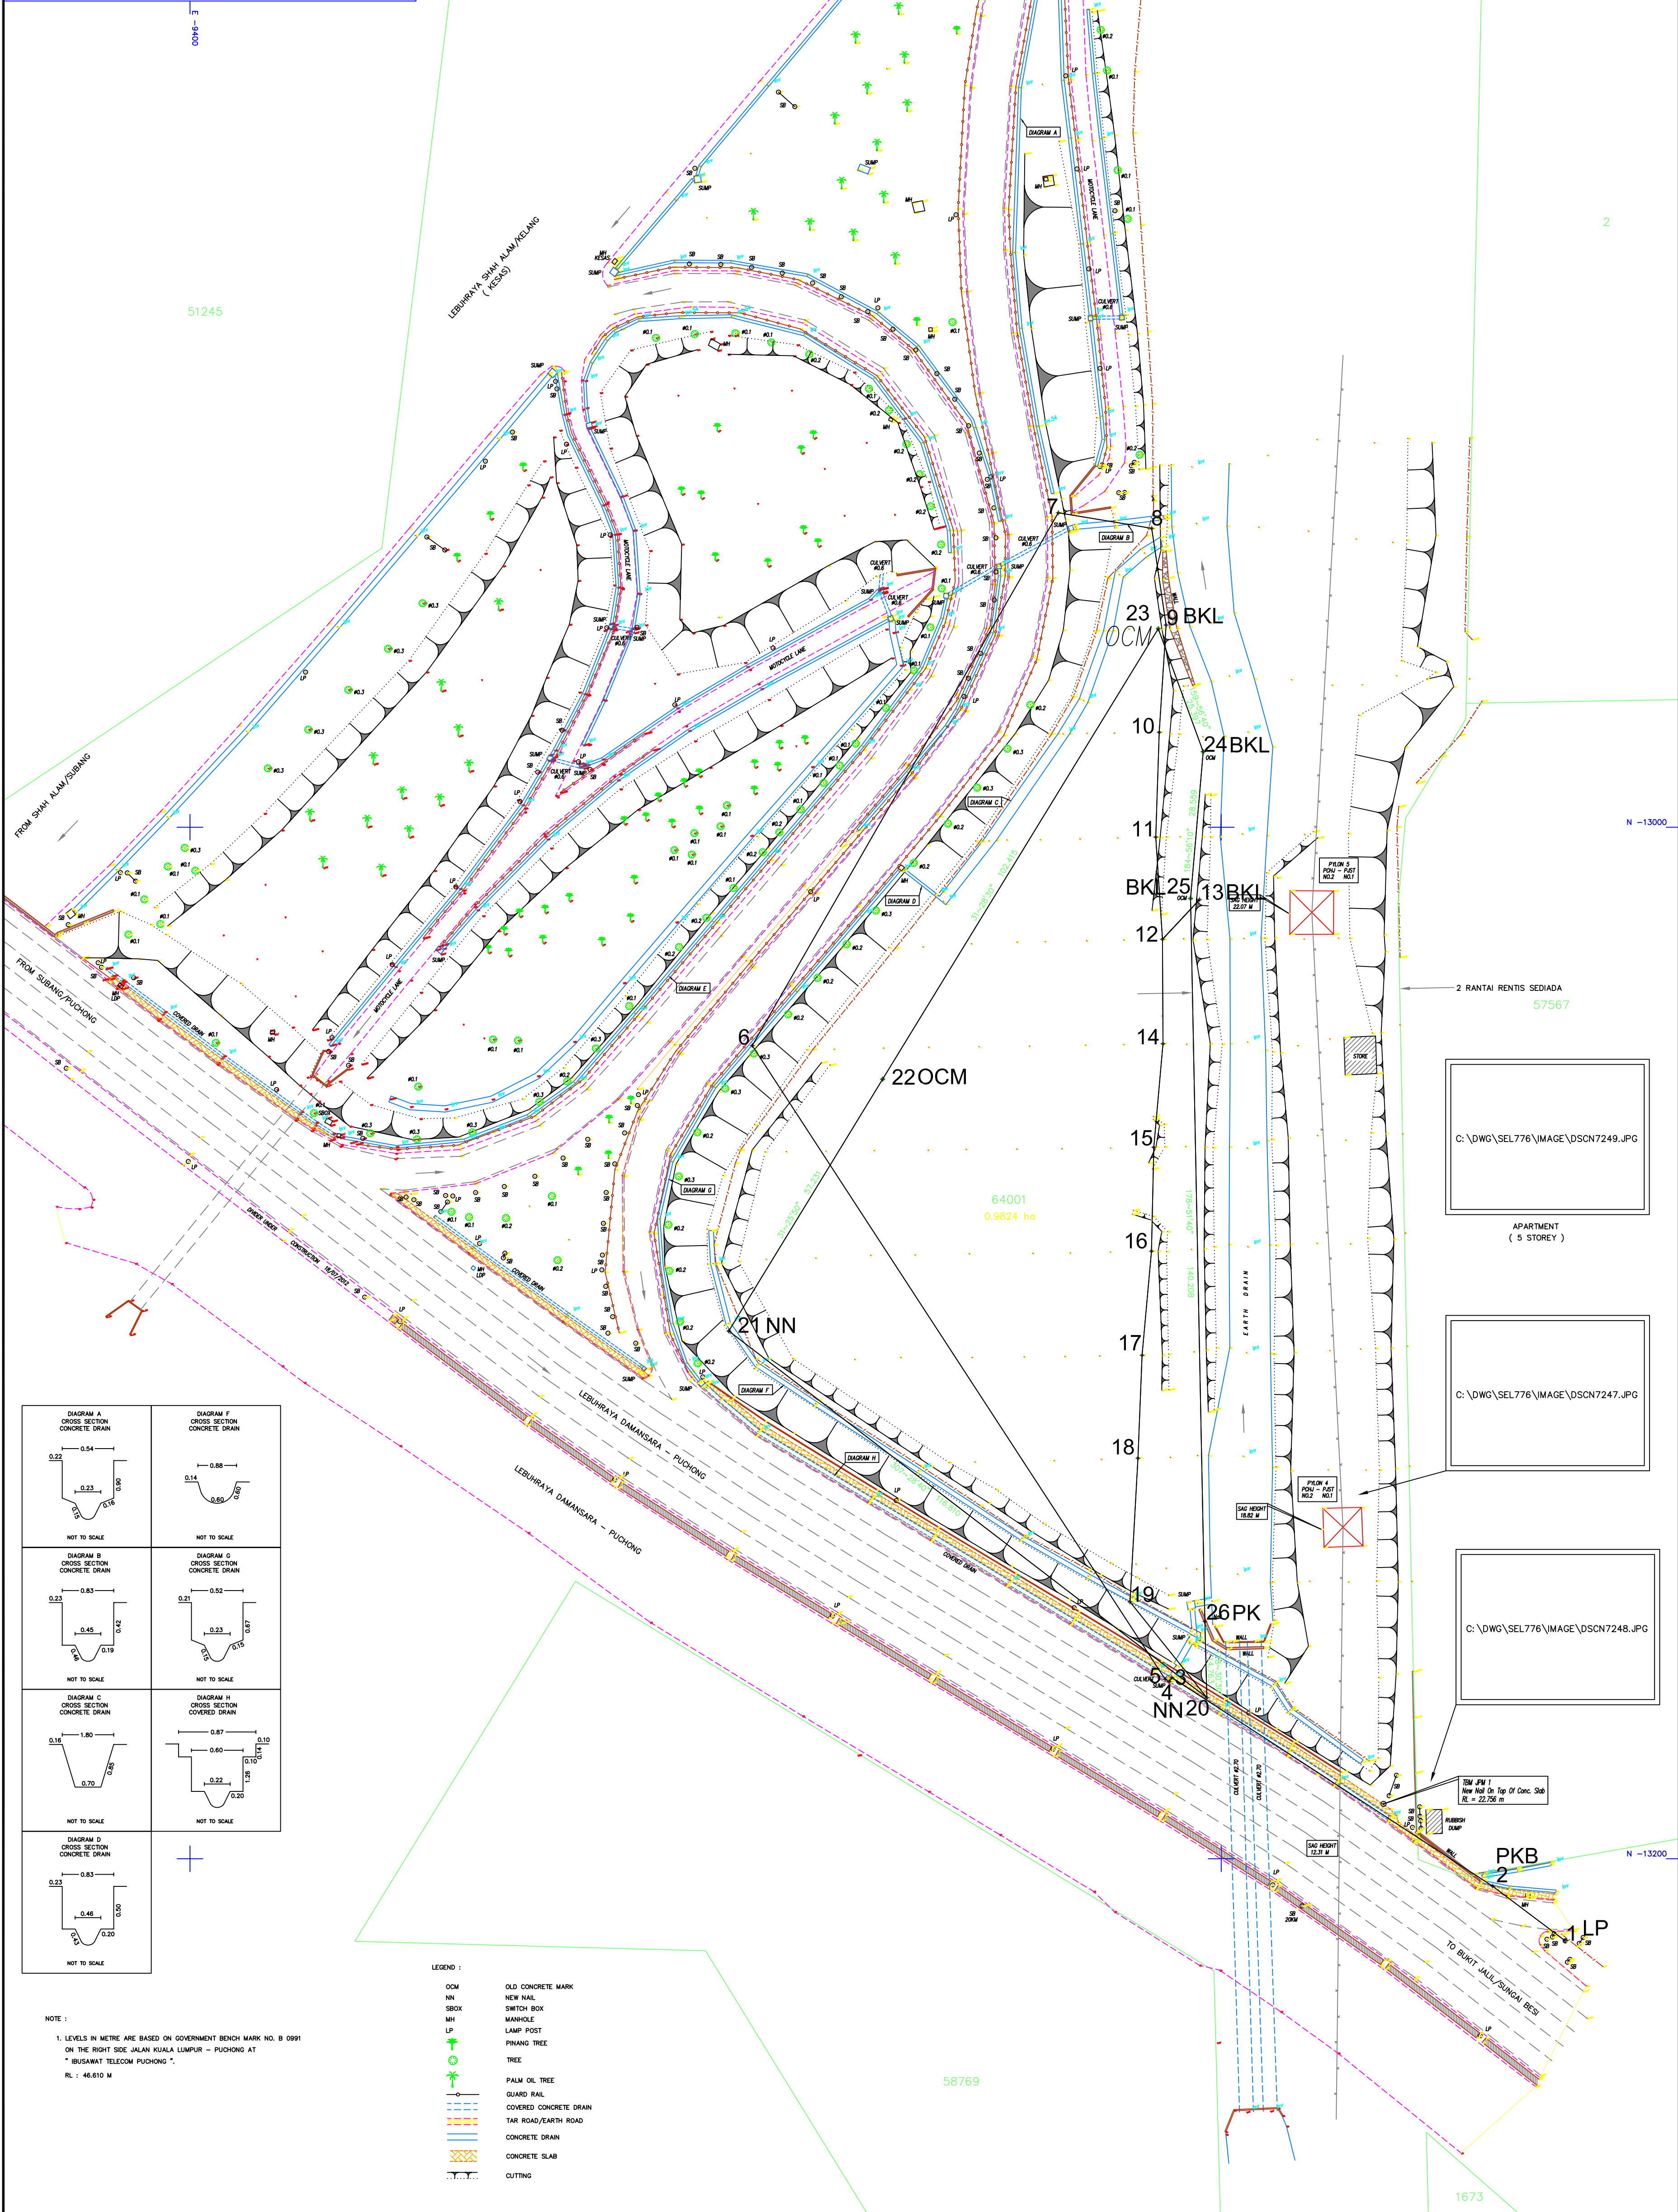

DEMARCATON, DETAIL AND LEVELLING SURVEY OF LOT 64001 (PT 34445)
AND DETAIL SURVEY OF THE LDP & SHAH ALAM HIGHWAY
AT THE LDP/SHAH ALAM INTERCHANGE
PEKAN DESA PUCHONG, DISTRICT OF PETALING
SELANGOR DARUL EHSAN

Scale 1 : 500

Surveyed By: Shaikhan Date: 14 July 2012
Drawn By: Ziaa Date: 20 July 2012
Checked By: Abd. Aziz Date: 23 July 2012

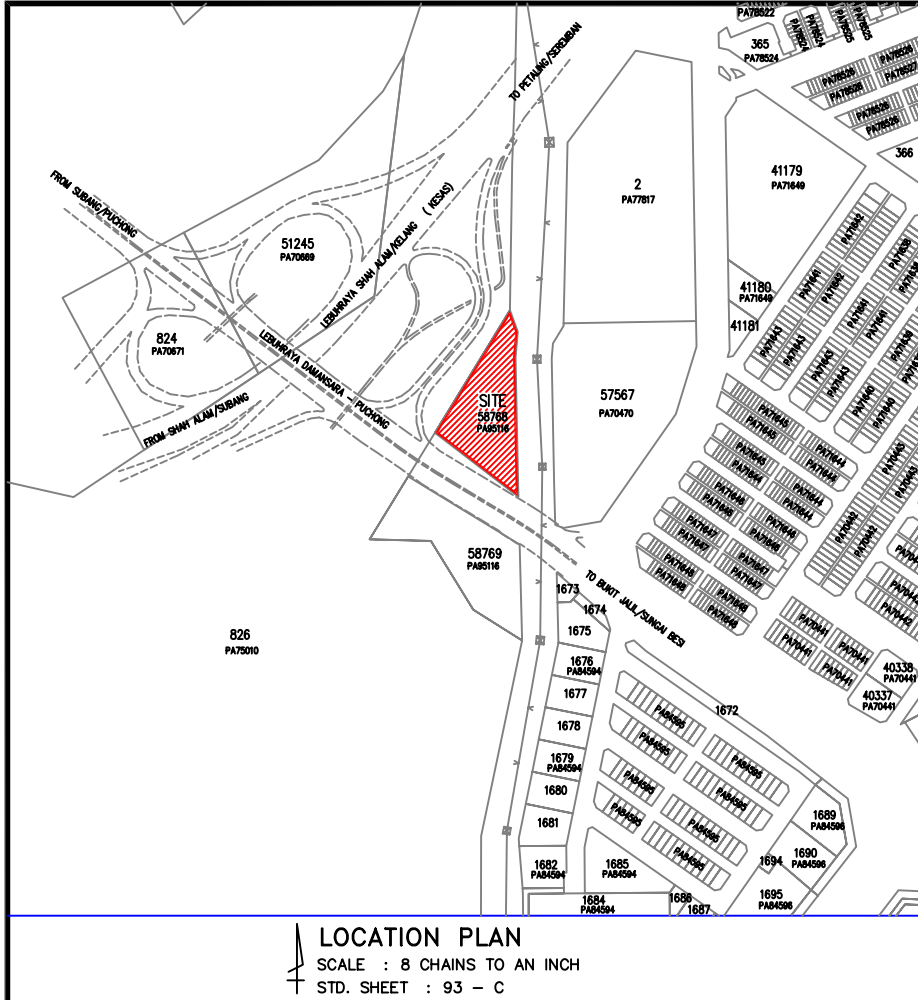

No. Drawing: JPM(SEL)776/2012/DE
Signature: TOH SWEI ENG K. M. N. P. J. K
Date: 24 July 2012