


APPENDIX F1: (LOWER GROUND FLOOR)

NOTES:

- 1) To pick up the position of Internal walls (Points W1, W2, W3, W4, W5, W6 & W7) of Lift Lobby.
- 2) To pick up the position of Internal walls of Existing UPS Room (Points W8, W9, W10, W11, W12, W13, W14, W15, W16, W17, W18, W19, W20, W21, W22, W23 & W24).
- 3) To pick up the position of external wall (Points W25, W26, W27 & W28).
- 4) To pick up the position of Columns C1 & C2.

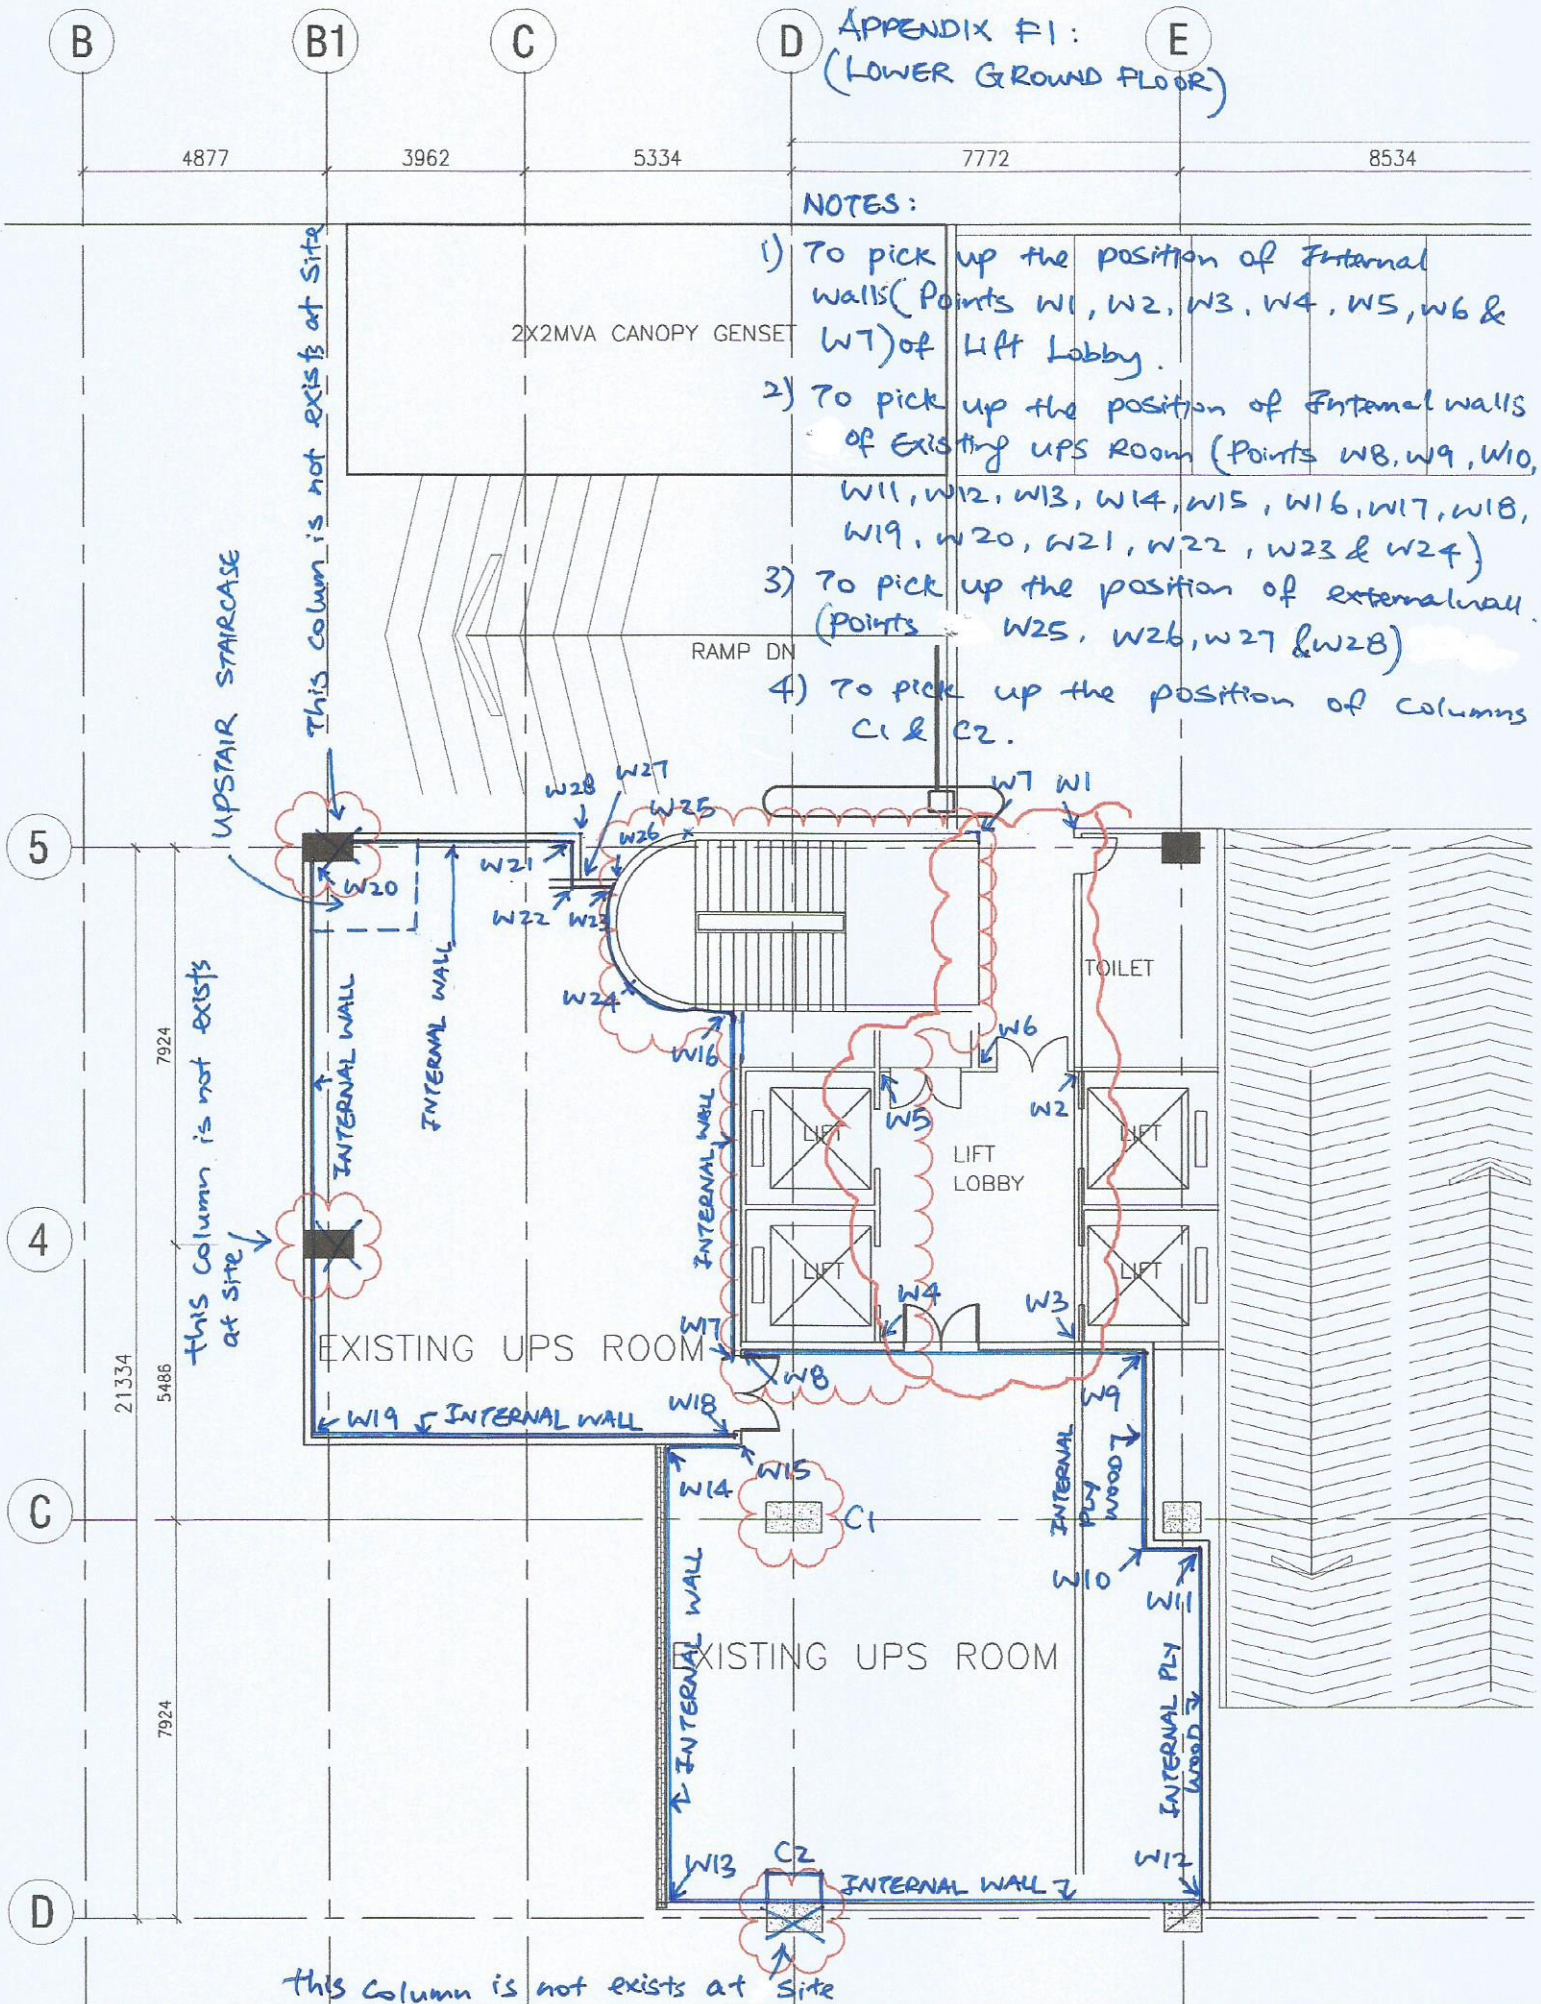

LOWER GROUND FLOOR