


LOTS 230 - 243 SECTION 63
BEING SUBDIVISION OF LOT 202 PLAN 19878
TOWN OF KUALA LUMPUR
DISTRICT OF KUALA LUMPUR
SCALE ONE CHAIN TO AN INCH

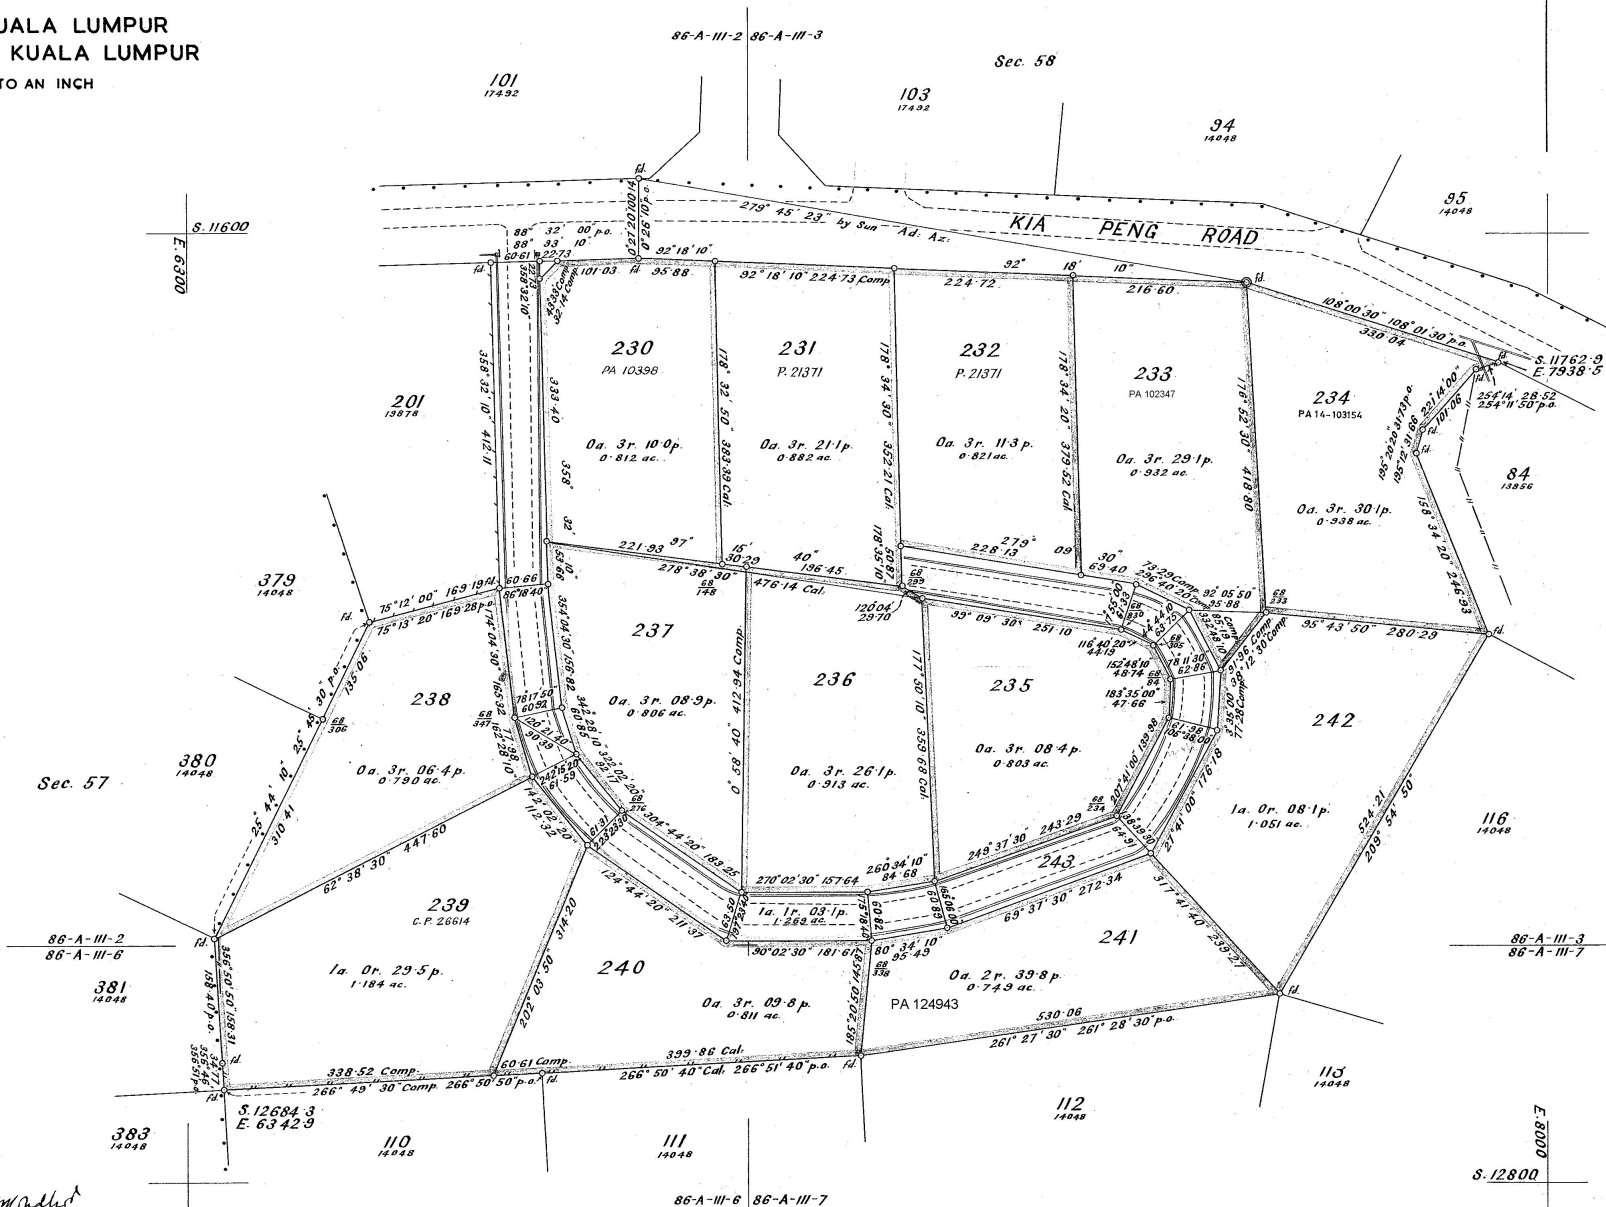

FIRST CLASS SURVEY

DRAWN & CHARTED BY *SM. S. S. S.*
5/12/53

EXAMINED BY *AP. S. S. S.*
12/12/53

PLAN APPROVED *Johnston*
21/12/53

SEL. SVY. 385-52

D.O.K.L. 156-52

SURVEYED BY TEOH KIM POH

COMPLETED ON 27. 2. 53

FIELD BOOK 11668 PAGES 1-42
" " 11680 " 1 & 2