


PLAN
of Portion 1000.
Bangi Railway Station Reserve.
MUKIM OF KAJANG.
DISTRICT OF ULU LANGAT.

Scale Three Chains to an Inch.

Note:

All bearings on this plan are on the Meridian of the Trig. on Bkt. Asa.

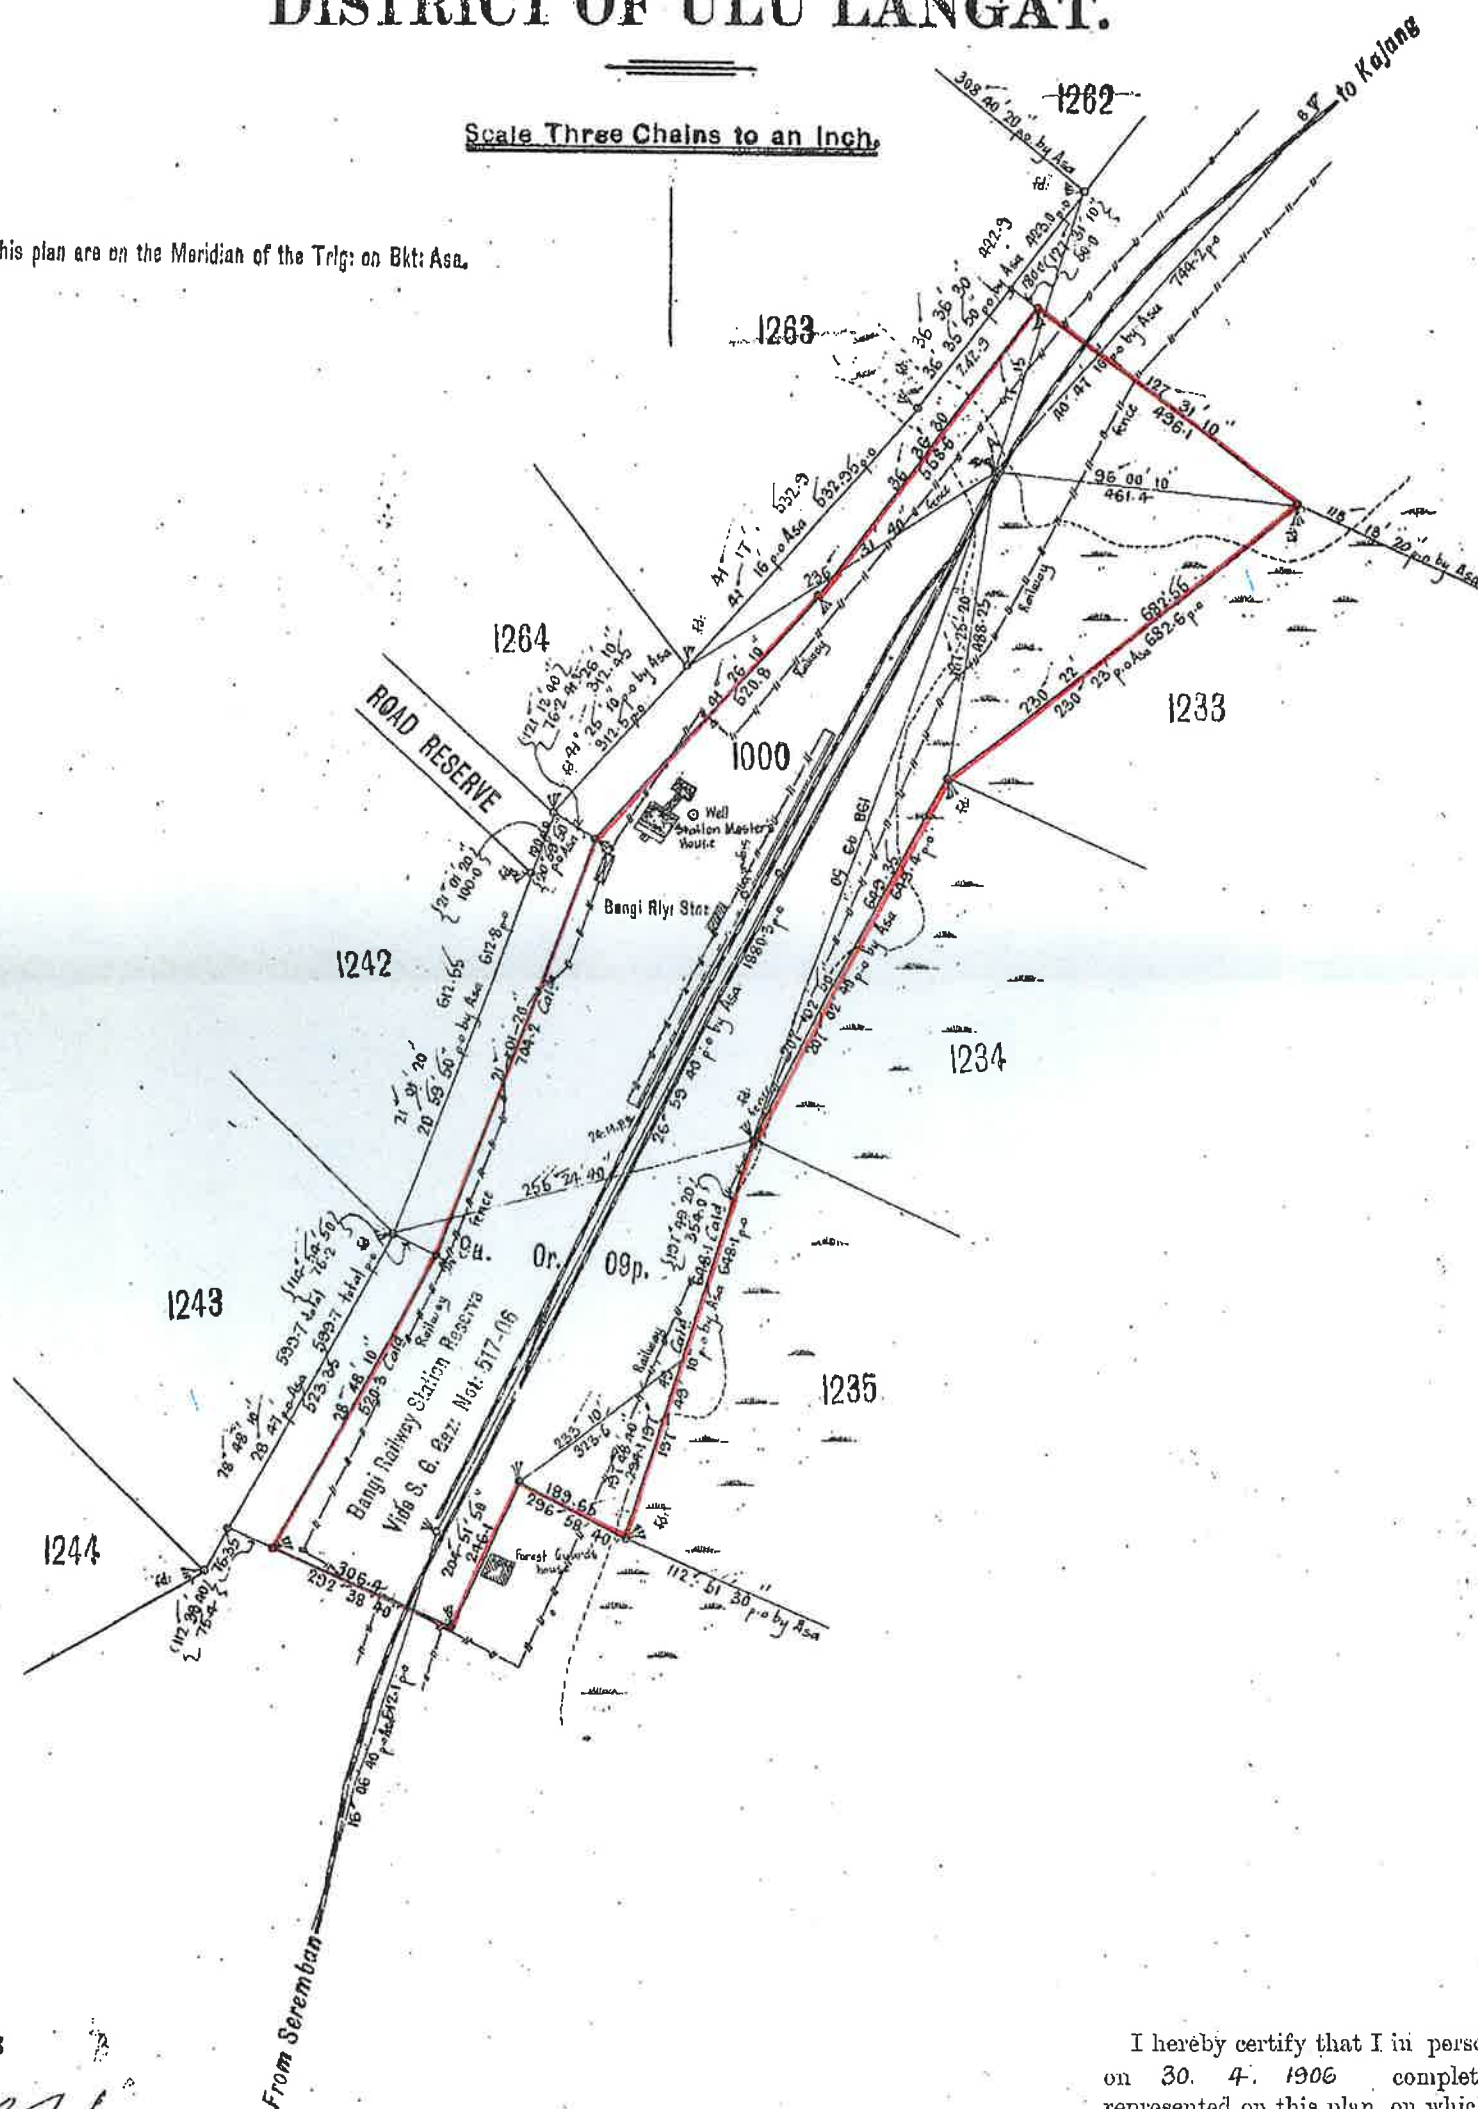

Azimuth taken from A. B

Drawn by

Examined by

Charted by

Plan approved

Field Book 1143 - 688 page 6 + 32

Length of pipes used

Date of transmission 10. 6. 06

I hereby certify that I in person made and on 30. 4. 1906 completed the survey represented on this plan, on which are written the bearings and lengths of the lines measured by me, and I declare that the survey has been executed in accordance with the Regulations.

Dist. Surveyor.

