


NOTA :
UKURAN SEMULA LOT 3482-3484 (PA 25146)

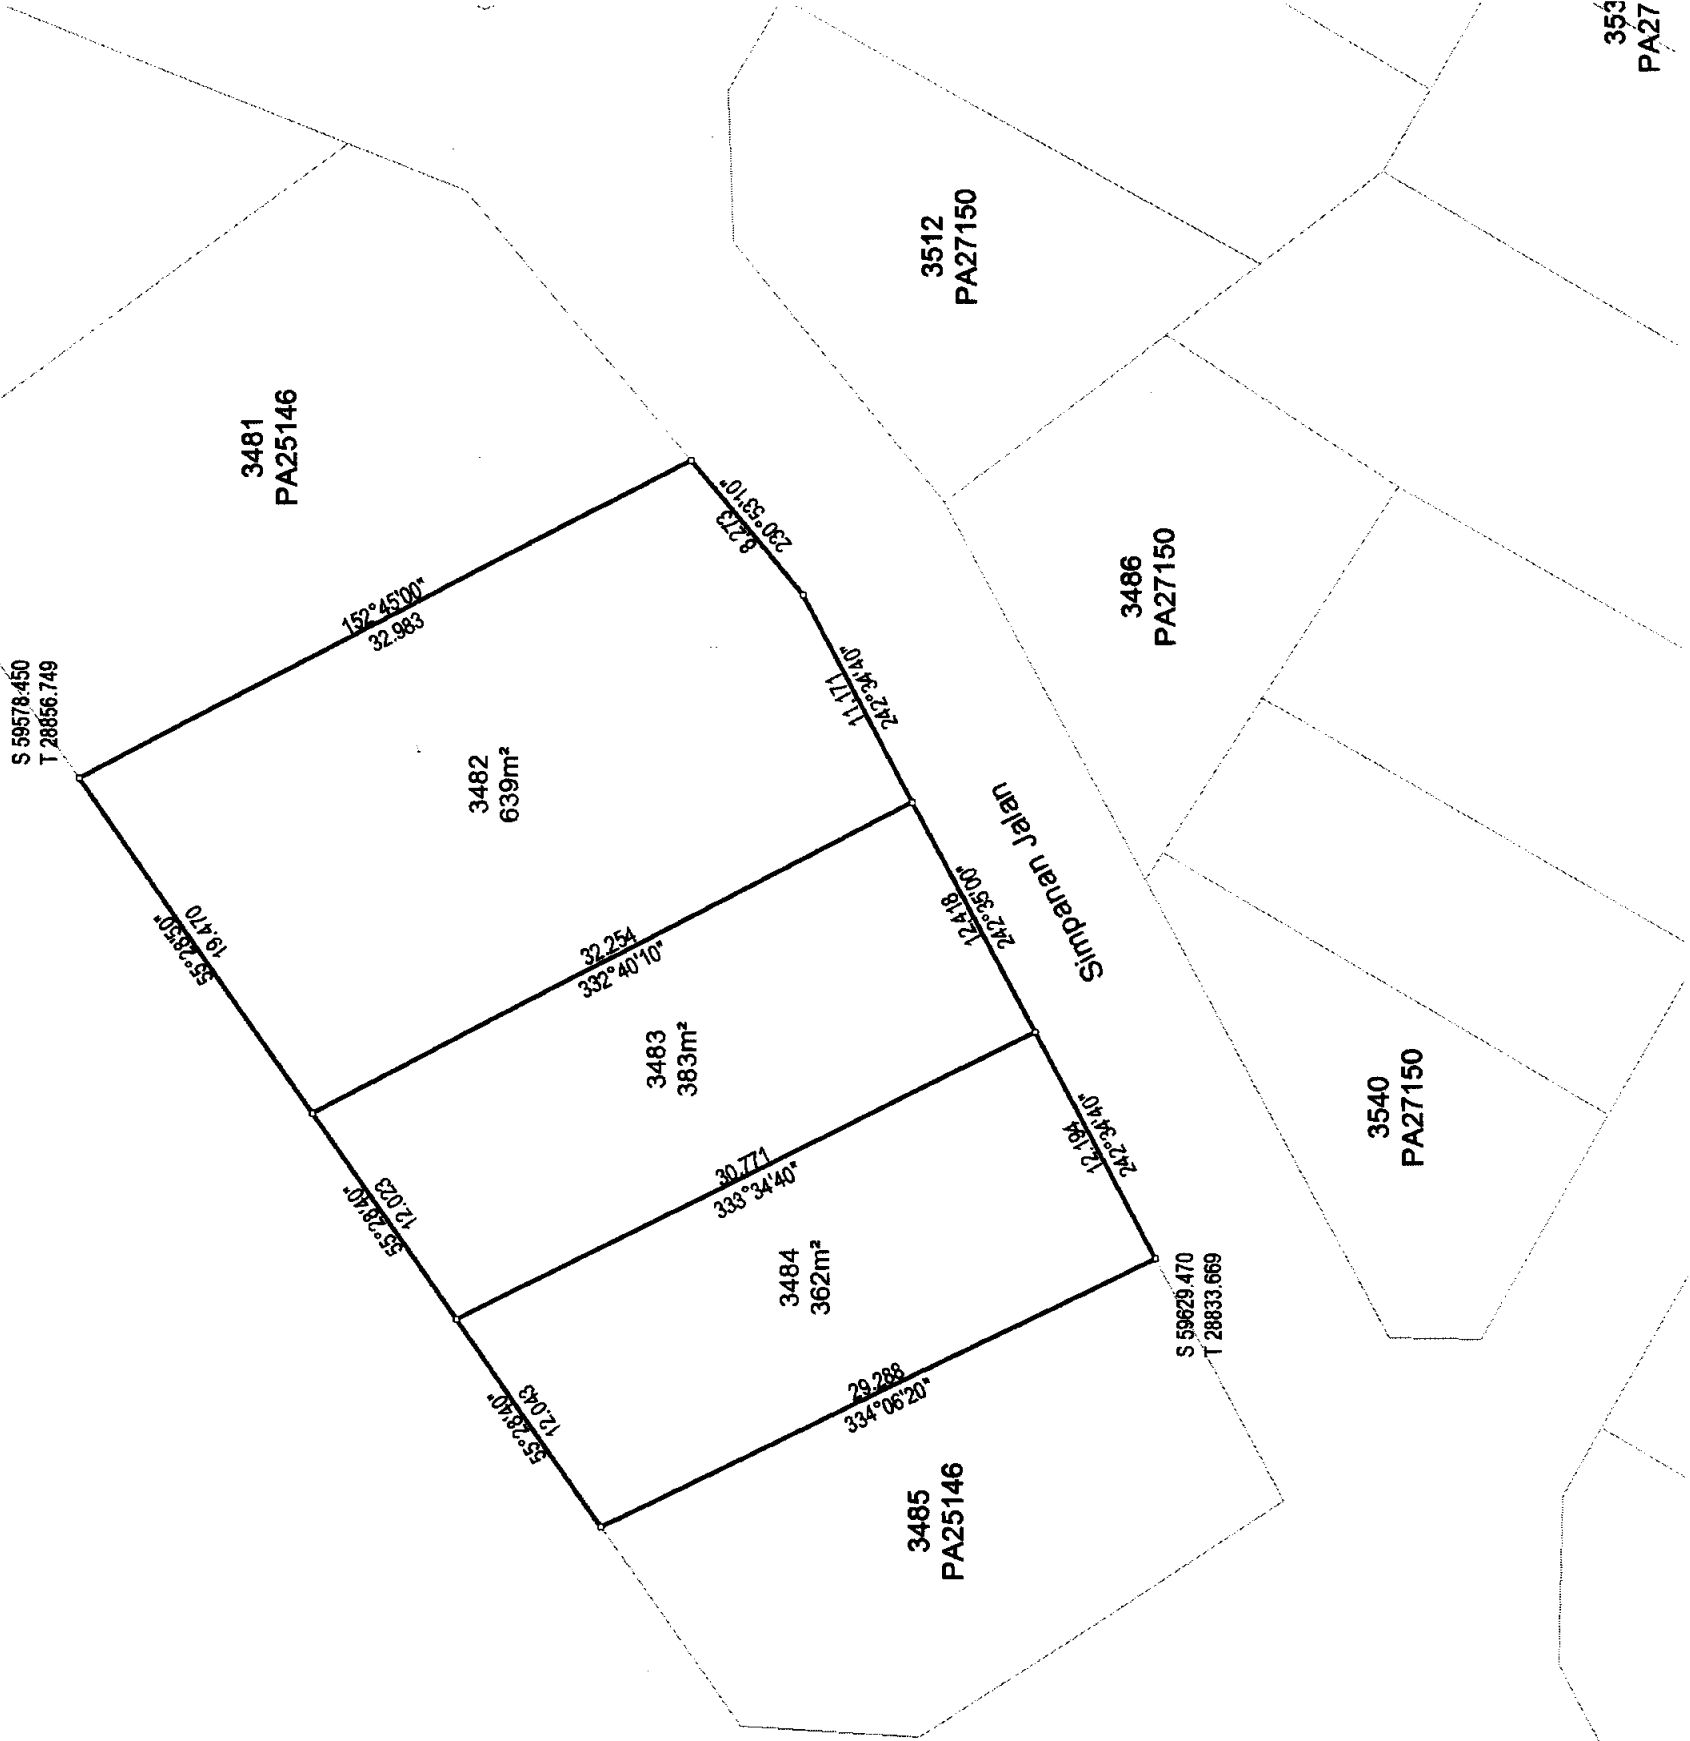

353
PA27

Asas Koordinat GDM2000 Cassini-Soldner

NEGERI SELANGOR

FAIL UKUR PUSEL32_2011

DAERAH ULU LANGAT

FAIL PEJ. TANAH PTD.UL 1/8/268-1990 SJ 53

BANDAR AMPANG SEKSYEN 015

DILULUSKAN OLEH

LOT 3482 - 3484

SKALA 1 : 350

PETA KADASTER 86B

PA212043

Ahmad S.

AHAMAD BIN ZAKARIA
Pengarah Ukur Dan Pemetaan Selangor

Tarikh: 12/07/2013

