


PLAN of Portions 3001 -- 3022 surveyed for issue of title by entry in the mukim register MUKIM OF BATU DISTRICT OF KUALA LUMPUR

Scale Four Chains to an Inch.

Reference		
No.	Bearing	Distance
1	270° 06' 30"	30-0
2	320° 02' 40"	46-67
3	270° 05' 10"	30-0
4	270° 08' 00"	30-0
5	270° 08' 20"	30-0
6	180° 08' 20"	71-44
7	270° 08' 20"	30-0
8	270° 07' 10"	30-0
9	179° 01' 00"	84-61
10	270° 10' 30"	31-70
11	270° 13' 20"	30-0
12	270° 08' 50"	30-0
13	270° 08' 50"	30-0
14	262° 31' 40" Cal.	407-1 Cal.
15	176° 54' 20"	30-4
16	269° 30' 30"	225-9
17	270° 10' 20"	190-3
18	268° 13' 00"	102-0
19	332° 21' 00"	56-27
20	42° 35' 30"	41-45
21	89° 54' 20"	30-02
22	358° 03' 20"	306-2
23	82° 43' 20"	30-13
24	358° 03' 20"	331-3
25	88° 03' 20"	30-0
26	173° 55' 50"	78-38
27	88° 23' 20"	36-10
28	173° 55' 50"	258-4
29	179° 50' 40"	86-32
30	88° 23' 30"	53-98
31	179° 50' 40"	356-1
32	88° 22' 30"	44-96
33	179° 50' 40"	331-2
34	91° 16' 40"	36-60
35	179° 50' 40"	258-4
36	58° 34' 50"	34-73
37	359° 02' 50"	175-6
38	358° 50' 40"	216-3
39	88° 50' 40"	29-38
40	358° 50' 40"	331-8
41	88° 50' 40"	35-06
42	358° 50' 40"	233-9
43	1° 48' 10"	38-15

CO-ORDINATES

Origin - N. end Selangor Base Meridian of Bukit Asa		
	N	W
C	3670'3	35997'1
D	S 148'4	37854'9

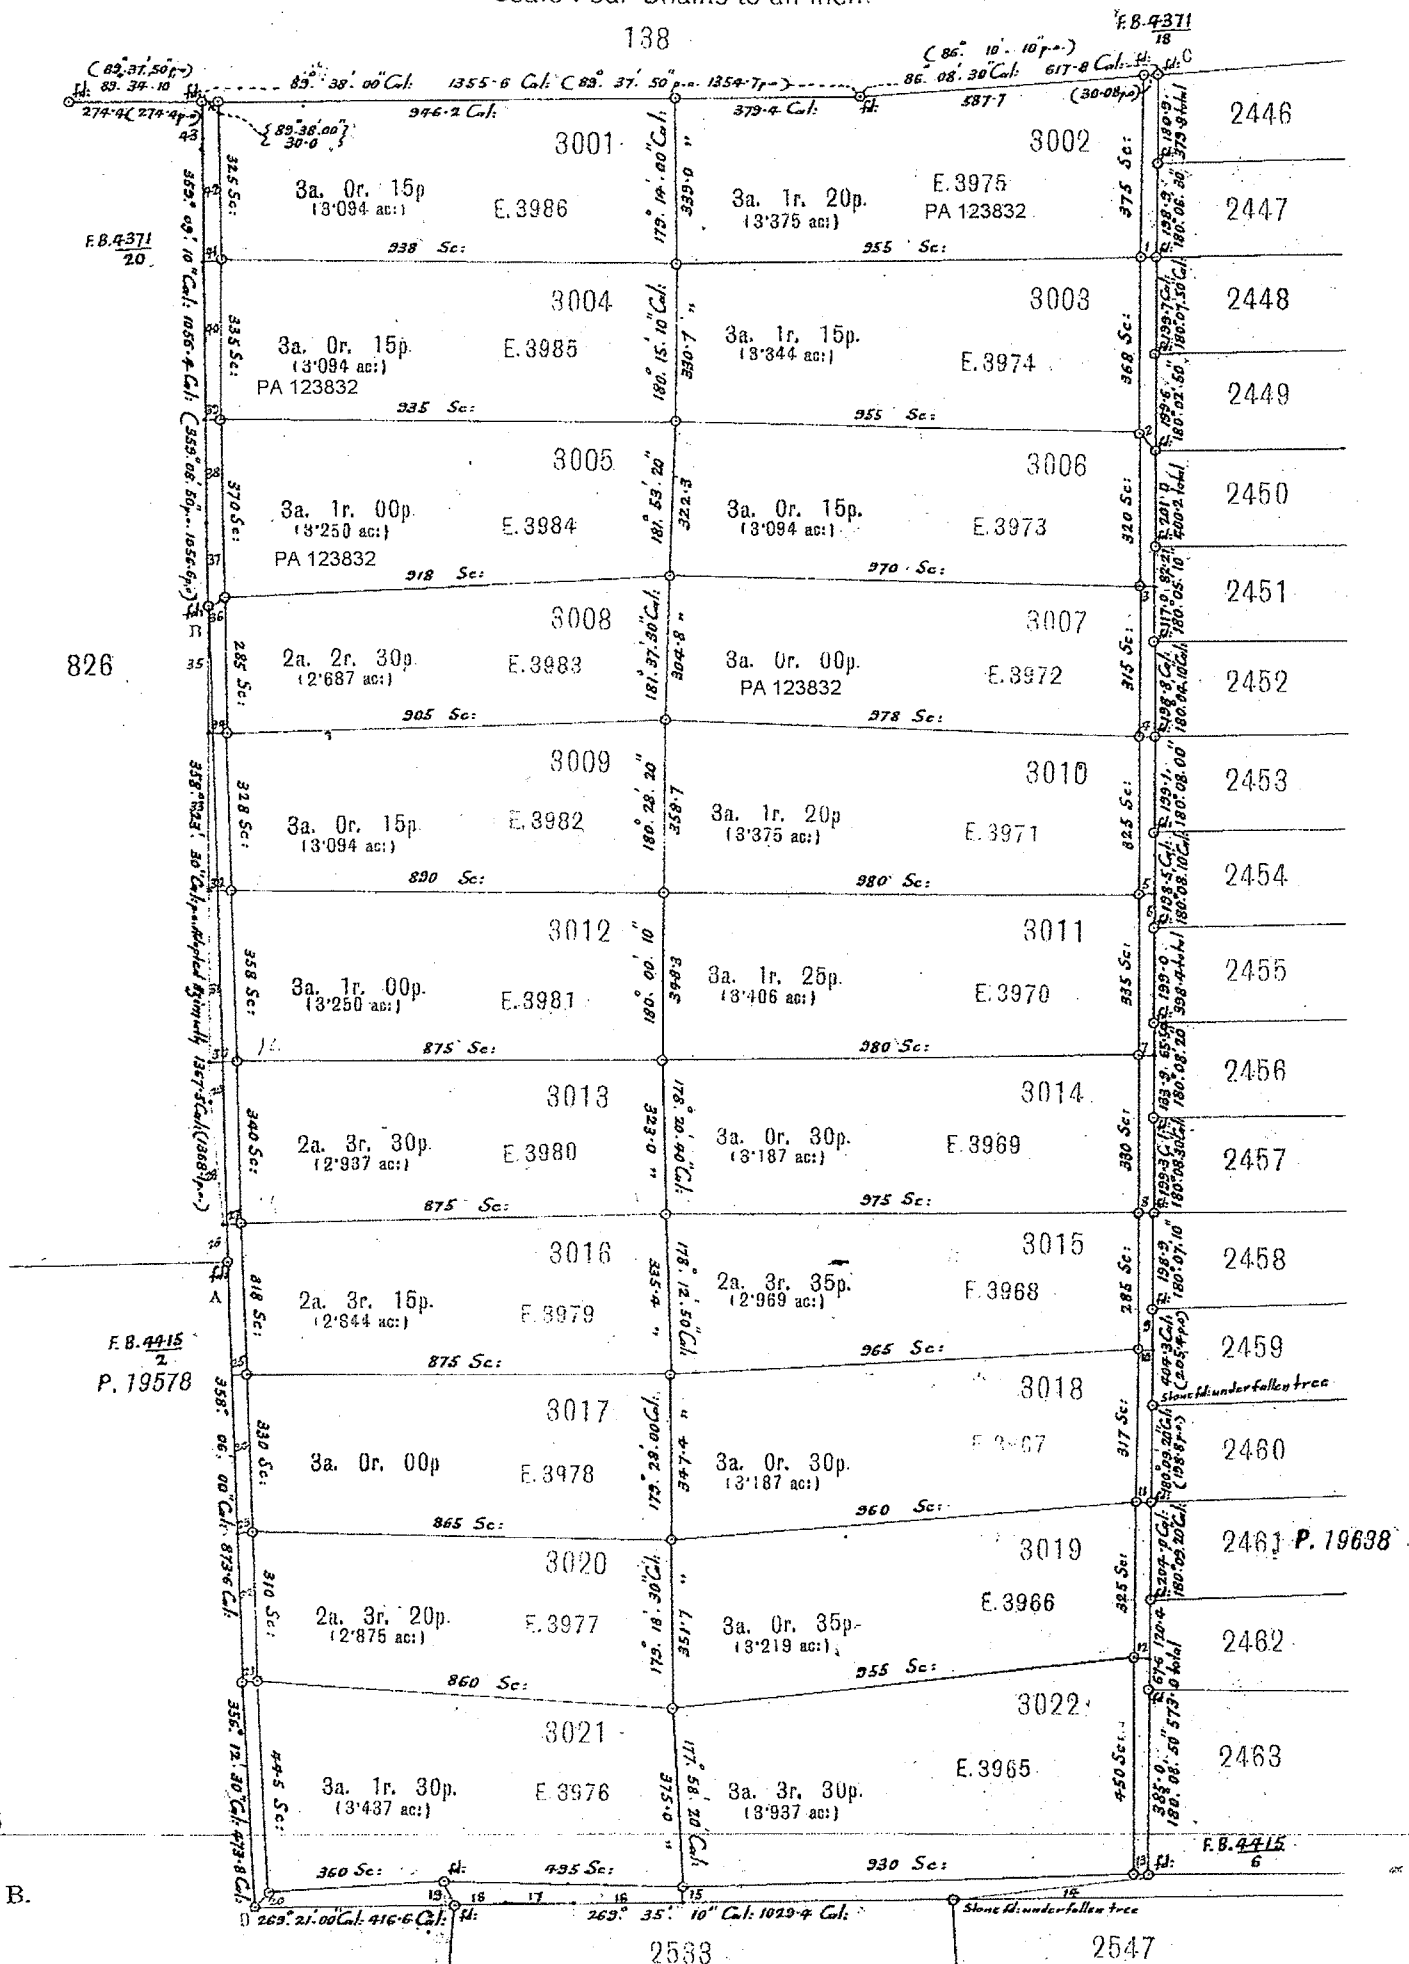

Azimuth taken from A. B.

Third Class Survey

I hereby certify that I have examined the boundaries delineated on this plan and that they are correctly located on the ground and marked as shown hereon.

Surveyed by Mr. Yap Kin Loon.

Raja Cusna
Settlement Officer.

Examined by

adg. building
District Surveyor.

Survey Paper No. 760-16

Plan approved

Field Book 4371 pages 17 to 20
4415 " 1 to 12

Cal. Book Vol. 104 P 37

Sheet No. **G 15 & 21.**
A-85 & C77.

Plan No.

11845.

Cal. Book Vol. 188 p. 78