


LOT 485 SECTION 47 (See Note)
TOWN OF KUALA LUMPUR
DISTRICT OF KUALA LUMPUR

Scale One Chain to an Inch

Note:- Lot 485 comprises part of Lot 12 (C.P. 79)

I, TAN TOCK YONG, a surveyor licensed under the Licensed Land Surveyors Ordinance No. 11 of 1958, certify that the survey from which this plan has been prepared was carried out and marked on the ground by me or under my immediate personal direction and supervision in the field in strict accordance with the Licensed Land Surveyors Regulations, and that this plan correctly represents that survey completed on the 20th day of August 1968.
Dated this 4th day of June 1969.

Tan Tock Yong
Surveyor,
Licensed under Ordinance No. 11 of 1958

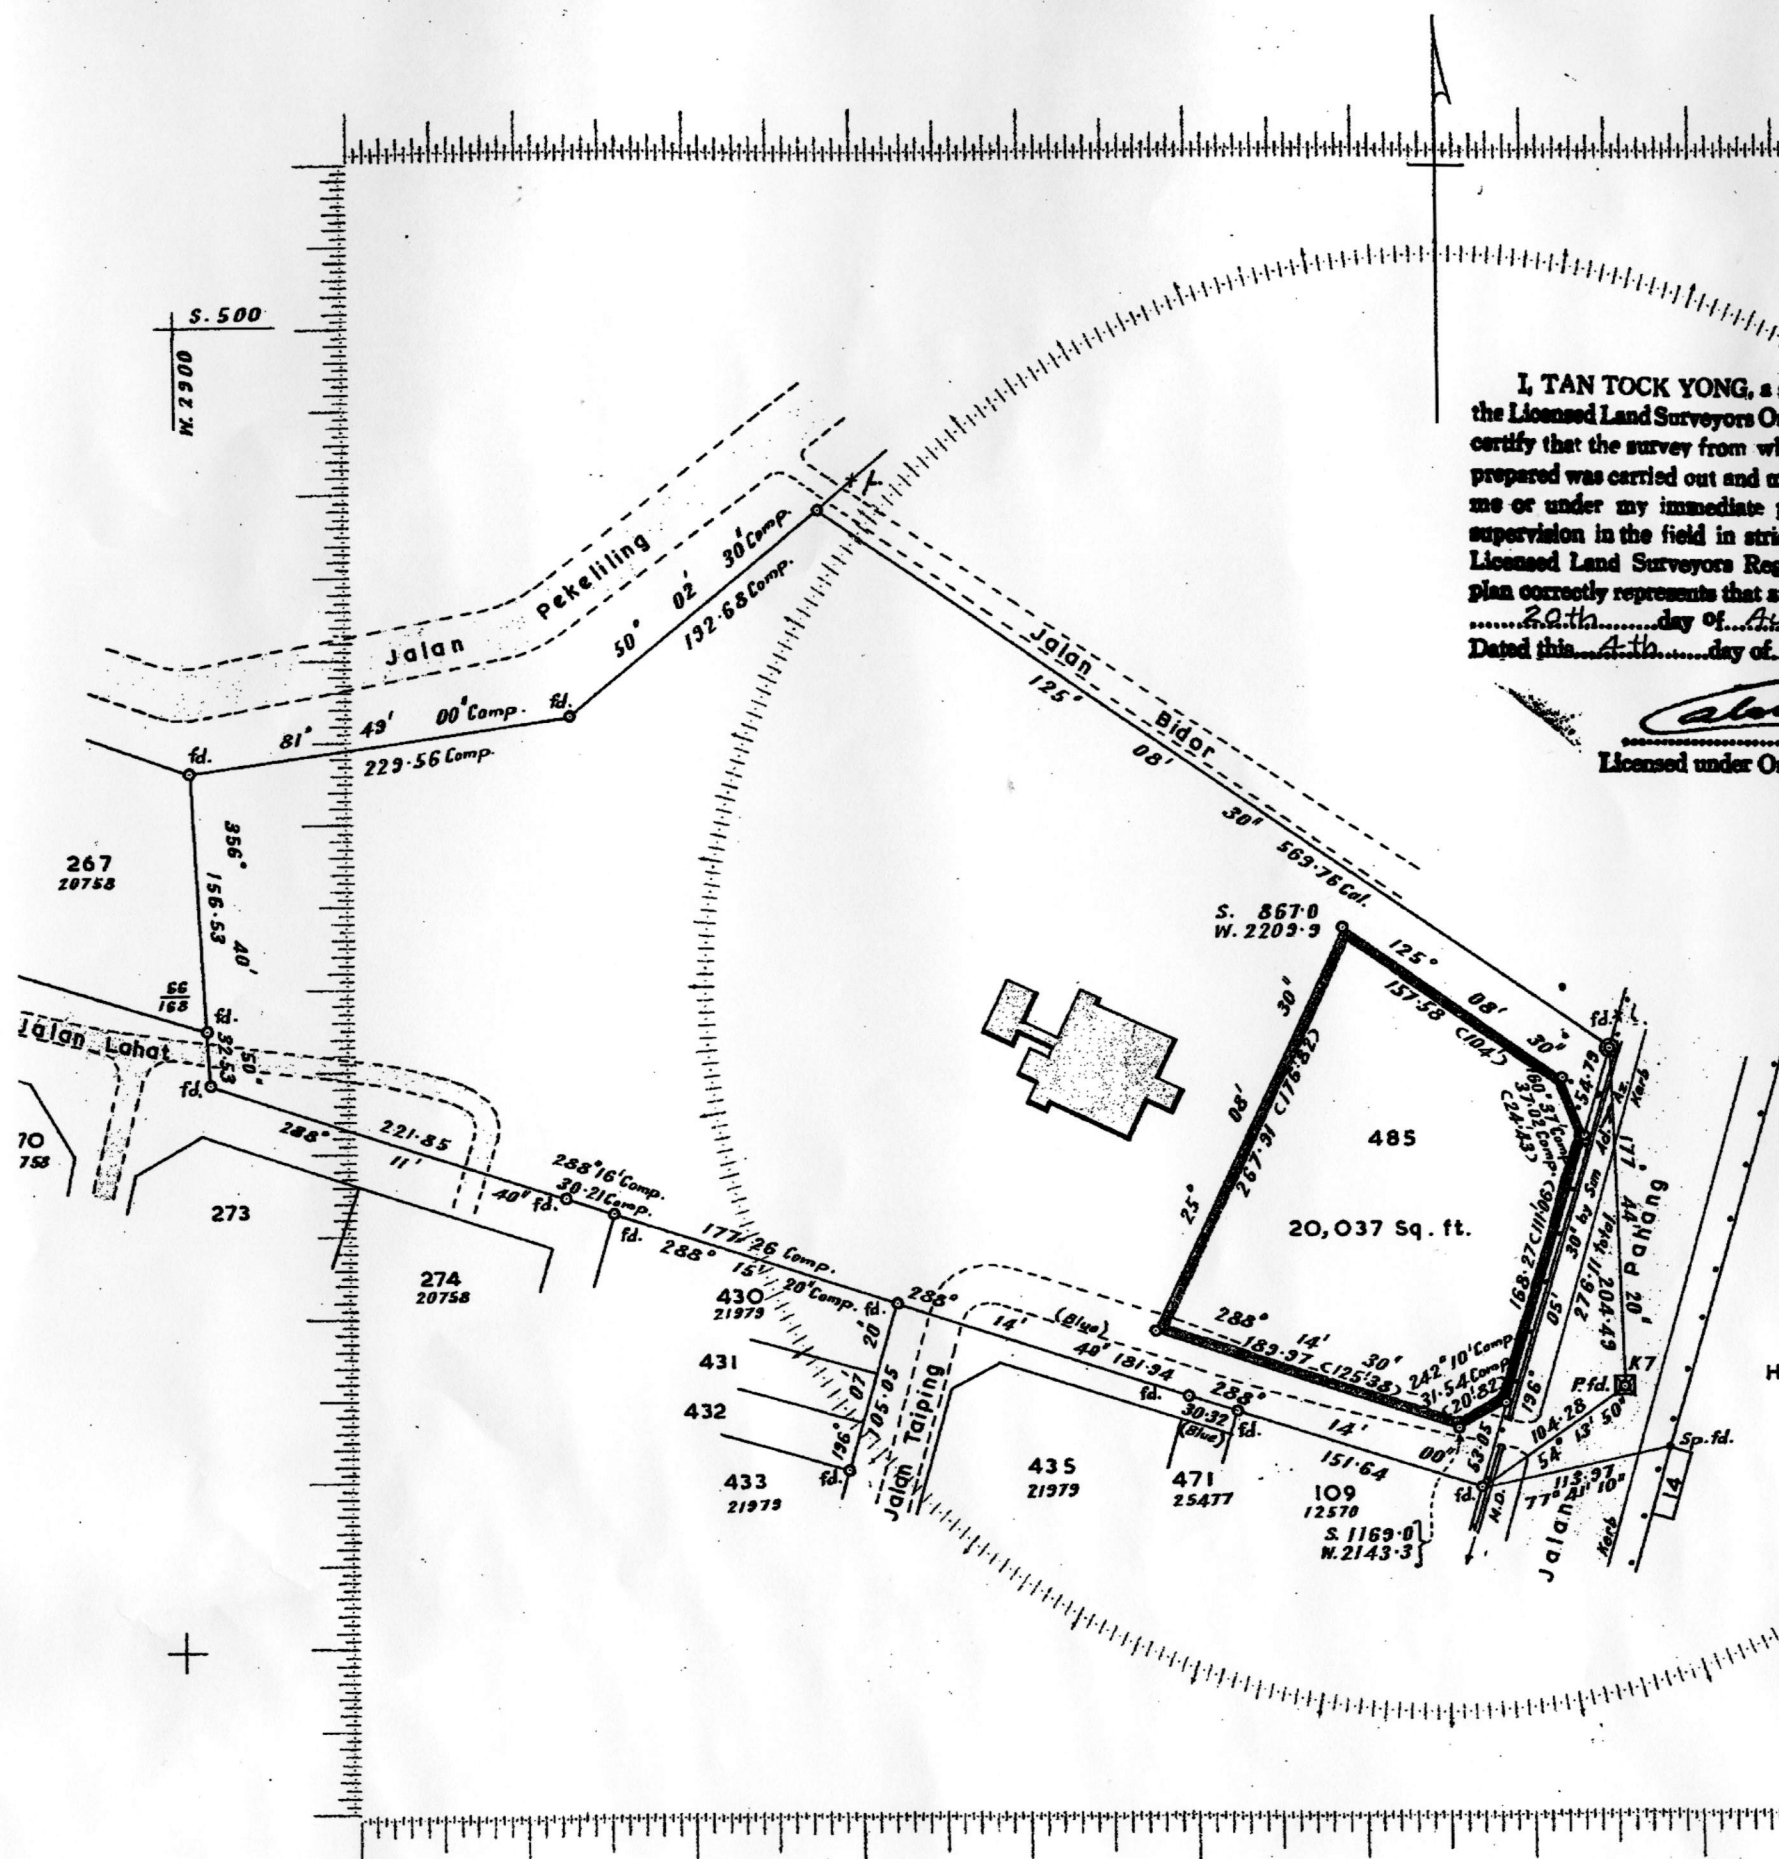

Std. Sheet 85-B-II-4

Svy. Ref. P.U. BL. Sel. 88-68

L. O. Ref. P.H.T.K.L. 2-6854

Cal. Vol. 465 pp. 77 & 78

Surveyed by Tan Tock Yong

Field Book 17628

First Class Survey

Examined by *D. B. B.*
23.6.70

July Approved *Paul M.*
8.7.70

S. 1300
N. 1700

C.P. 25988