




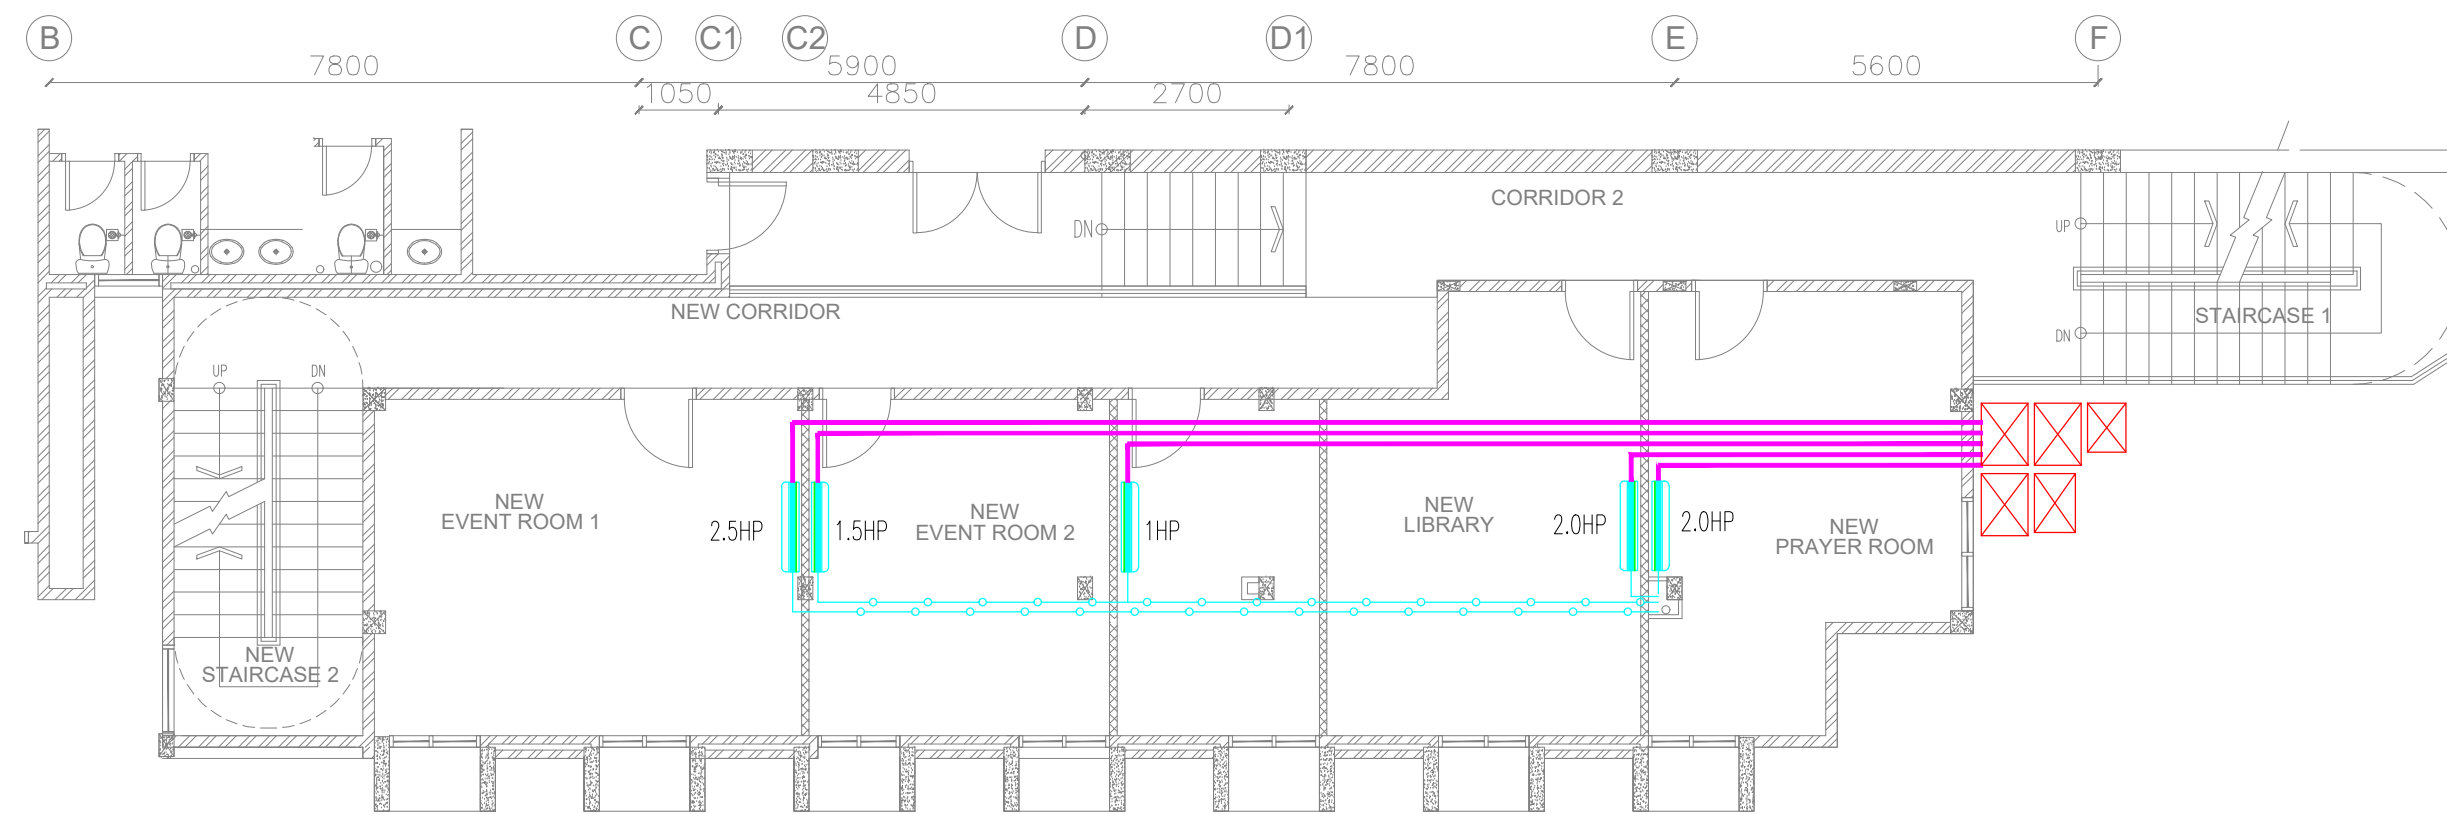


FIRST FLOOR PLAN
SCALE = 1 : 100 (A3)

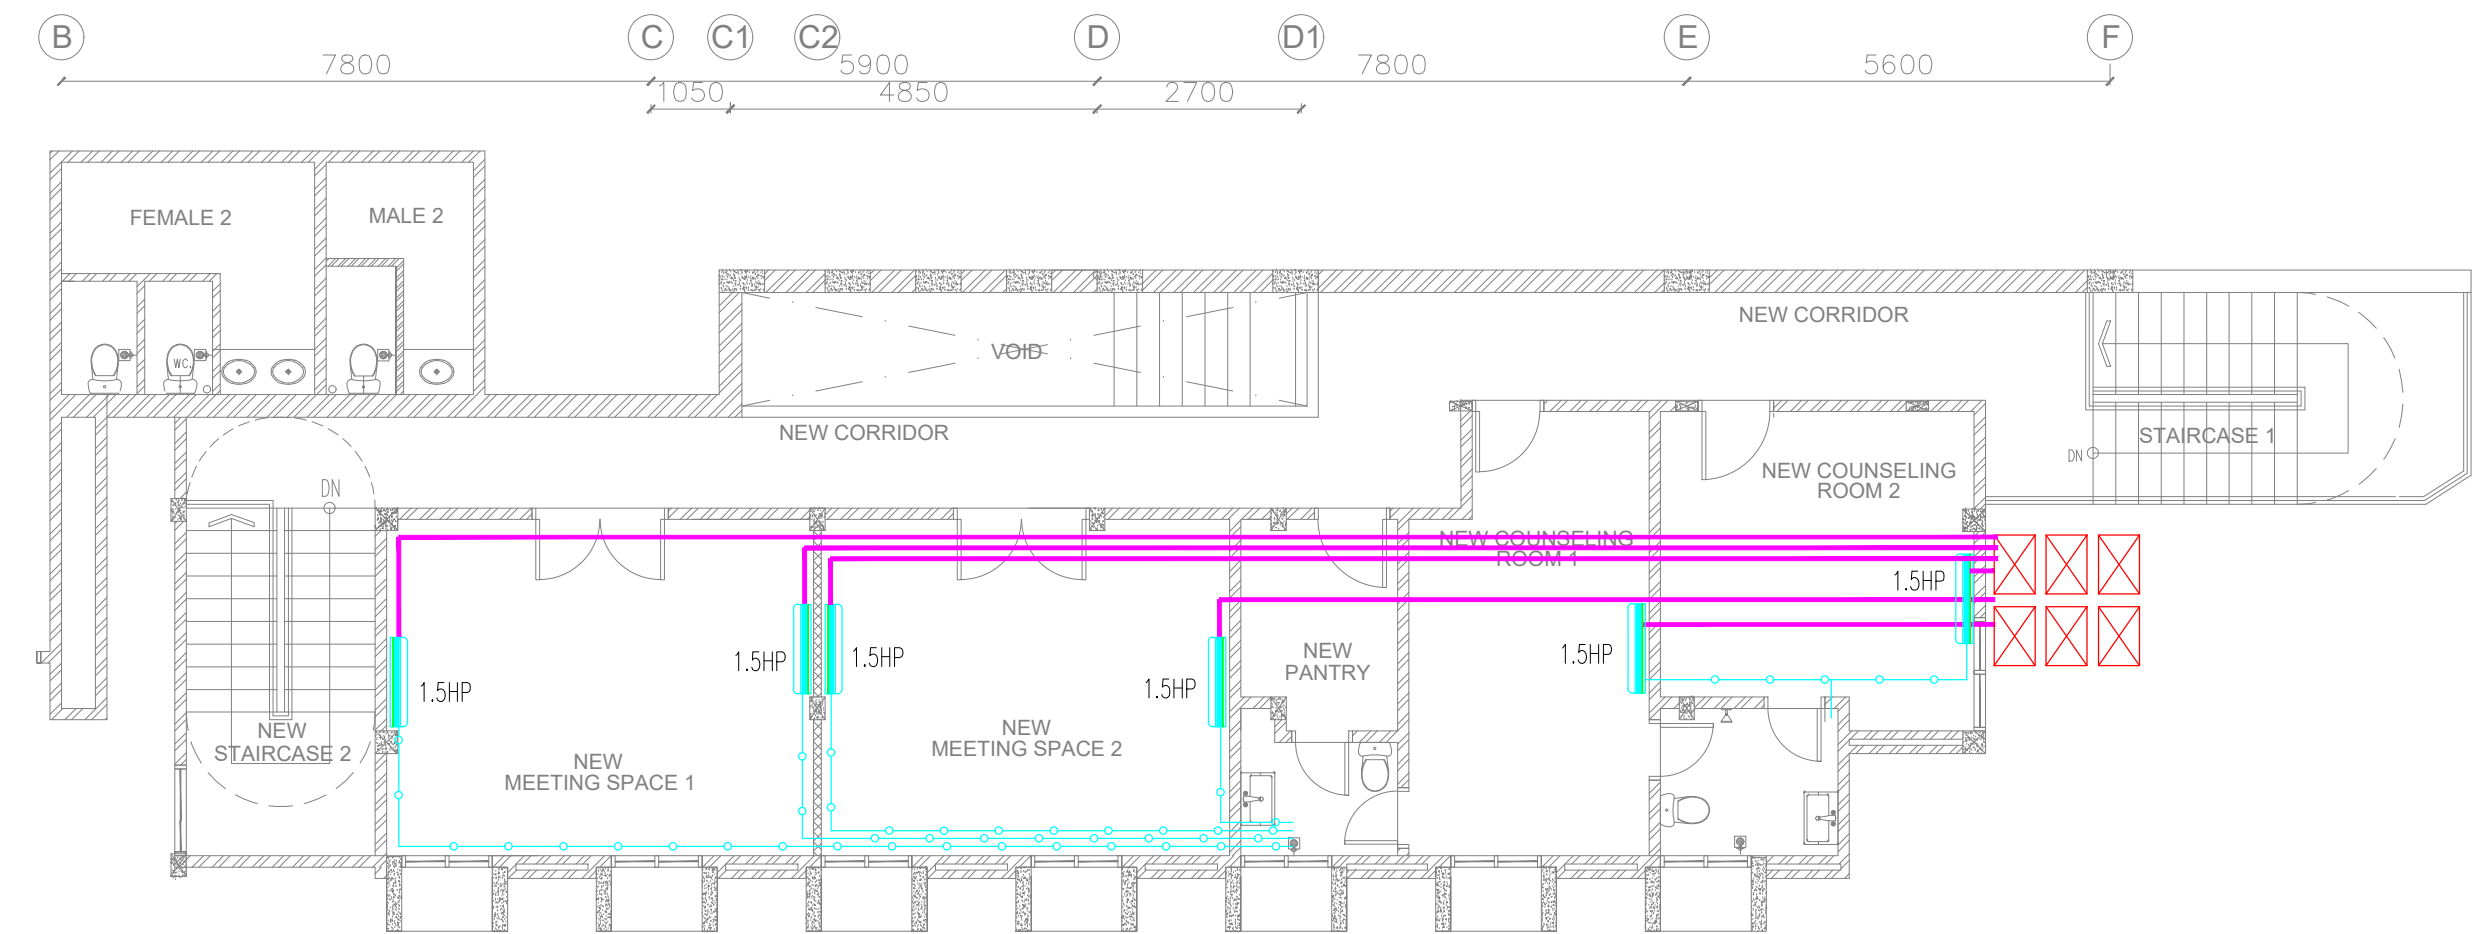


SECOND FLOOR PLAN
SCALE = 1 : 100 (A3)

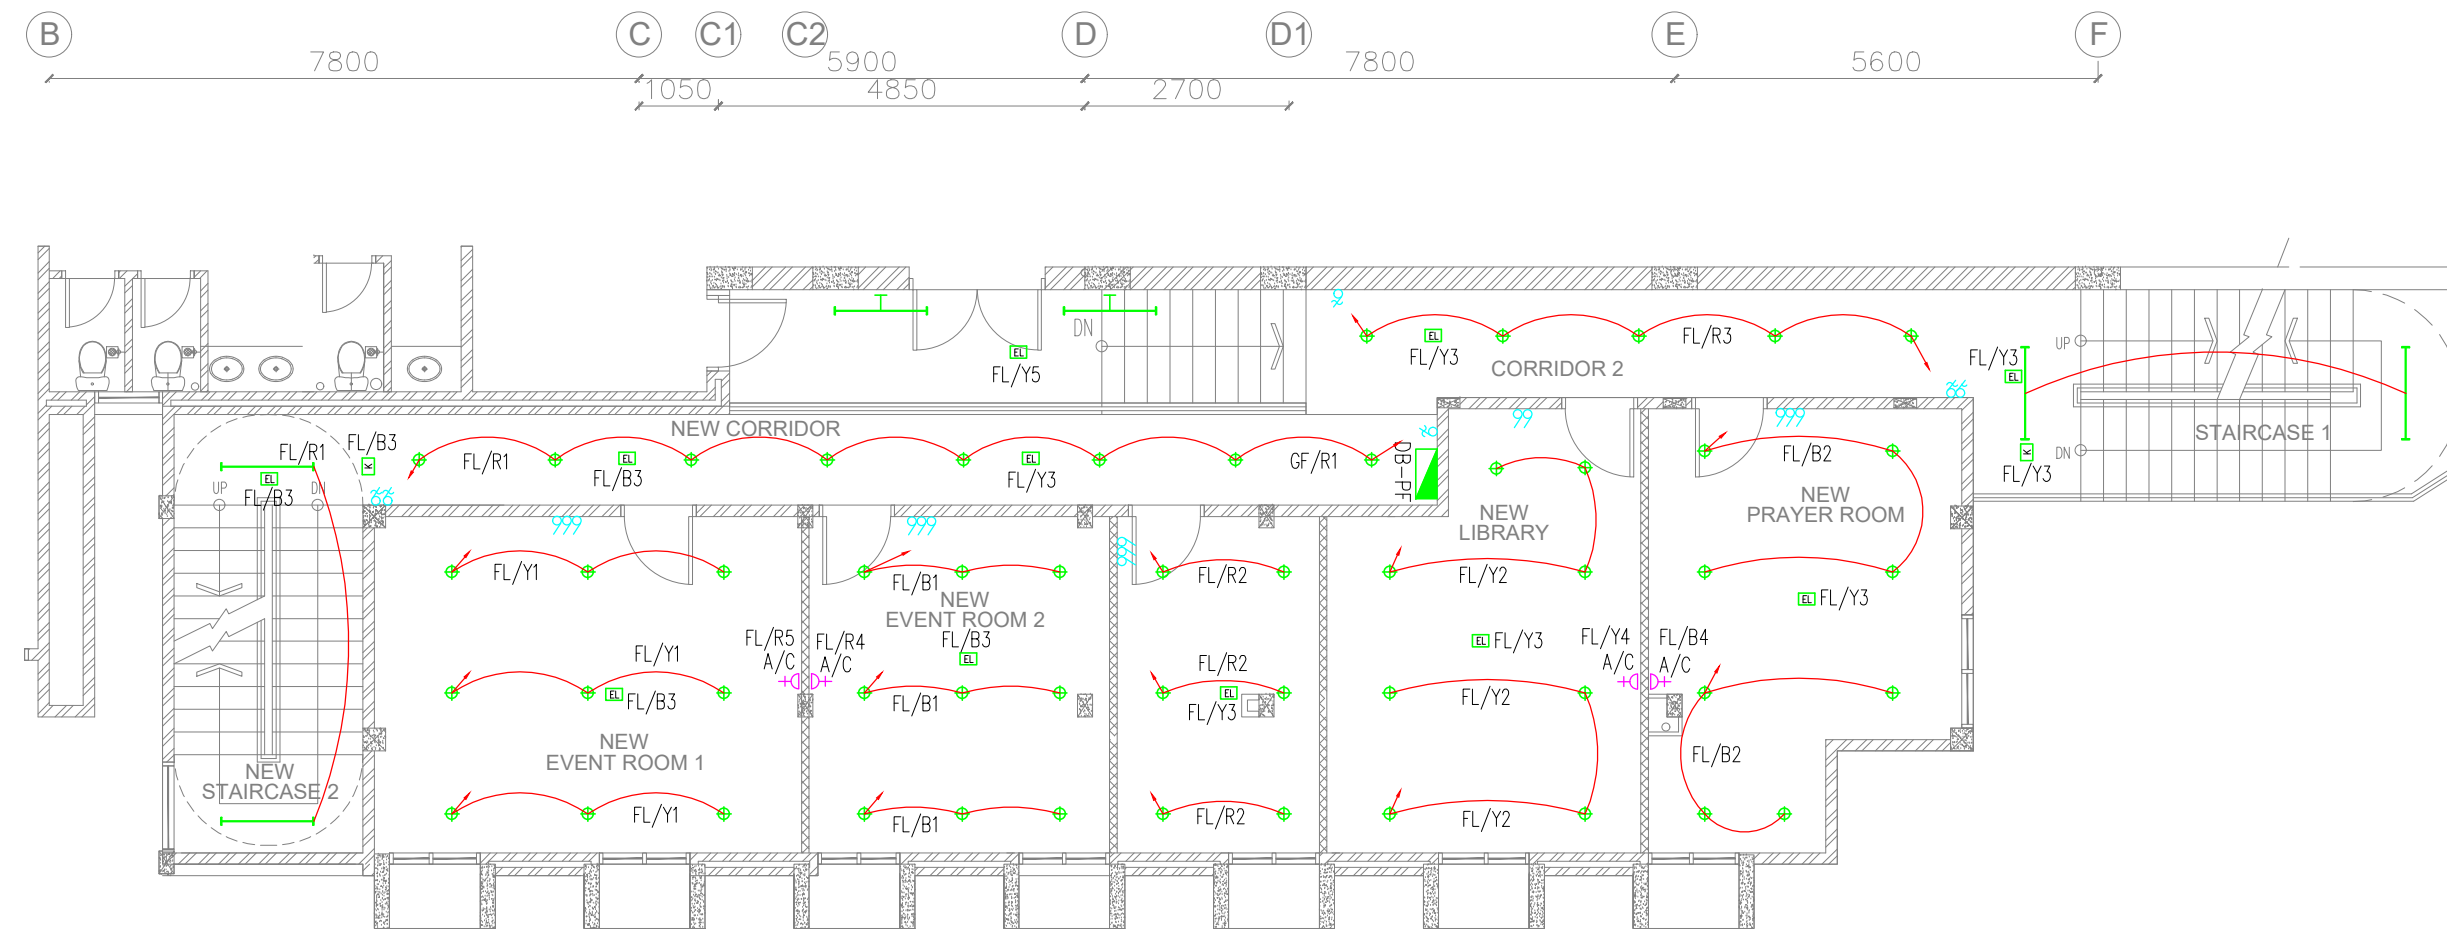


FIRST FLOOR PLAN
SCALE = 1 : 200 (A3)

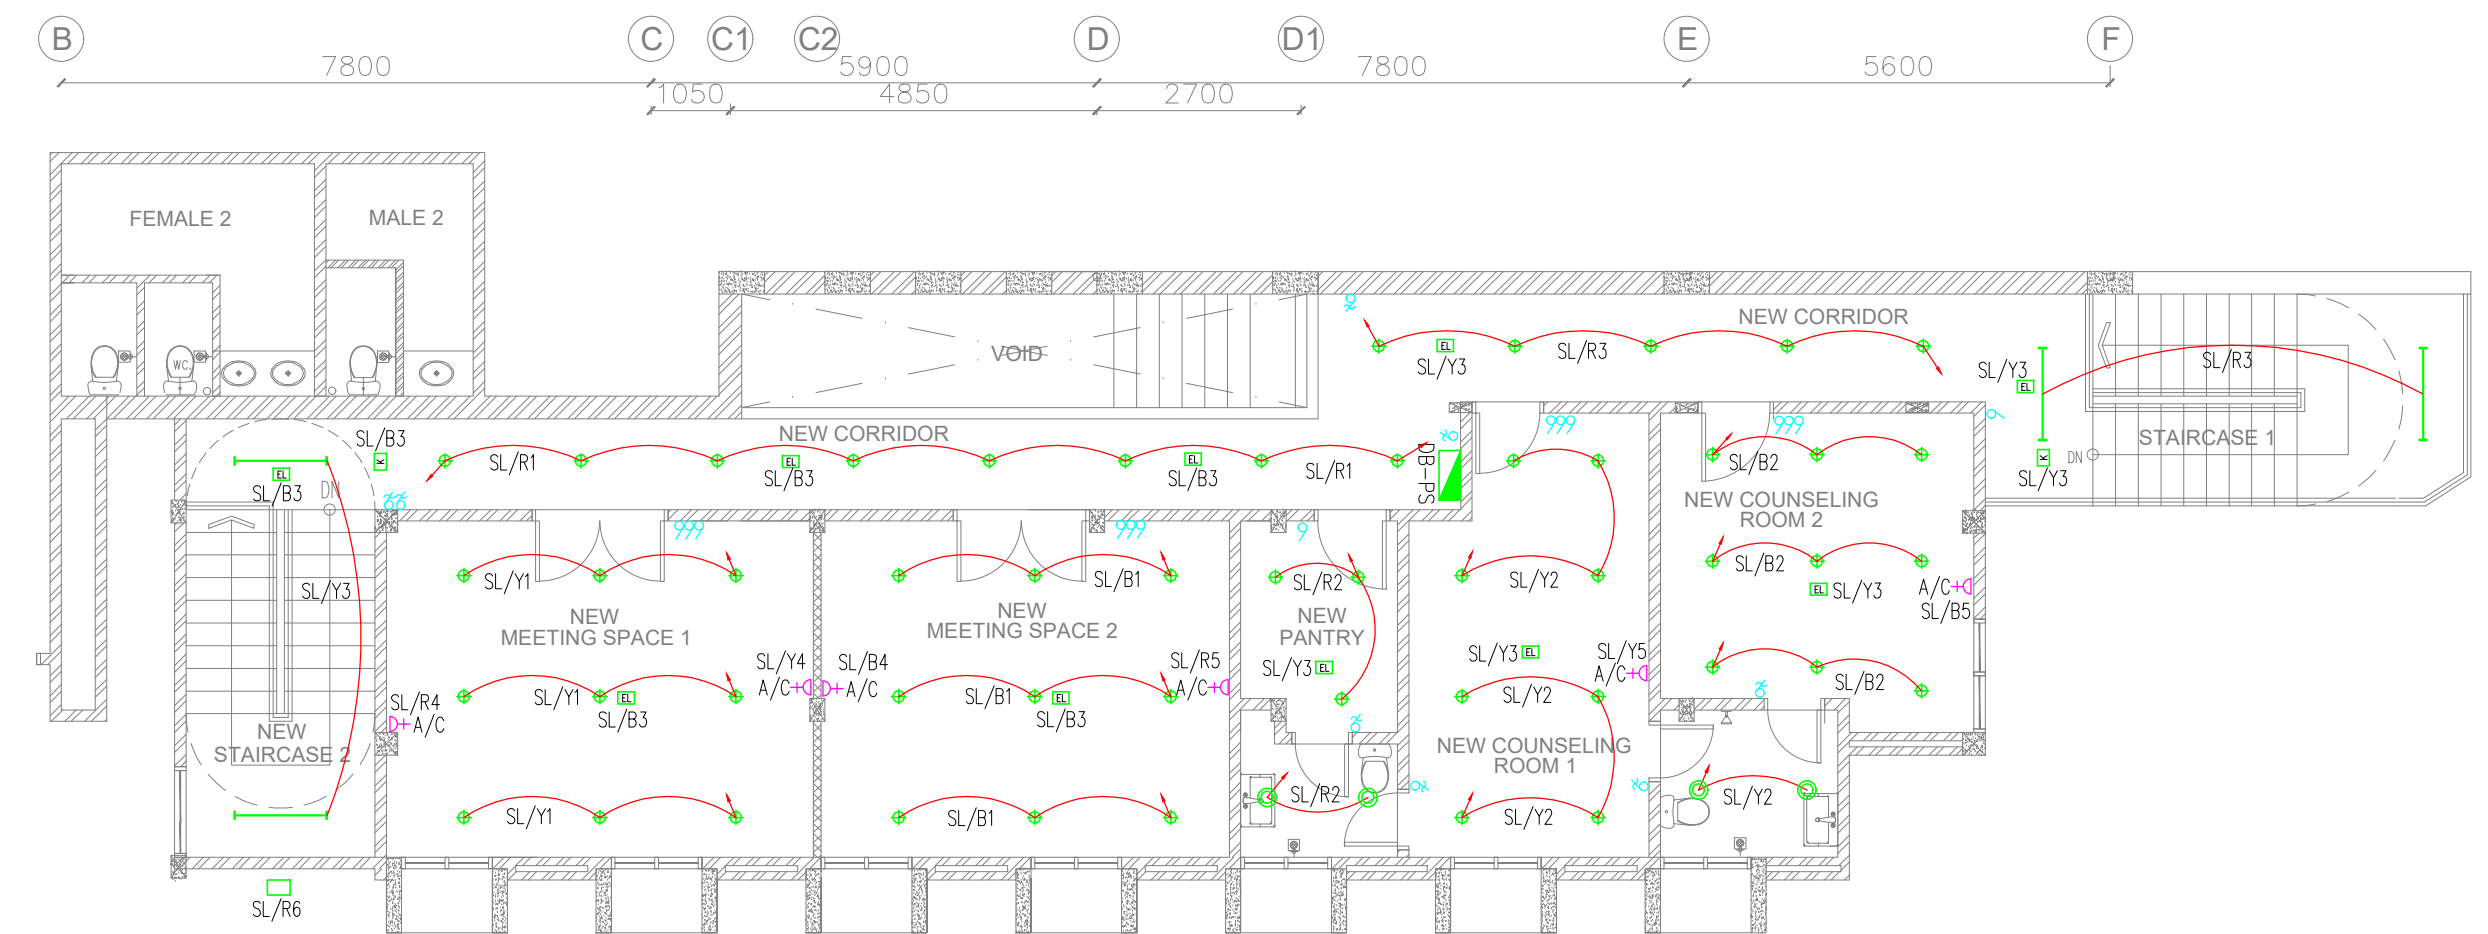


SECOND FLOOR PLAN
SCALE = 1 : 100 (A3)

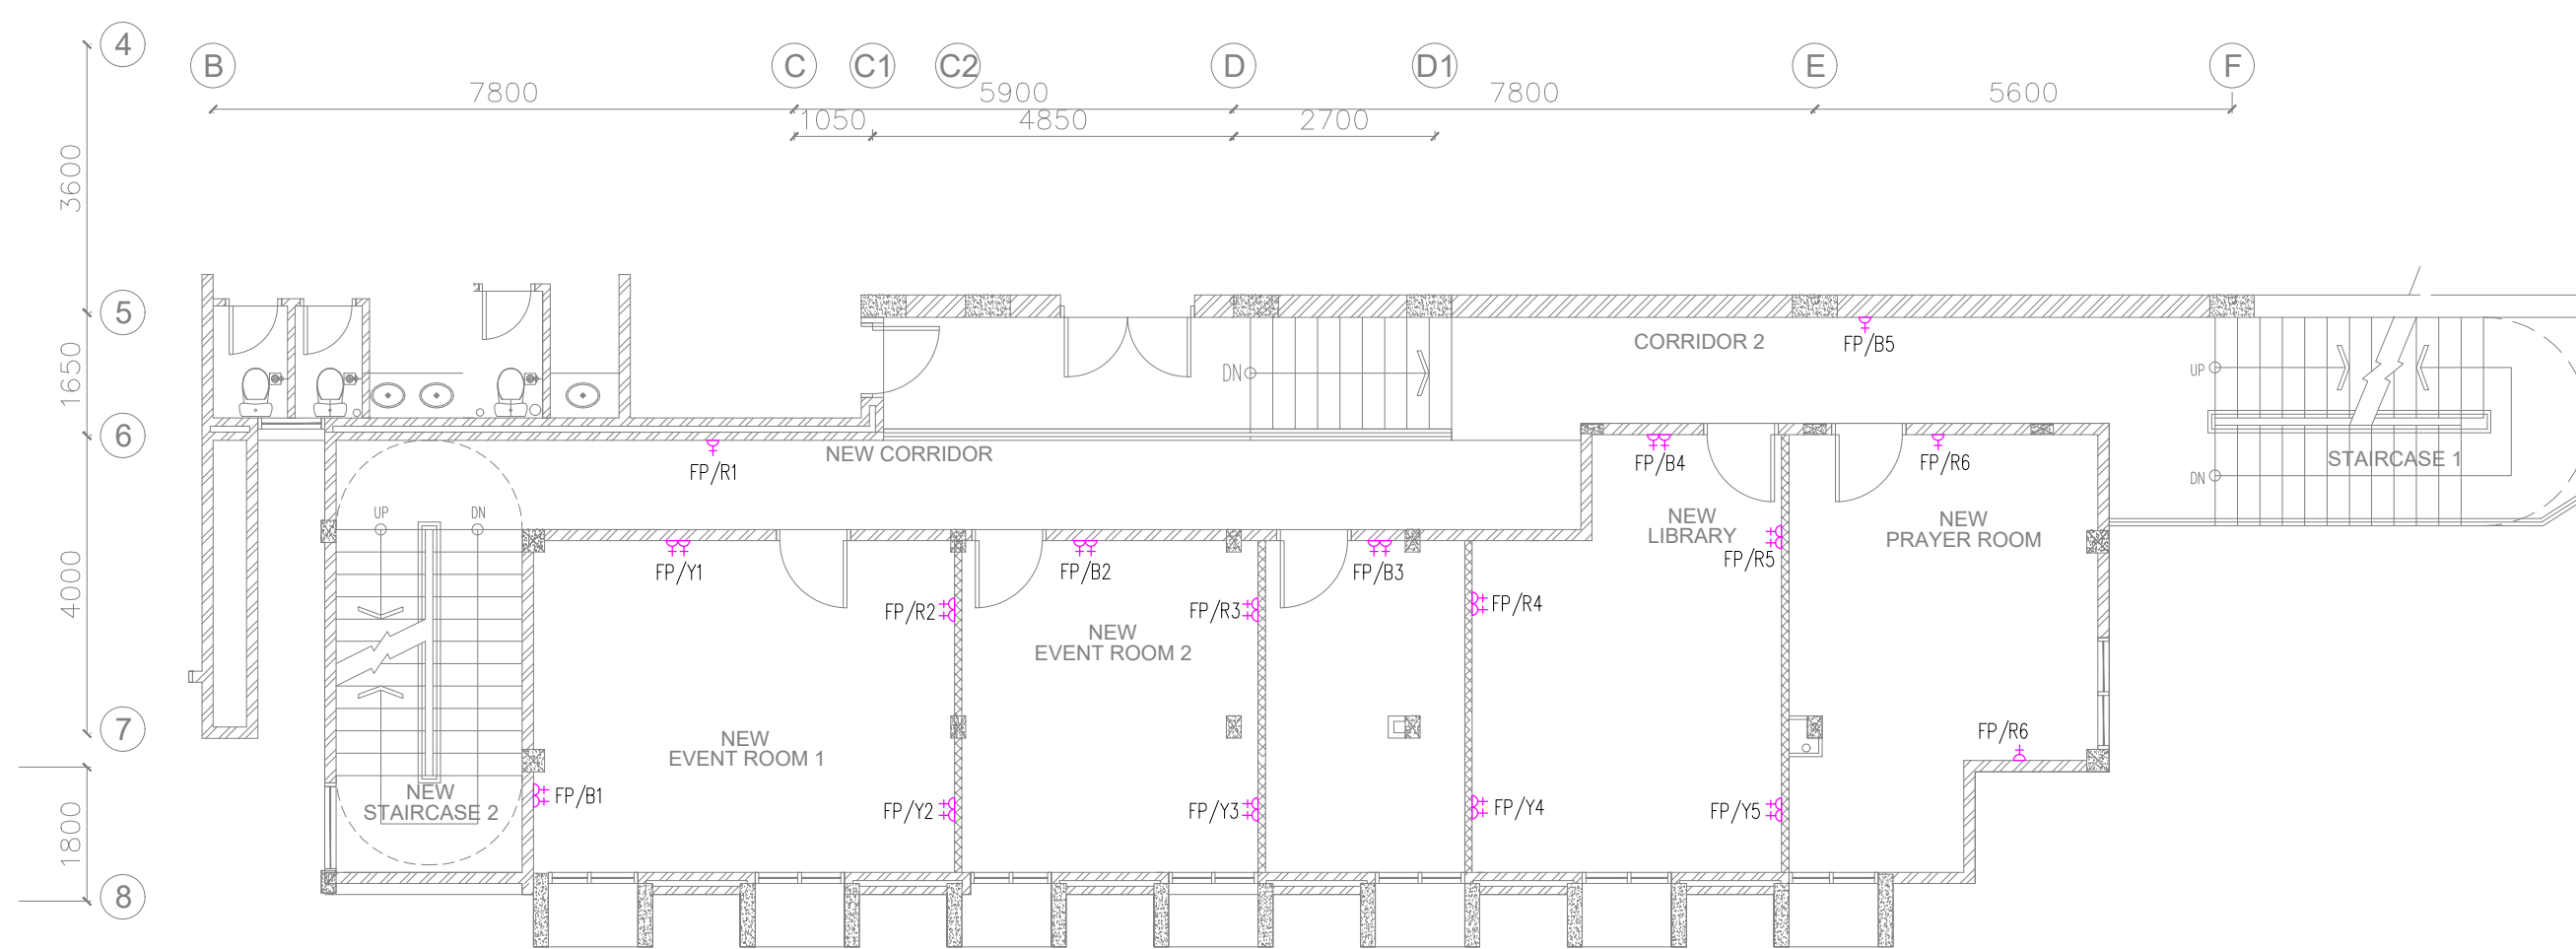

FIRST FLOOR PLAN
SCALE = 1 : 200 (A3)

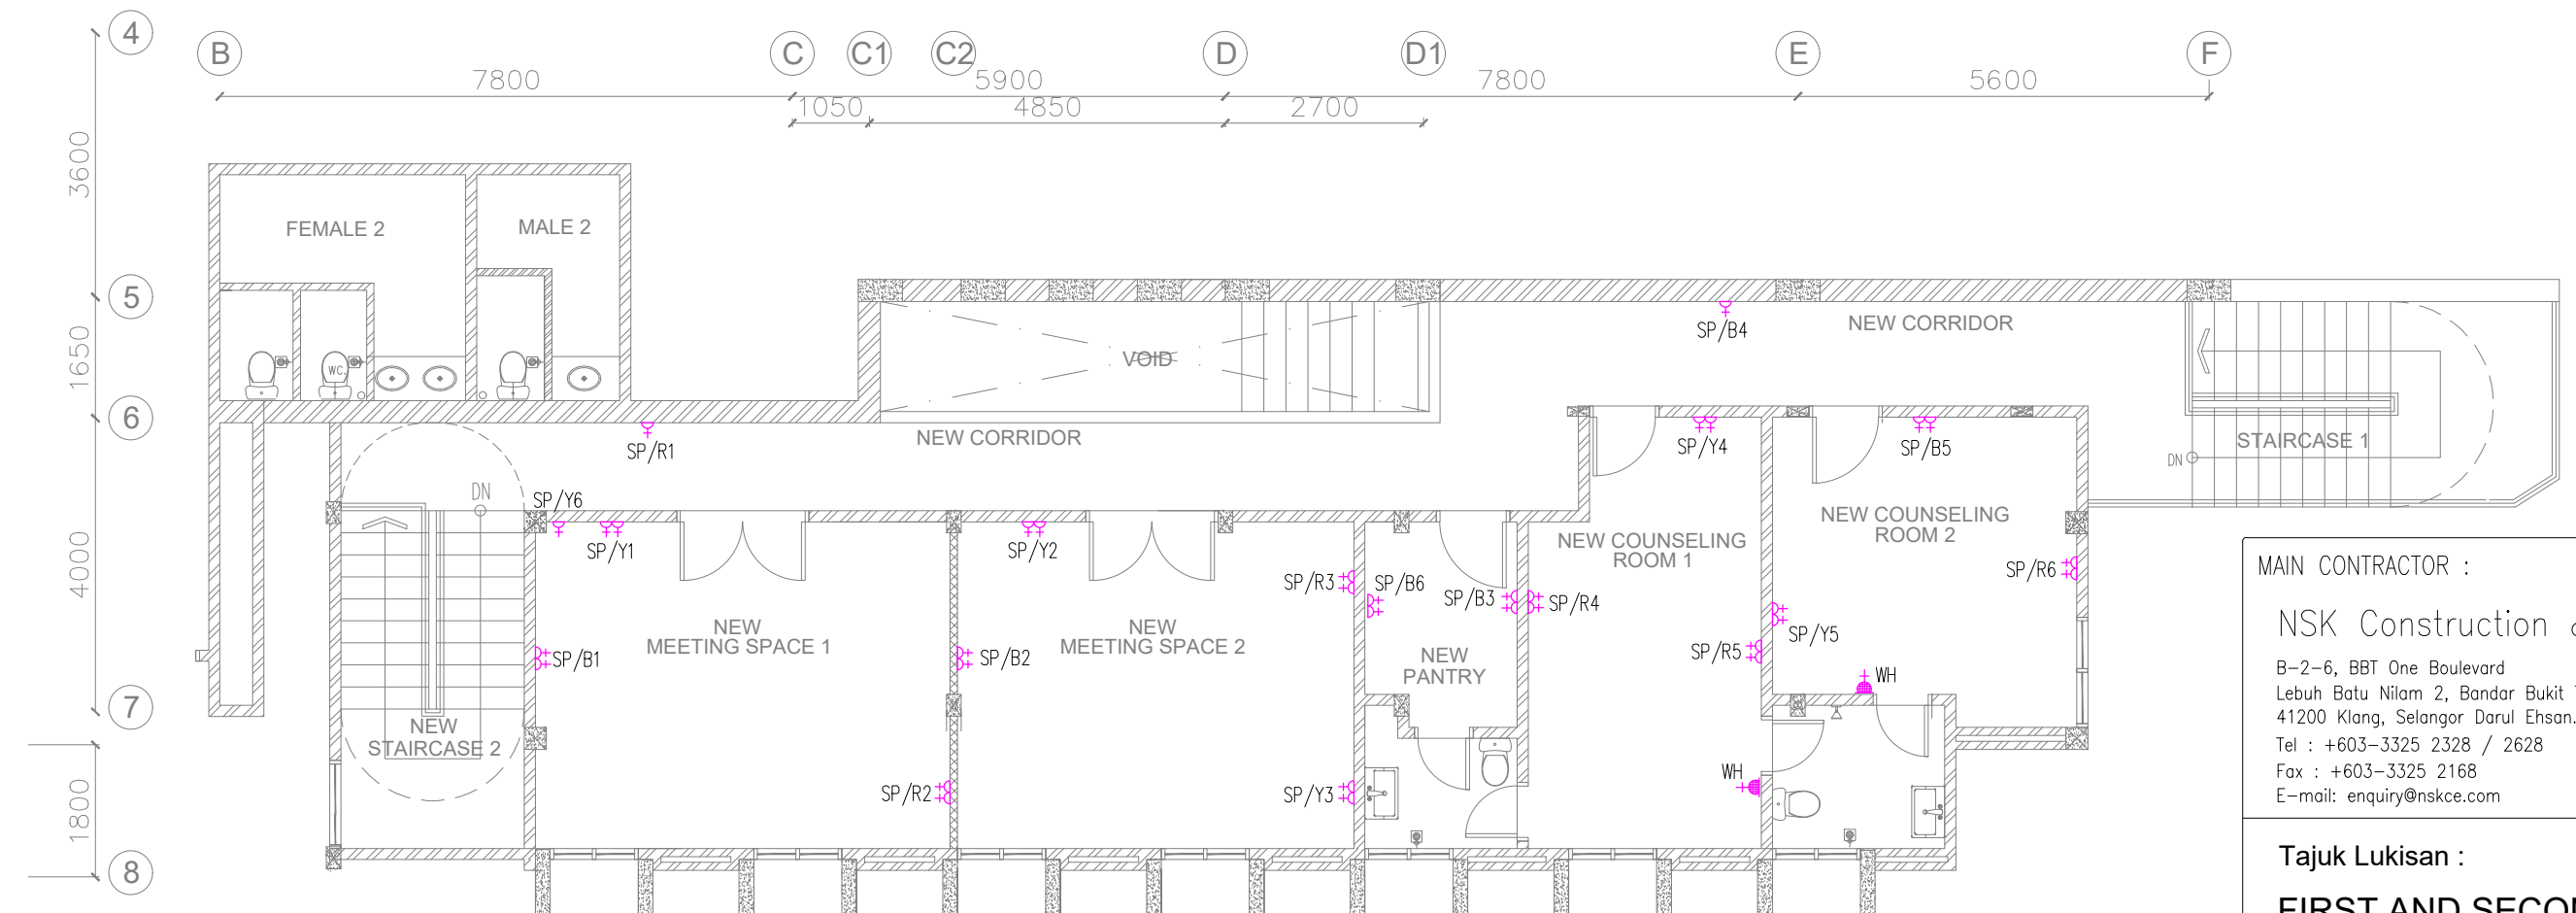

SECOND FLOOR PLAN
SCALE = 1 : 100 (A3)

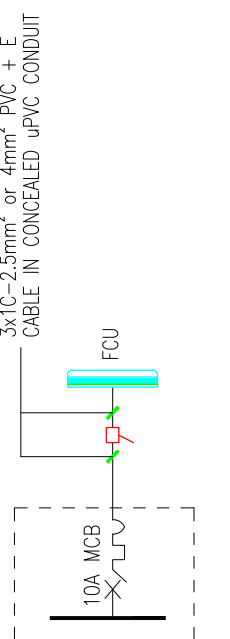

MAIN CONTRACTOR :
NSK Construction & Engineering Sdn. Bhd.
B-2-6, BBT One Boulevard
Lebuhr Batu Nilam 2, Bandar Bukit Tinggi,
41200 Klang, Selangor Darul Ehsan.
Tel : +603-3325 2328 / 2628
Fax : +603-3325 2168
E-mail: enquiry@nskce.com

Tajuk Lukisan :
FIRST AND SECOND FLOOR PLAN
LIGHTING, POWER POINT & AIR COND LAYOUT

Tarikh : April 2023	Dilukis Oleh : Teoh
Ukuran : 1 : 100	Disemak Oleh : Ng
Projek No: JCY/18043/E-2A	Bil. Lukisan : -

AS BUILT DRAWING
APRIL 2023