



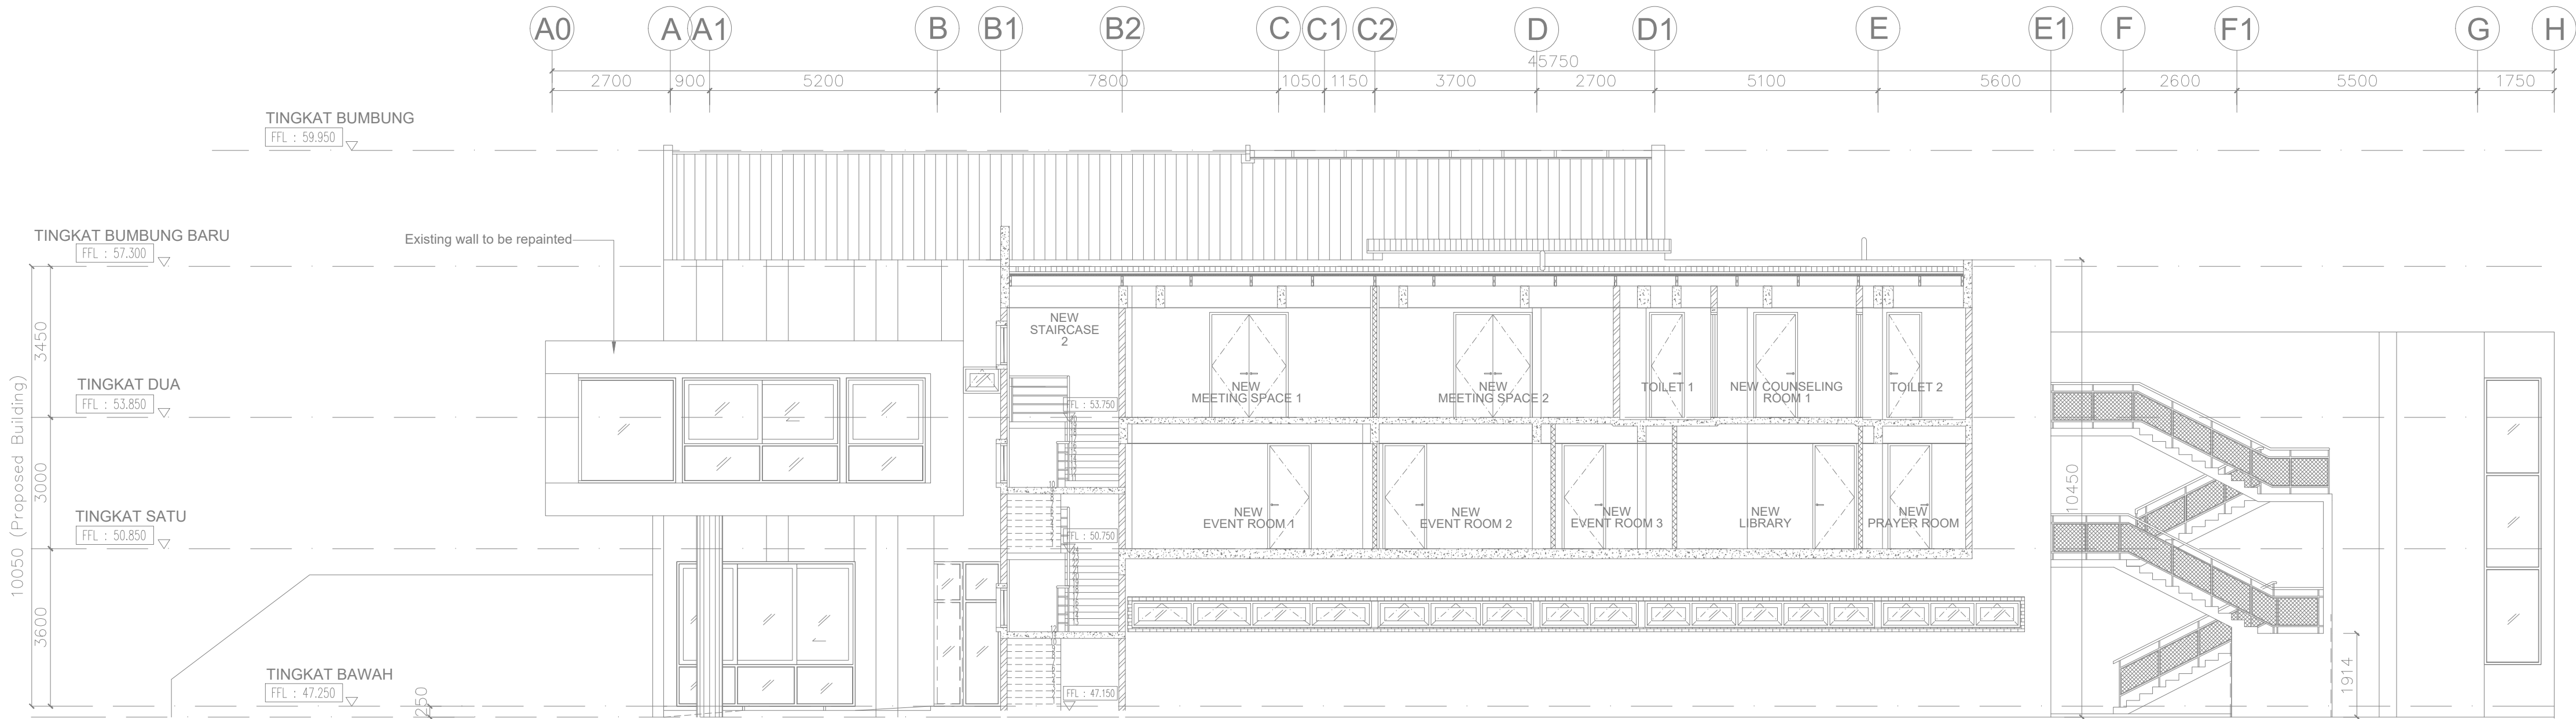

SECTION Y1-Y1
SCALE = 1 : 200 (A3)

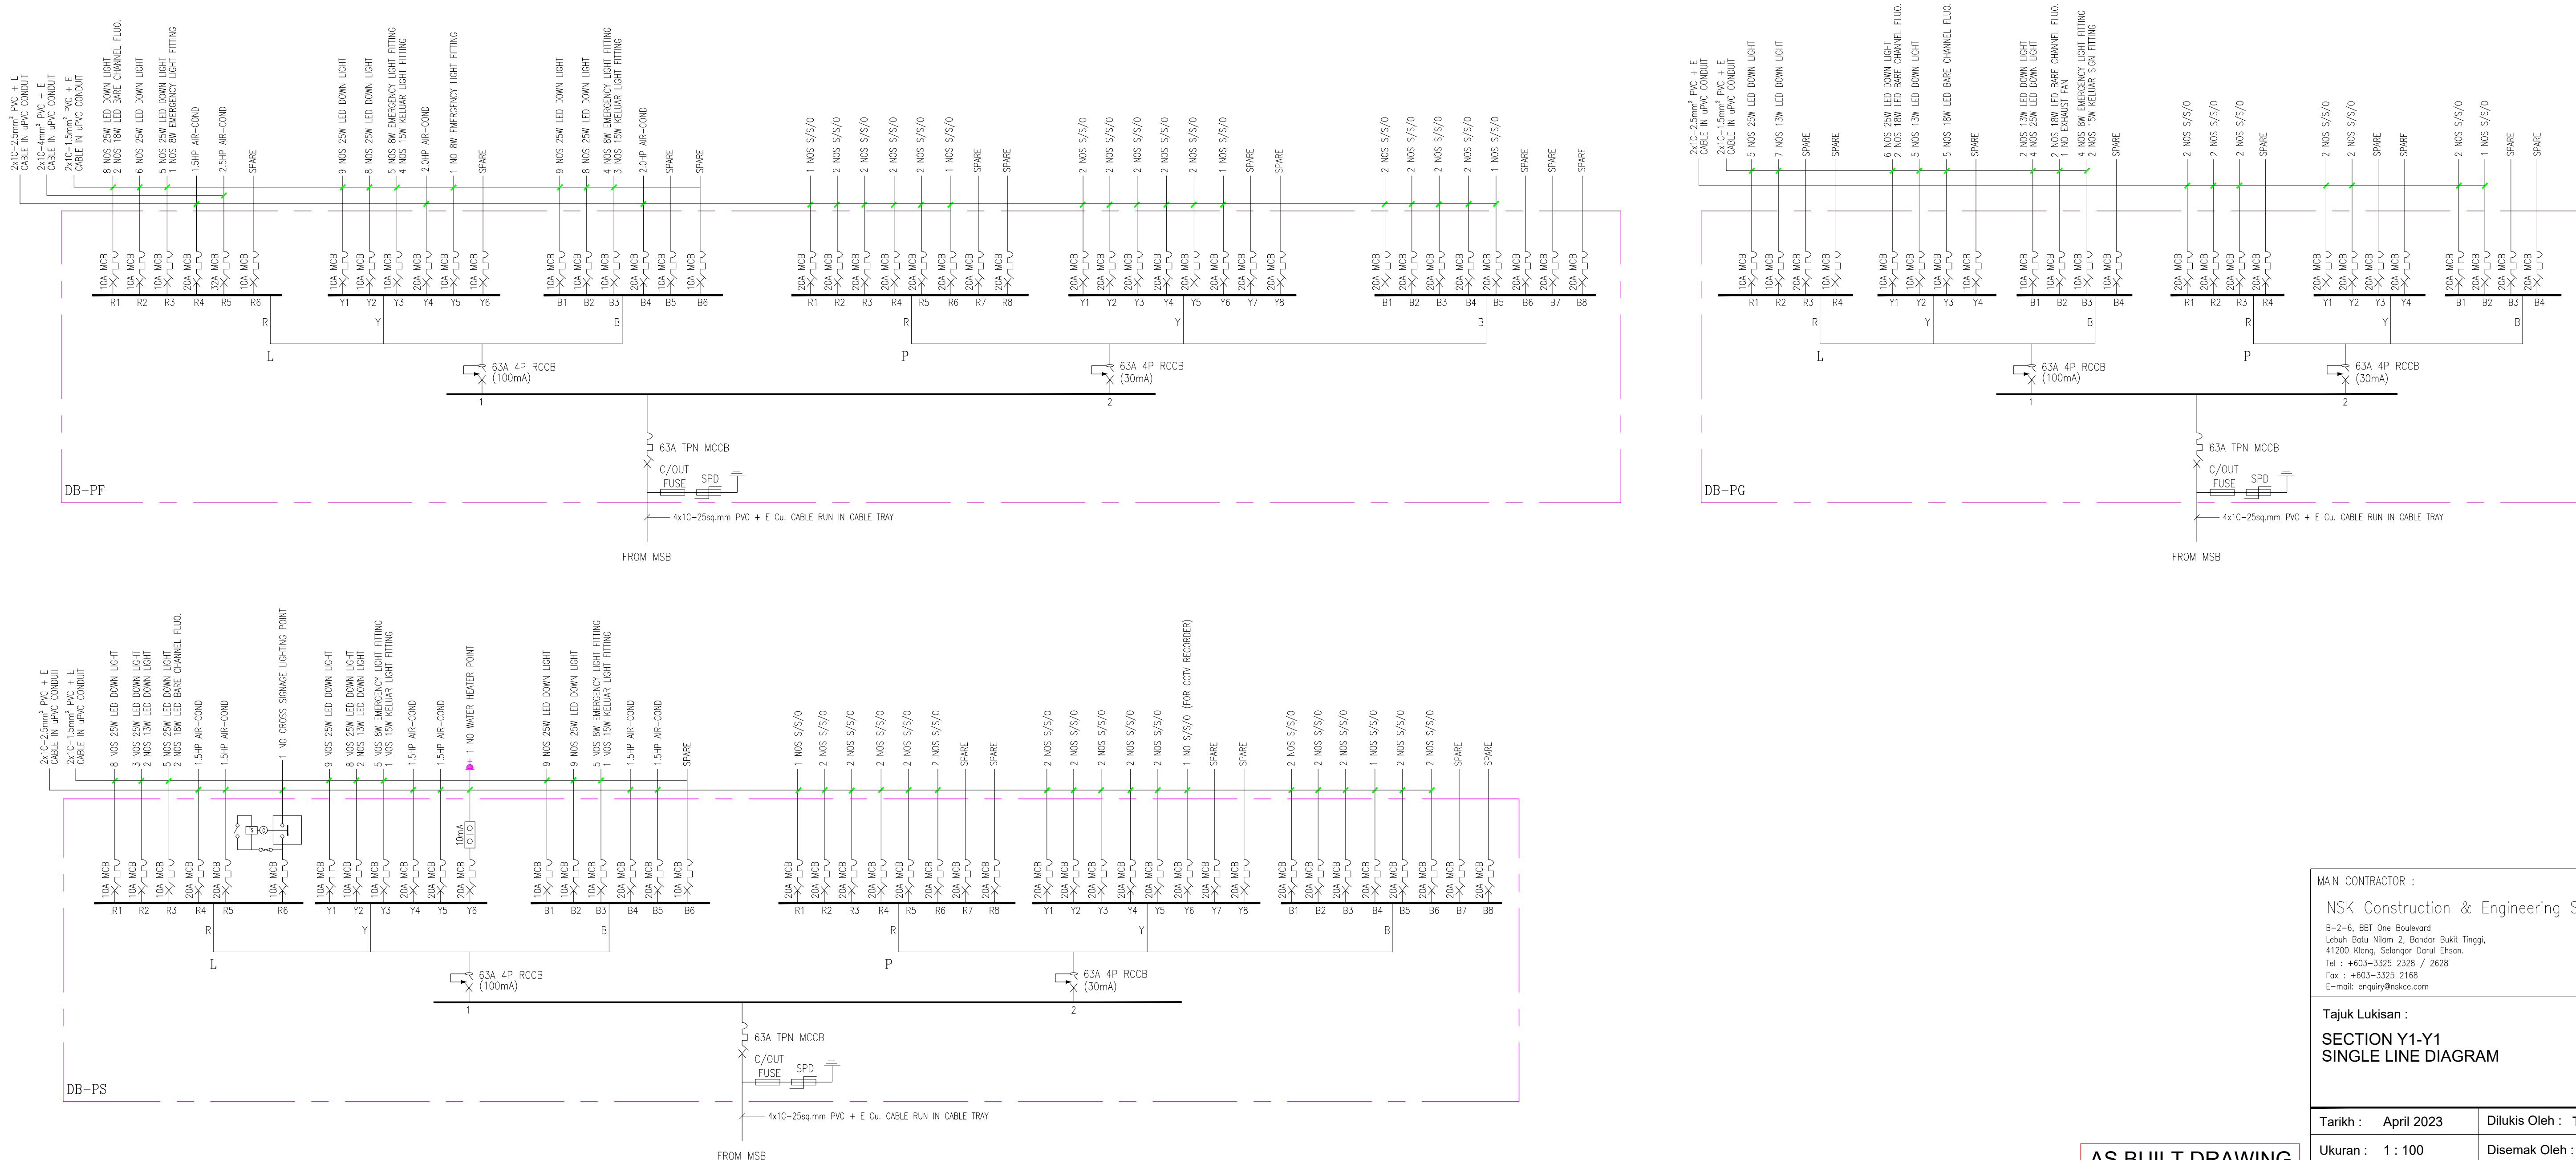

AS BUILT DRAWING
APRIL 2023

MAIN CONTRACTOR :
NSK Construction & Engineering Sdn. Bhd.
B-2-6, BBT One Boulevard
Lebuhr Batu Nilam 2, Bandar Bukit Tinggi,
41200 Klang, Selangor Darul Ehsan.
Tel : +603-3325 2328 / 2628
Fax : +603-3325 2168
E-mail: enquiry@nskce.com

Tajuk Lukisan :
SECTION Y1-Y1
SINGLE LINE DIAGRAM

Tarikh : April 2023	Dilukis Oleh : Teoh
Ukuran : 1 : 100	Disemak Oleh : Ng
Projek No: JCY/18043/E-3A	Bil. Lukisan : -