


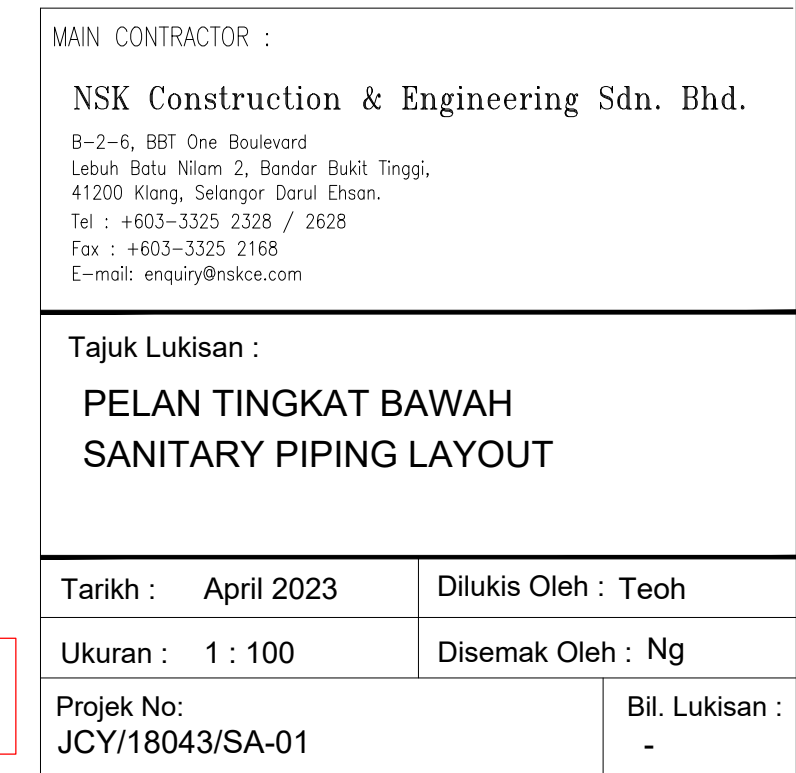

GROUND FLOOR PLAN

SCALE 1 : 200 (A3)