

Rajah di muka


Jatrum Sanipada		1522895	2	1522895	1	4	33.731	33.731
PA		pk.B		BKL				
2-3	1963121	2	1963121	3	4	21.212	S.L	21.212
2-4	1021938	2	1021938	4	4	9.980	BKL	9.980
2-5	31551	2	31551	5	4	29.329	BKL	29.329
2-6	3592822	2	3592822	6	4	13.659	BKL	13.659
1	1522895 3322895 72 4236	2	72 4236	7	4	106.690		106.690
2	72 4236 2524236							
	pk.B							
2	2524236 72 4236 607812	7	607812	8	4	117.972		117.972
7	607812 2407812							
	pk.B							
7	2407812 607812 765237	8	765237	9	4	23.358		23.358
8	765237 2585237							
	pk.B							
8-10	1304509	8	1304509	10	4	5.236	BKL	5.236
8-11	993053	8	993053	11	4	7.577	BKL	7.577
8-12	512990	8	512990	12	4	38.901	BKL	38.901
8-12	601235	8	601235	12	4	31.632	BKL	31.632
8	2585237 765237 1075726	9	1075726	13	4	59.077		59.077
9	1075726 2895726							
	pk.B							

No. Fail

Rajah di muka

Stesen	BEARING - SUDUT	Dari	GARISAN	Ke	Sudut Pukak	Jarak	Suhu	Jarak	Jarak
Panyulang Kiri	Panyulang Kanan	Stn.	Bearing Muklamar	Stn.	(°)			Antara	Muktamar
								Tubang	

BANDAR PETALUNG JAYA

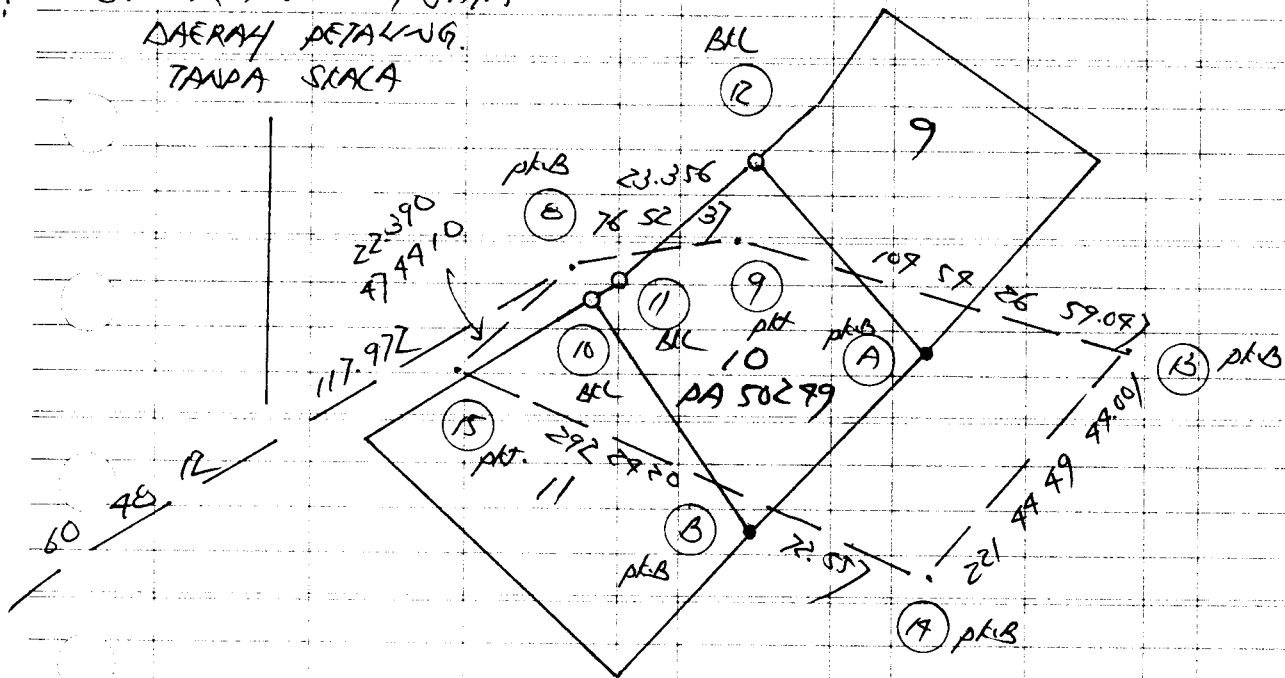DAERAH PETALUNG
TAMPA SAKA

1-12 58 07 56 258.627 ~
 58 07 58 258.589 10
 -2" 10.035

9-12 69 16 59 286.387 ~
 69 16 59 286.350 10
 +10" 10.037

Amend. 1.

13-A 266 23 90 27.591 p.k.B
 17-B 281 39 03 23.180 p.k.B.

Tarikh J. Gmibang SEC 650


Dibuat untuk Aras

56

Daripada PJ Sec 16.

Ke

Pandangan Belakang	Pandangan Antara	Pandangan Hadapan	Naik	Turun	Aras Yang Dilaras	Jarak	Catitan
1.598 (15.8)	0.082 (10.2)	3.758 (12.3)			79.395 80.911	78M F1870	nailed on top of comp.
0.187 (10.6)	1.183 (13.9)	3.758 (12.3)			77.239 76.233	F1010 (15.6)	
1.785-	7.502-				73.678	78M	
0.130 (10.7)					73.678	CP4	
0.288 (10.9)	3.919 (11.2)						
0.259 (10.8)	3.777 (12.3)						
0.159 (10.5)	3.737 (12.2)						
0.155 (10.5)	3.815 (12.5)						
0.135 (10.9)	3.767 (12.3)						
0.758 (11.8)	3.961 (13.0)						
	1.623 (15.3)				51.159	78M F1871	nailed on top of comp.
1.580-	29.099-					7.	

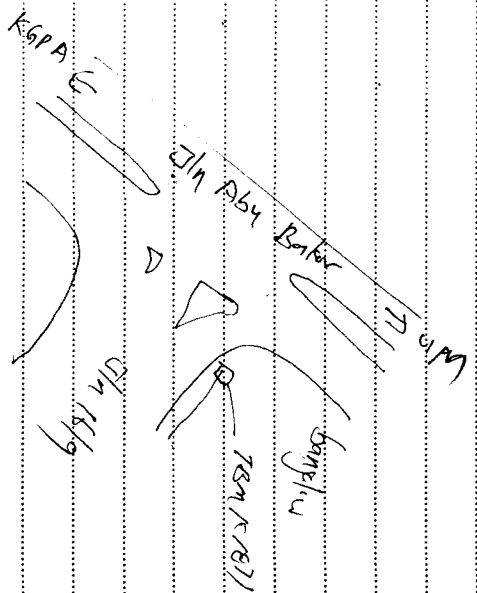

Tarikh Aras

Dibuat untuk

57

Daripada

Ke

Pandangan Belakang	Pandangan Antara	Pandangan Hadapan	Naik	Turun	Aras Yang Dilaras	Jarak	Catilan
1.623					51.159	78M F/1871	
3.955	(11.39)	2.975	(18.12)		50.307		
3083	(10.11)	0.329	(11.06)		53.938		
2.691	(18.66)	0.025	(0.08)		56.996		
2.793	(9.18)	1.026	(3.32)		58.111	F1019 (18.13)	
N.595		1.223	(9.18)		59.631	78M F/1872 on top of curved drain (18.18)	
		5.123					
0.317	(11.08)				51.159	78M F/1871	Spit.
0.305	(1.08)	3.599	(11.81)				
0.826	(2.11)	2.798	(9.15)				
1.808	(19.62)	2.393	(7.85)				
2.388	(12.87)	0.820	(2.89)				
3.317	(10.88)	0.509	(1.62)				
1.650	(5.71)	0.309	(1.01)				
10.22		0.997	(3.11)		50.008	78M H/2 / 78M F/1873 on top of	
		11.367				RL: 50.008 (existing H/L)	
						BM W0089 RL: 58.009 Photo Distance 2	

