

J6M 667 Th 223 607320

No. Fail


Rajah di muka

| No. Fail | BEARING SUDUT   |                 |          | Dari Stn | GARISAN         |          | Ke Stn | Sudut Pukak (°) | Jarak   | Suhu | Jarak Antara Tiang | Jarak Mukamat |
|----------|-----------------|-----------------|----------|----------|-----------------|----------|--------|-----------------|---------|------|--------------------|---------------|
|          | Pengulang Kiri  | Pengulang Kanan | Purata   |          | Bearing Mukamat |          |        |                 |         |      |                    |               |
|          | Datum Daripada  |                 |          | 398 1750 | 2               | 398 1750 | 1      | 4               | 70.970  |      |                    | 70.970        |
|          |                 |                 |          | pk.B     |                 |          | PL     |                 |         |      |                    |               |
| 1        | 398 1750        | 168 1750        | 263 1935 | 2        | 263 1935        | 3        | 4      | 4               | 3.259   |      |                    | 3.259         |
| 2        |                 |                 |          |          |                 |          |        |                 |         |      |                    |               |
| 3        | 263 1935        | 83 1935         |          |          |                 |          |        |                 |         |      |                    |               |
|          |                 |                 |          |          |                 |          |        |                 |         |      |                    |               |
|          |                 |                 |          |          |                 |          |        |                 |         |      |                    |               |
| 1        | Seperti Di Atas | 356 1701        | 2        | 356 1701 | 4               | 4        | 4      | 4               | 123.633 |      |                    | 123.633       |
| 2        |                 |                 |          |          |                 |          |        |                 |         |      |                    |               |
| 4        | 356 1701        | 176 1701        |          |          |                 |          |        |                 |         |      |                    |               |
|          |                 |                 |          |          |                 |          |        |                 |         |      |                    |               |
| 1        | Seperti Di Atas | 170 3102        | 2        | 170 3102 | 5               | 4        | 4      | 4               | 28.968  |      |                    | 28.968        |
| 2        |                 |                 |          |          |                 |          |        |                 |         |      |                    |               |
| 5        | 170 3102        | 350 1702        |          |          |                 |          |        |                 |         |      |                    |               |
|          |                 |                 |          |          |                 |          |        |                 |         |      |                    |               |
| 2        | 350 3102        | 170 3102        | 158 3753 | 5        | 158 3753        | 7        | 4      | 4               | 79.975  |      |                    | 79.975        |
| 5        |                 |                 |          |          |                 |          |        |                 |         |      |                    |               |
| 7        | 158 3753        | 338 3753        |          |          |                 |          |        |                 |         |      |                    |               |
|          |                 |                 |          |          |                 |          |        |                 |         |      |                    |               |
| 5-8      | 312 5512        | 132 5512        |          | 5        | 312 5512        | 8        | 4      | 4               | 5.575   |      | pk.L               | 5.575         |
| 7-8-9    | 263 0319        | 83 0319         |          | 7-8      | 263 0319        | 9        | 4      | 4               | 17.655  |      | pk.L               | 17.655        |
| 8-10     | 239 5708        |                 |          | 7-8      | 239 5708        | 10       | 4      | 4               | 22.389  |      | pk.L               | 22.389        |
| 2        | 176 1701        | 356 1701        | 79 2952  | 4        | 79 2952         | 11       | 4      | 4               | 90.811  |      |                    | 90.811        |
| 4        |                 |                 |          |          |                 |          |        |                 |         |      |                    |               |
| 11       | 79 2952         | 259 2952        |          |          |                 |          |        |                 |         |      |                    |               |
|          |                 |                 |          |          |                 |          |        |                 |         |      |                    |               |
BANDAR DETAKUNG JAYA  
DAERAH DETAKUNG.  
TANPA RALAH


Rajah di muka

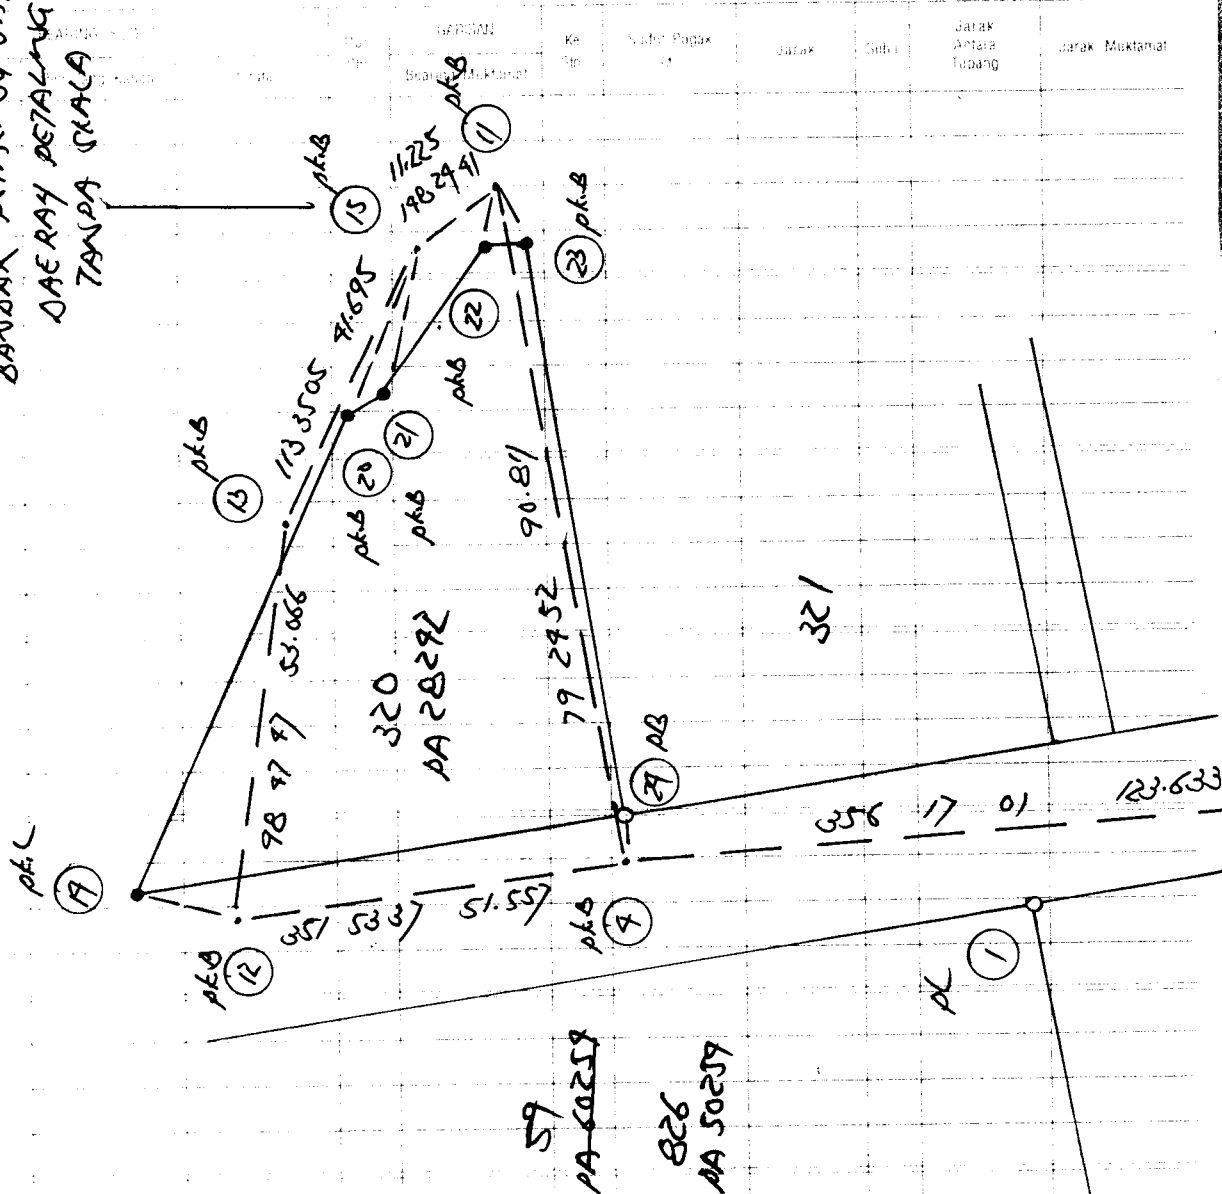

No. Lari

Rajah di muka

| Stasiun             | BEARING (SUDUT) |               |        | Jarak<br>Stn | GARISAN          | Ke<br>Stn | Sudut Pukak<br>(°) | Jarak | Suhu | Jarak<br>Antara<br>Tupang | Jarak Muktamat |
|---------------------|-----------------|---------------|--------|--------------|------------------|-----------|--------------------|-------|------|---------------------------|----------------|
|                     | Bearing Kiri    | Bearing Kanan | Perata |              | Bearing Muktamat |           |                    |       |      |                           |                |
|                     |                 |               |        |              |                  |           |                    |       |      |                           |                |
| <u>Demarcation.</u> |                 |               |        |              |                  |           |                    |       |      |                           |                |
| 15-20               | 291 9132        | 25.028        | pk.B   |              |                  |           |                    |       |      |                           |                |
| 15-21               | 283 3358        | 20.329        | pk.B   |              |                  |           |                    |       |      |                           |                |
| 11-22               | 272 3933        | 6.958         | pk.B   |              |                  |           |                    |       |      |                           |                |
| 11-23               | 237 0739        | 7.669         | pk.B   |              |                  |           |                    |       |      |                           |                |
| 9-24                | 83 9610         | 5.978         | pk.B   |              |                  |           |                    |       |      |                           |                |

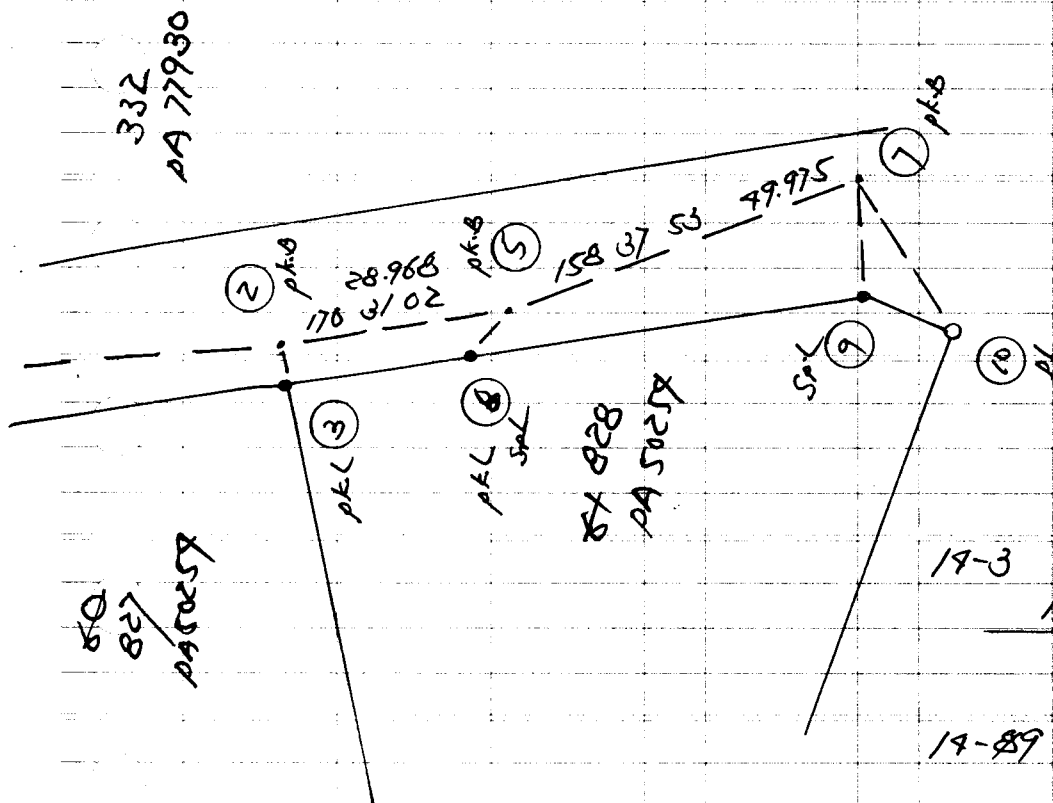

17-3 177 2018 188.088 N  
 177 2017 188.088 PO  
 71" N

17-89 175 35 16 265.177 N  
 175 35 18 265.191 PO  
 -2' 70036

Tarikh ..... 07/4 223 60230  
 Aras

Dibuat untuk .....

25

Daripada ..... J Smiley 667

Ke .....

| Pandangan Belakang | Pandangan Antara | Pandangan Hadapan | Naik   | Turun | Aras Yang Di'ar' - | Jarak                  | Catitan                                                 |
|--------------------|------------------|-------------------|--------|-------|--------------------|------------------------|---------------------------------------------------------|
| 0.885              | (1.29)           |                   |        |       | 23.006             | 78M 1932 Atas Hydrant. |                                                         |
|                    | 1.260            | (1.13)            |        |       | 22.631             | F1005                  |                                                         |
|                    | 1.575            | (5.17)            |        |       | 22.346             | F1031                  |                                                         |
|                    | 1.978            | (1.84)            |        |       | 22.917             | F1001                  |                                                         |
| 1.432              | (1.70)           | 1.578             | (5.00) |       | 22.367             |                        |                                                         |
|                    | 1.205            | (3.95)            |        |       | 22.599             | 78M F1933 Atas m/h Gw. |                                                         |
| 1.515              | (1.97)           | 1.903             | (1.66) |       | 22.396             |                        |                                                         |
|                    | 1.407            | (1.62)            |        |       | 22.509             | R2 R2                  | RL: 22.509                                              |
|                    |                  | 1.391             | (1.56) |       | 22.520             | 78M H1                 | RL: 22.521                                              |
| 3.832              |                  | 9.318             |        |       |                    |                        | At the heights based on<br>BM 85088<br>RL: 22.66 22633m |