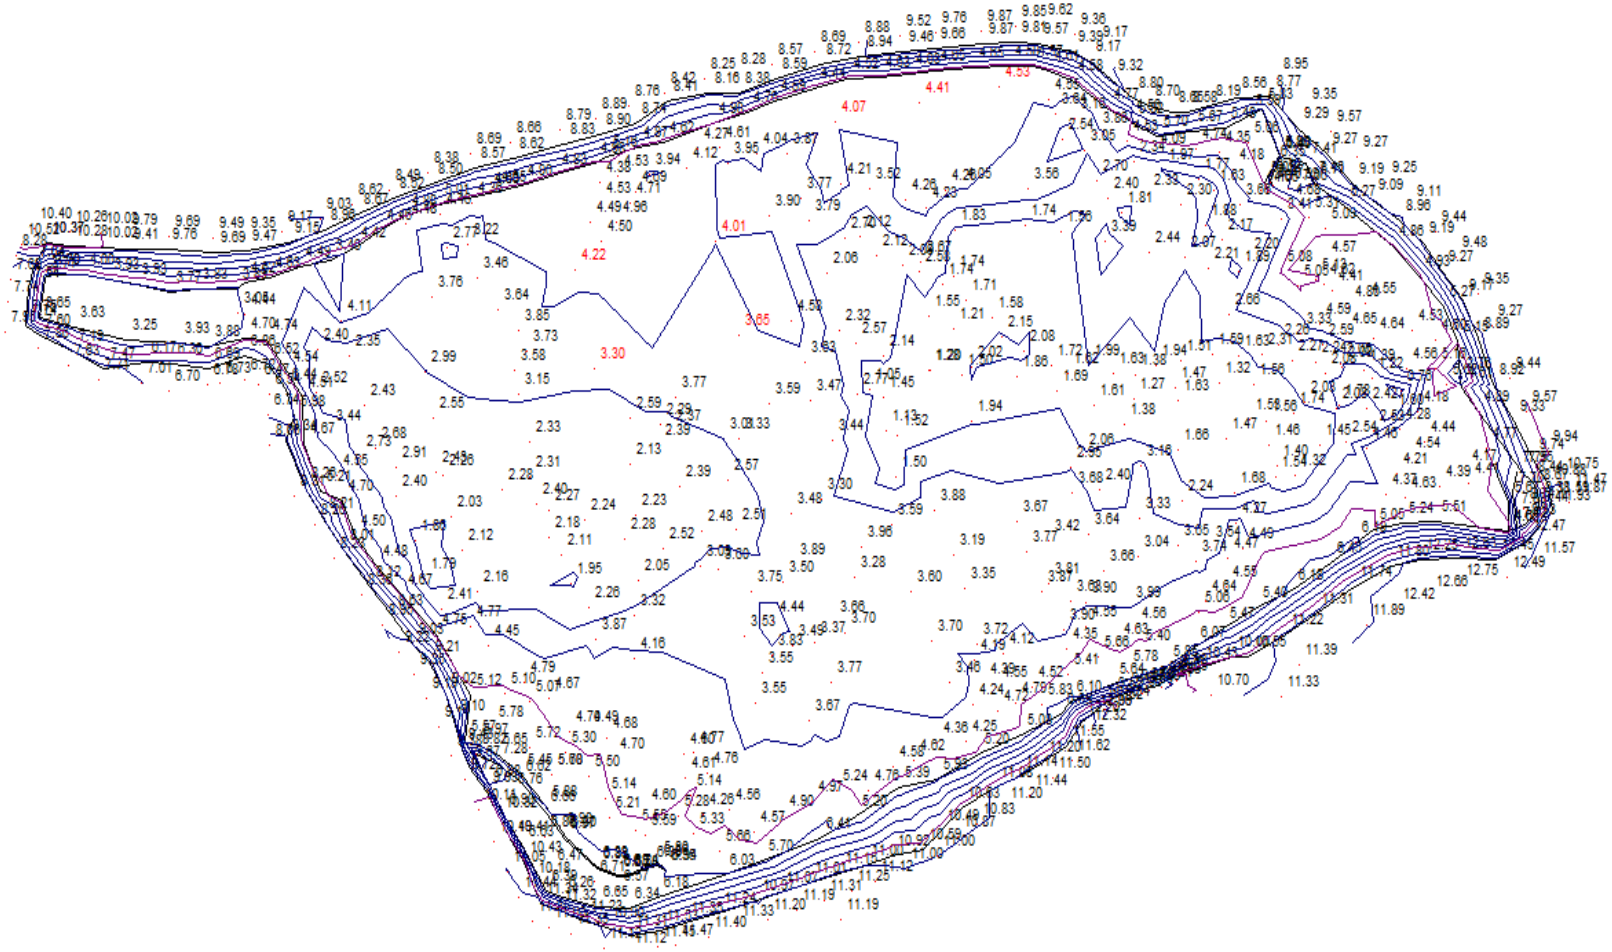AS-BUILT EARTHWORK (28/03/2018)