


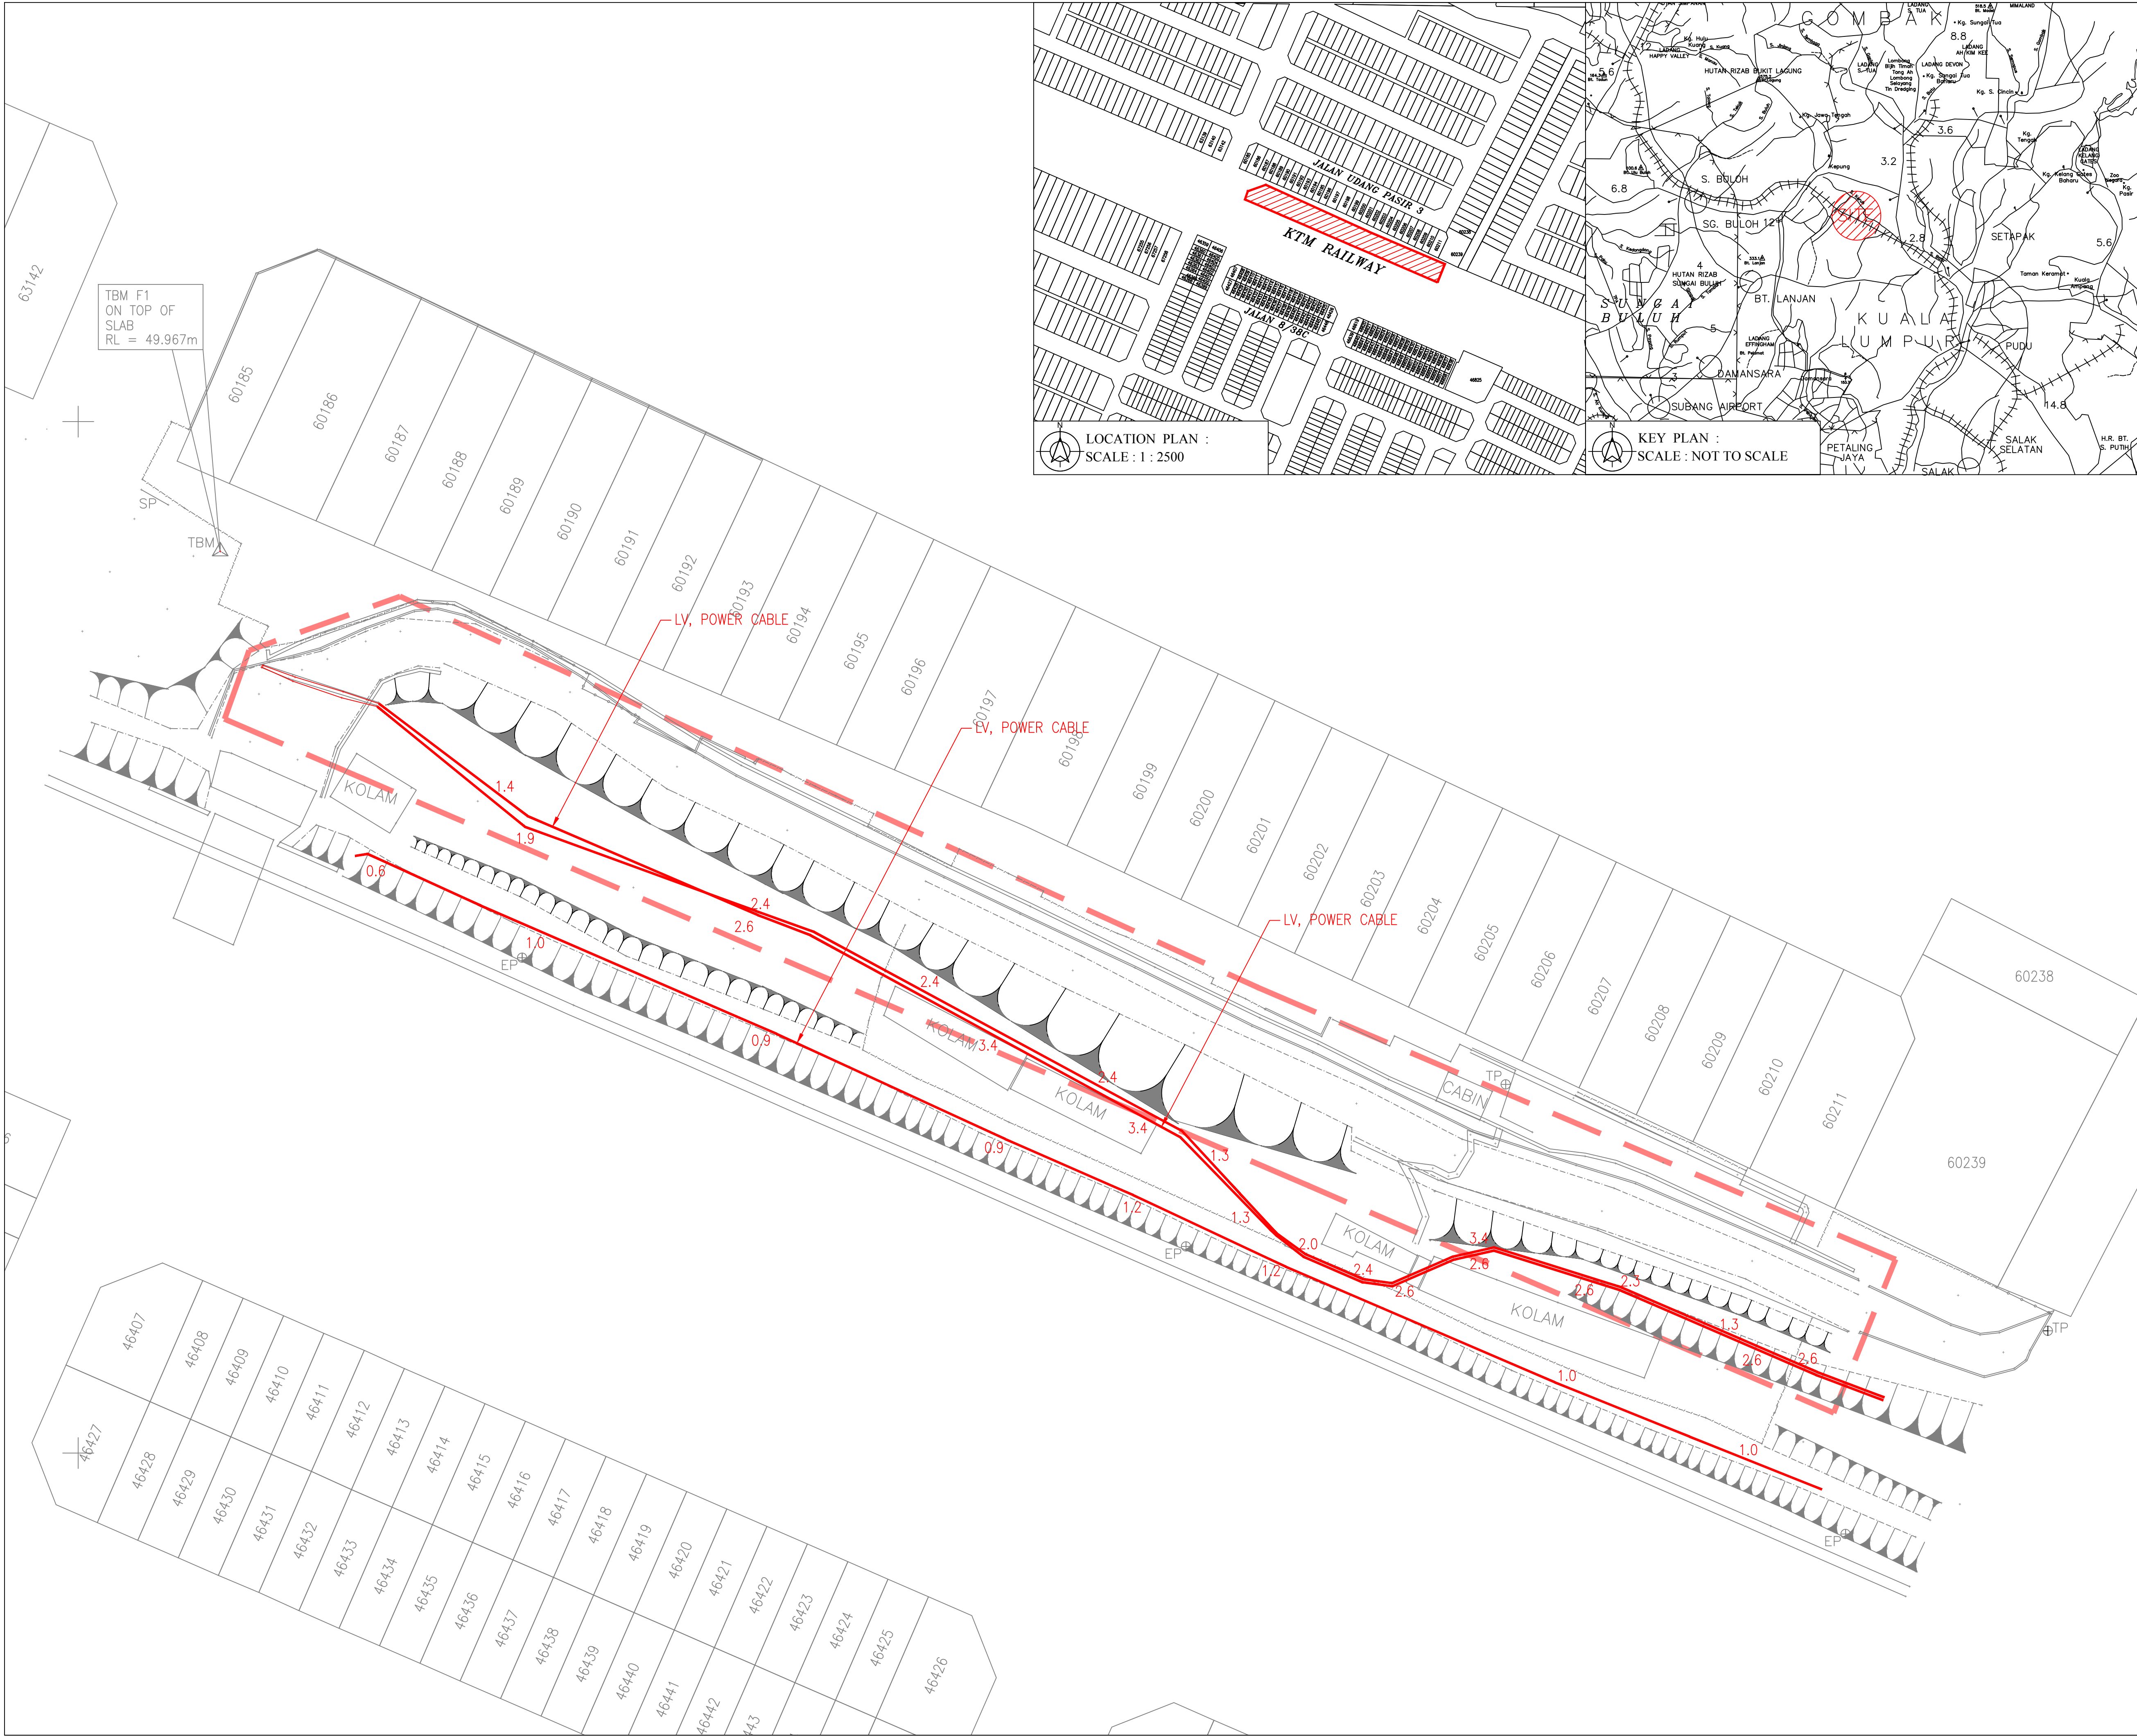

SCALE 1 : 300  
STD. SHEET : 77 - C

PROJECT :

**UNDERGROUND UTILITIES  
DETECTION AND MAPPING  
WORKS AT JALAN PASIR 3,  
KEPONG, KUALA LUMPUR.**

LEGENDS :-

|    |    |                |
|----|----|----------------|
| 1. | —  | POWER CABLE    |
| 2. | LP | LAMP POST      |
| 3. | TP | TELEPHONE POLE |

NOTE :-

1. ALL MEASUREMENTS ARE IN METRES.

2. THE UTILITIES SURVEY INFORMATION ON THIS PLAN HAS BEEN PRODUCED USING ELECTRO-MAGNETIC LOCATING (EML) TECHNIQUES AND USING THE GROUND PENETRATION RADAR (GPR) EQUIPMENT. ALTHOUGH BEING THE MOST ACCURATE AVAILABLE, SIGNALS ARE SUSCEPTIBLE TO DISTORTION ON THE SURFACE ESPECIALLY IN CONGESTED AREAS.

THERE MAY ALSO BE NON-METALLIC SERVICES AND METALLIC SERVICES PRODUCING INSUFFICIENT SIGNALS FOR ACCURATE LOCATION. WHILST EVERY EFFORT HAS BEEN MADE TO PRODUCE AN ACCURATE PLAN OF THE BURIED SERVICES WITHIN THE SURVEY AREA, CRUCIAL DIMENSION AND DEPTHS SHOULD BE CHECKED.

**EXTREME CAUTION SHOULD BE TAKEN WHEN ANY EXCAVATION IS UNDERTAKEN - THE INFORMATION CONTAINED WITHIN THIS PLAN MAY NOT REPRESENT THE TOTAL NUMBER OF SERVICES CONTAINED WITHIN THE SURVEY AREA. TYPE AND SIZE OF UTILITIES IS DEEM INDICATIVE AND DETERMINED BASED ON SITE BY PHYSICAL INDICATORS SUCH AS EXPOSED PIPES, MARKERS AND OPERATORS OWN EXPERIENCE. HEALTH AND SAFETY GUIDELINES SHOULD BE FOLLOWED PRIOR TO EXCAVATION.**

SURVEYED BY : HARIS JUNE.2020

DRAWN BY : HUSNA JUNE.2020

CHECKED BY : KWONG

UTILITY DETECTION/MAPPING :

.....  
Sr. LAU WEI SENG  
B. GEOMATICS (MRLB) HONS. R.I.S.M (M)  
Jurukur Tanah Yang Dilemah Di Bawah Akta 458  
**PERUNDING UKUR TEKUN**  
20-2, JALAN PJU 5/15  
DATARAN SUNWAY  
KOTA DAMANSARA  
47810 PETALING JAYA  
Tel : 03-61579888 Fax : 03-61572145 E-mail : main@put.com.my

PLAN NO : PUT/W4051/20/UD/P1