

TMA Duta.

No. Fail

Rajah di muka

Stesen	BEARING / SUDUT			Dari Stn.	GARISAN		Ke Stn.	Sudut Pukak (±)	Jarak	Suhu	Jarak Antara Tupang	Jarak Muktamat
	Penyilang Kiri	Penyilang Kanan	Purata		Bearing Muktamat							
Assumed Duta from	P.C.		323 00 00	1	323 53 20	2		+ 0.192		10.10.11.		52.614
○		mt	52 50	1570		1607				RL	81.538	
		m2t	32	PK		PK					+ 0.14	
			RL: 81.385						Adj	RL	81.552	
2	323 00 00	143 00 00	83 44 20	1	84 31 40	3						3.671
①		mt	52 50									
3	83 44 20	263 44 20	m2t 32									
	RL											
1	143 00 00	323 00 00	258 10 47	2	259 08 30	4						15.550
②		mt	52 50	1580								
4	258 10 47	78 10 47	m2t 32									
	RL											
1	S.DA		347 38 00	2	348 31 20	5						47.731
②		mt	52 50									
5	347 38 00	167 38 00	m2t 32									
	SPC											
1	143 52 50	373 52 50	2 32 28	2	2 33 00	6		+ 2809				44.101
②		mt	32	1580		1625				RL	84.316	
6	2 32 28	182 32 28	ct 4								+ 0.04	
	PK								Adj	RL	84.320	
2	182 32 28	2 32 28	21 50 42	6	21 51 20	7						1.963
⑥		mt	32	1610								
7	21 50 42	201 50 42	mt 4									
	PK-L											
2	S.DA		95 51 54	8	95 52 30	8		- 6546				34.931
⑥		mt	32	1610		1554				RL	77.826	
8	95 51 54	215 51 54	ct 8								+ 0.09	
	PK-L								Adj	RL	77.835	

Rajah di muka

[illegible]

No. Fail

Rajah di muka

[illegible]

Rajah di muka

[illegible]

..... taken for WP 130

To

Date 11-10-11 Levels
From TNN Staff

[illegible]

8-1180 4620 195 57 13

1200 1532 121 51 41

1-1265- 3049 92 34 28

12-134 2530 443 55 50

12-1372 2113 284 47 50

1388 3751 150 31 56

012: maxiz mH-

016: Digi Mankole

403 - Birming Pool

20101: stable during bngalon (Hse no: 41)


20102:

501: free

" (Hse no 37)

009 (without string) Top wave level.

623: Taktan exchange box

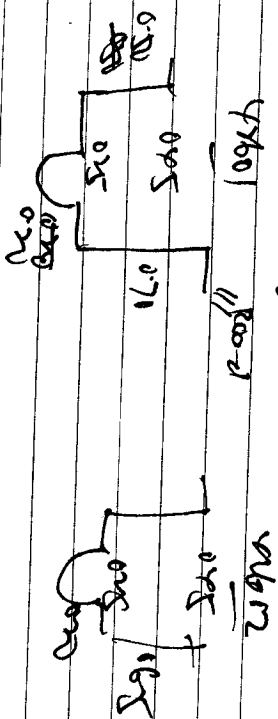

2030101/02: 31m Tangle Ampuan

30102/05: 31m Tangle Ampuan

20603

