


Demarcatie.

No. Fail *SEL 18 Ampang Tokong*

Rajah di muka

Stesen	BEARING / SUDUT			Dari Stn.	GARISAN		Ke Stn.	Sudut Pukak (±)	Jarak	Suhu	Jarak Antara Tupang	Jarak Muktamat
	Penyilang Kiri	Penyilang Kanan	Purata		Bearing Muktamat							
1	Bering Daripada	AK	195 00 00	2	193 22 00	1	1/	90.962		13/5/65		90.962
2			M-1 38 00									
1	195 00 00	15 00 00	329 31 20	2	327 53 20	3	4	9.551				9.551
2			M-1 38 00									
3	329 31 20	199 31 20										
	Sp L											
1	S. S. A		102 26 32	2	100 78 32	7	4	37.579				37.579
2			M-1 38 00					37.579				
7	102 26 32	282 26 32										
	pk.B											
2	282 26 32	102 26 32	333 78 30	7	332 10 30	5	4	27.832				27.832
7			M-1 38 00									
5	333 78 30	153 78 30										
	pk.L											
2	S. S. A.		182 17 38	7	180 39 38	6	4	105.023				105.023
7			M-1 38 00					105.023				
6	182 17 38	2 17 38										
	pk.B											
7	2 17 38	182 17 38	294 78 09	6	293 10 09	1	4	58.739				58.739
6			M-1 38 00					58.739				
1	294 78 09	114 78 09										
6	114 78 09	294 78 09	15 00 00	1	13 22 00	2	Sila Rujuk	1/1				
1			M-1 38 00				Bering					
2	15 00 00	195 00 00					Terhimp.					

Bering 1-2 dibaca 15 00 00
 Segitainya dibaca 15 00 00
 Tikuan N:/
 Ambekulan N:/

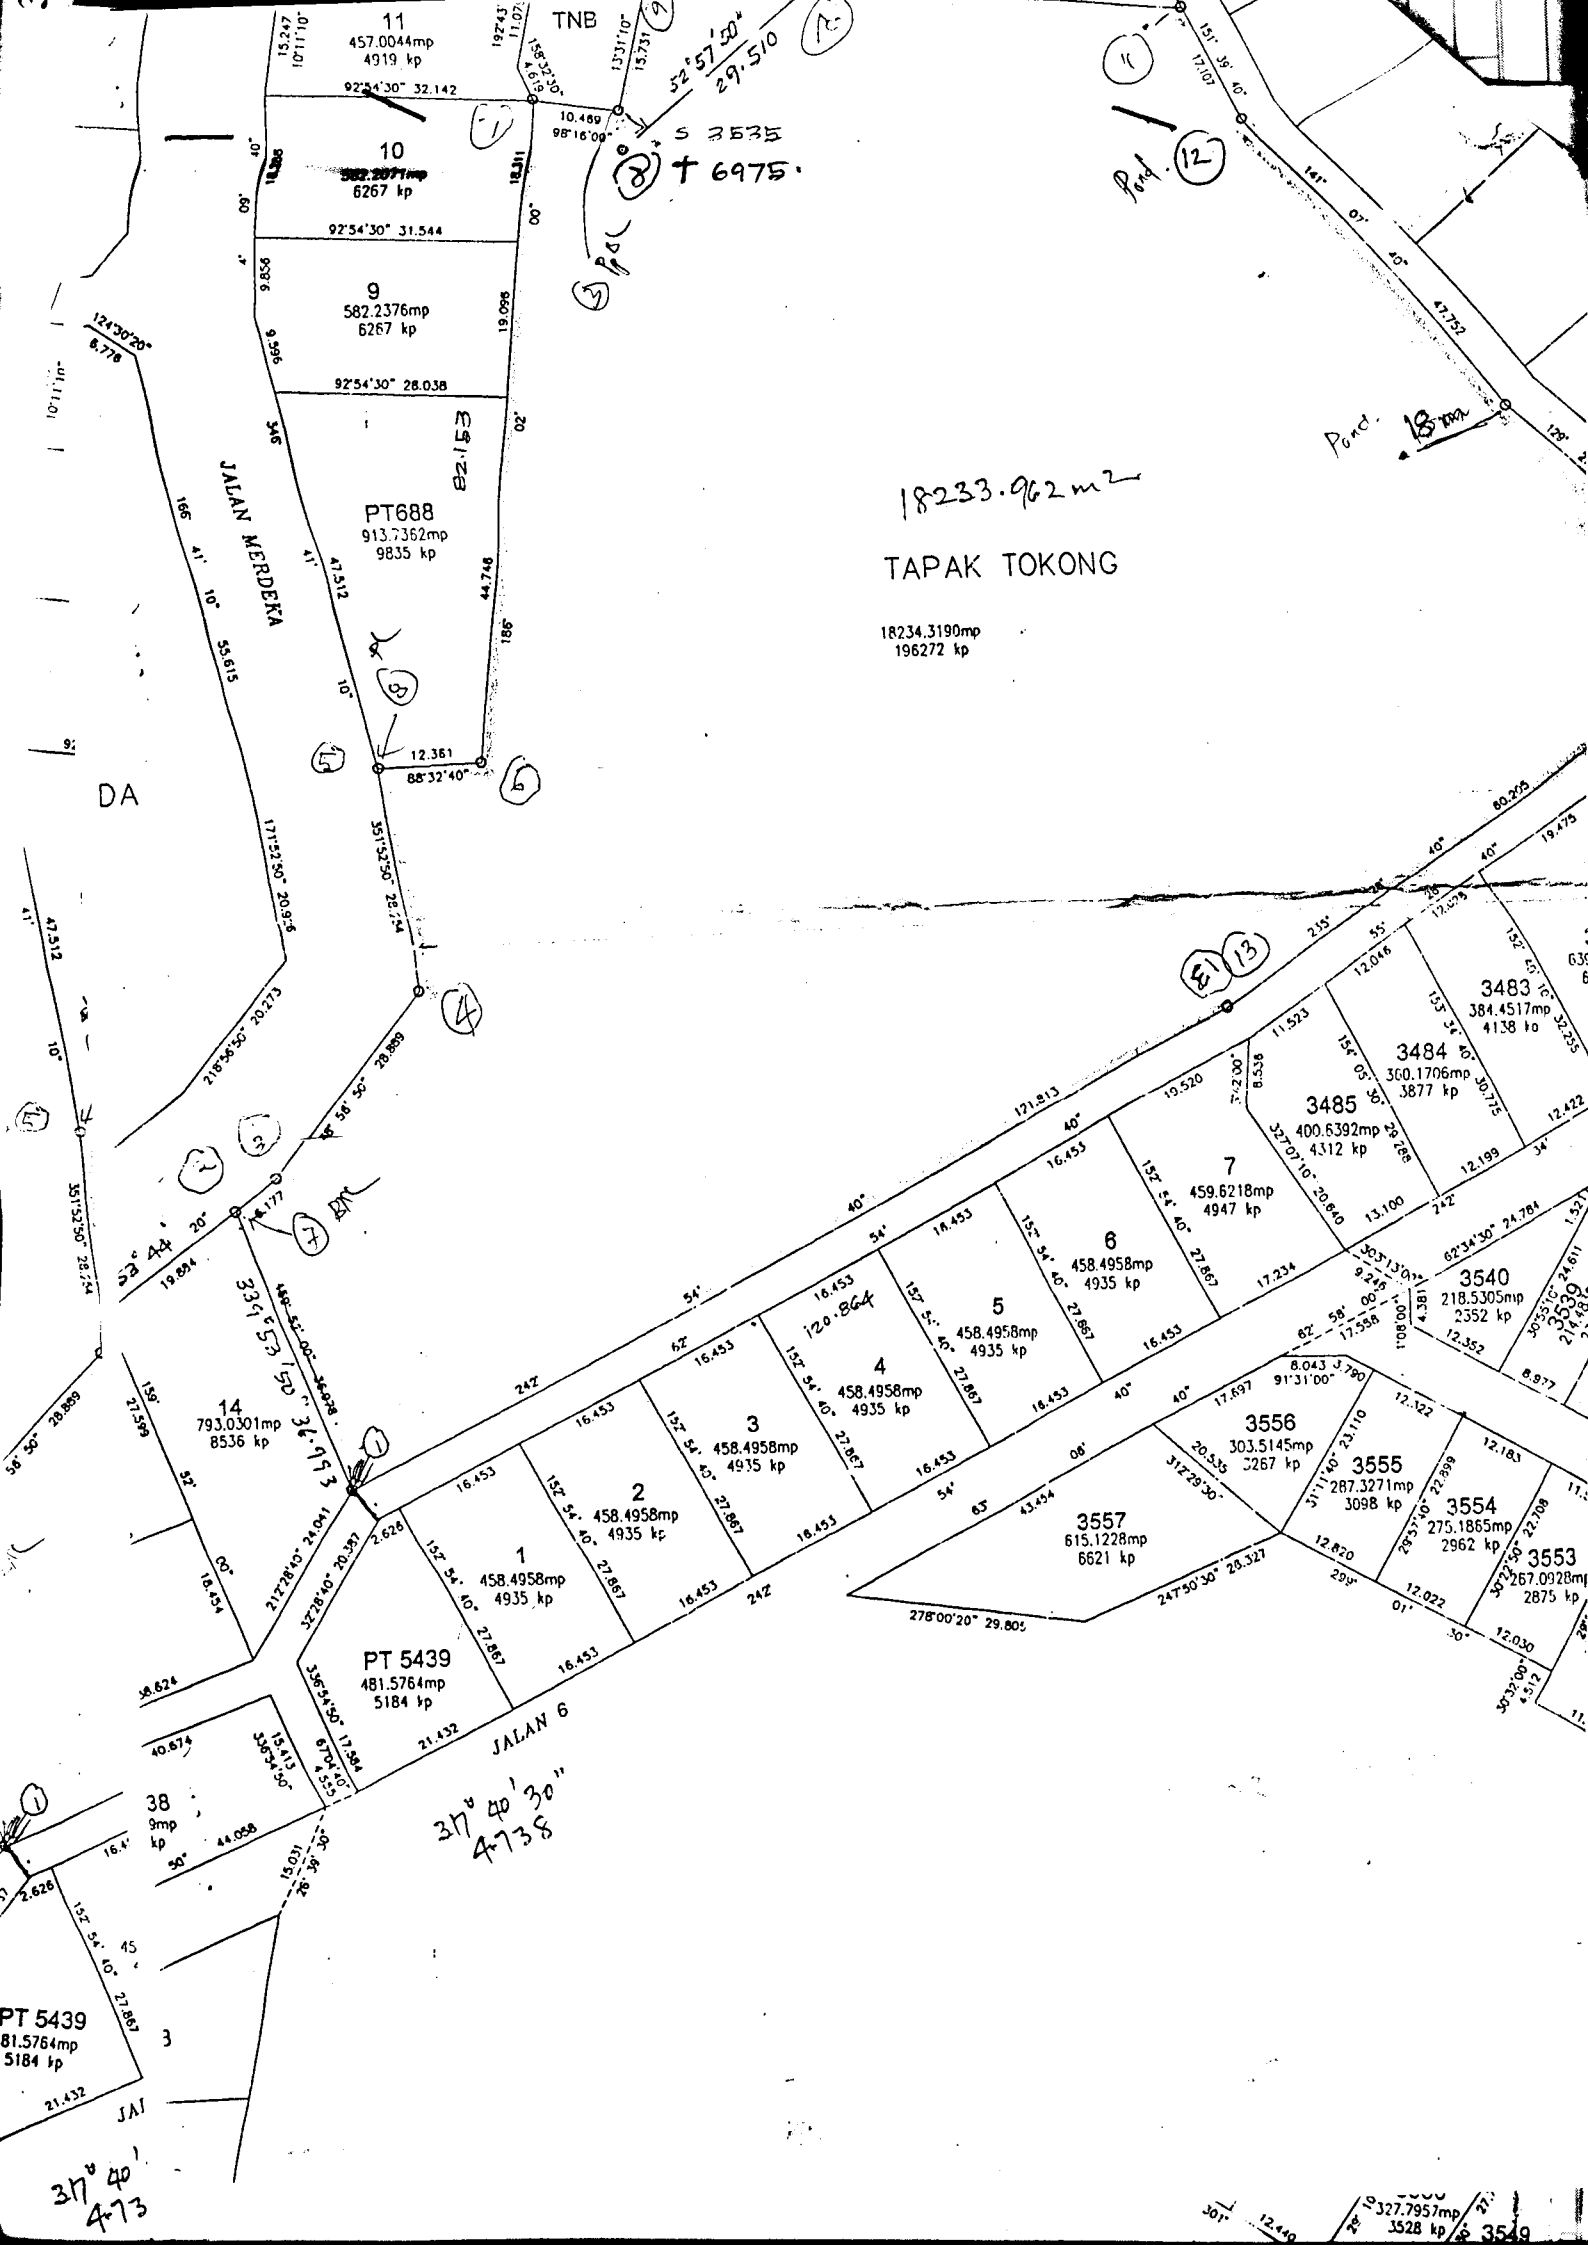

No. Fail SEC193 Ampang Tokong

Rajah di muka

Stesen	BEARING / SUDUT			Dari Stn.	GARISAN Bearing Mukamat	Ke Stn.	Sudut Pukak (±)	Jarak	Suhu	Jarak Antara Pang	Jarak Mukamat
	Penyilang Kiri	Penyilang Kanan	Purata								
	Datum Navipada AB 43 MS 29			2	193 22 00	1	H	90.962	15/1/2017		90.962
1	193 22 00	13 22 00	358 59 43	2	358 59 43	20	H	21.120			21.120
20	358 59 43	178 59 43									
	pk.										
1	Seperti Di Atas	192 05 39	2	192 05 39	21	H		90.295			90.295
21	192 05 39	12 05 39									
2-22	315 48 05			2	315 48 05	22	H	16.182		S.L	16.182
20-23	285 06 36			20	285 06 36	23	H	7.992		BKL	7.992
20-24	120 59 33			20	120 59 33	29	H	3.669		BKL	3.669
20-25	89 27 25			20	89 27 25	25	H	25.581		BKL	25.581
20-26	72 29 59			20	72 29 59	26	H	27.280		BKL	27.280
20-27	96 29 22			20	96 29 22	27	H	20.197		BKL	20.197
21-28	269 59 35			21	269 59 35	28	H	35.399		BKL	35.399
1-29	7 03 50			1	7 03 50	29	H	12.219		pk.L	12.219
1-30	9 45 29			1	9 45 29	30	H	3.300		pk.L	3.300
1-31	283 56 47			1	283 56 47	31	H	12.189		pk.L	12.189
1-32	312 58 32			1	312 58 32	32	H	17.350		PL	17.350
2	13 22 00	193 22 00	217 17 10	1	217 17 10	33	H	25.365			25.365
33	217 17 10	97 17 10									
	pk.										

Rajah di muka

Stesen	BEARING / SUDUT			Dari Stn.	GARISAN Bearing Mukhtamat	Ke Stn.	Sudut Pukak (±)	Jarak	Suhu	Jarak Antara Tupang	Jarak Mukhtamat
	Penyilang Kiri	Penyilang Kanan	Purata								
33-39	139 4909			33	139 4909	39	4	25.378		84	25.378
33-35	0 7326			33	0 7326	35	4	65.028		84	65.028
33-36	0 0957			33	0 0957	36	4	56.216		84	56.216