

No. Fail
 562 766 Kalimantan.

Rajah di muka


Stasiun	BEARING / SUDUT			Dari Stn.	GARISAN		Ke Stn.	Sudut Pukak (°)	Jarak	Suhu	Jarak Antara Papan	Jarak Mukamat
	Pemayang Kiri	Pemayang Kanan	Purata		Bearing Mukamat							
	Dartun Daripada			2	97 5123	1	4	4	39.701	6/1/2012		39.701
					pk.B Ag. Ak. Bk							
					Ag. 114							
1	97 5123	277 5123	175 2820	2	175 2820	3	4	4	59.089			59.089
2												
3	175 2820	355 2820										
	pkx											
2-9	209 2223			2	209 2223	9	4	4	46.722	pk.B		46.722
2-5	173 2015			2	173 2015	5	4	4	56.617	pk.L.		56.617
2	355 2820	175 2820	119 3359	3		6	4	4	70.287			70.287
3					119 3359							
6	119 3359	299 3359										
	pkx											
2	Spanti Di Atas	207 0110		3	207 0110	7	4	4	33.979			33.979
3												
7	207 0110	270 0110										
	pkx											
3-8	33 0000			3	33 0000	8	4	4	2.887	BL		2.887
7-9	291 2701			7	291 2701	9	4	4	6.107	BL		6.107
7-10	209 1601			7	209 1601	10	4	4	21.920	BL		21.920
3	270 0100	207 0110	209 1296	7	209 1296	11	4	4	49.473			49.473
7												
11	209 1296	29 1296										
	pkx											

No. Fail				Rajah di muka								
Stasiun	PEARING SOUND			Dari Sta	GARISAN		Ke Sta	Sudut Pukak (°)	Jarak	Sudut	Jarak Antara Tuyang	Jarak Mukhlamat
	Pemungut K	Pemungut Kanan	Pusat		Bearing Mukhlamat							
16-19	2990150			16	2990150	19	4	5.182		PL	5.182	
16-20	2920812			16	2920812	20	4	7.753		BL	7.753	
17-21	3385155			17	3385155	21	4	6.599		BL	6.599	
18-22	2157557			18	2157557	22	4	73.385		PL	73.385	
18	257557	2157557	2273892	22	2273892	23	4	37.915			37.915	
22				23	2273892	27	4	22.009			22.009	
18	273892	2273892	3111657	23	3111657	29	4	56.518			56.518	
29	3111657	1311657		25	1987096	25	4	13.929		PL	13.929	
18	Sports Di Atas	1987096	23	1987096	25	4	77.555		BL	77.555		
25	1987096	187096		18	2223870	31	4	5.005		BL	5.005	
23	1311657	3111657	1230983	29	3230983	28	4	70.027			70.027	
28	3230983	3230983		29	3230983	28	4	77.069			77.069	
29	3000893	2000893		29	3000893	28	4					


Selagi

Rajah di muka

MARIANO MONT			Dari Stn	GARISAN		Ke Stn	Sudut Pusing (°)	Jarak	Suhu	Jarak Antara Tupang	Jarak Muktamat
Bearing	Distance	Curva		Bearing Muktamat							
10-13	281739	58.581 N									
	282020	58.580 PO									
1-10	208207	117.133 N									
	2082020	117.120 PO									
	-3"	+0.013									
27-21	285692	288.987 N									
	285392	288.989 PO									
	2'50"	-0.002									

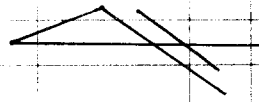

DARAH HUKU SECONDOR
MUKAM KACUMARAN
TANPA STACA

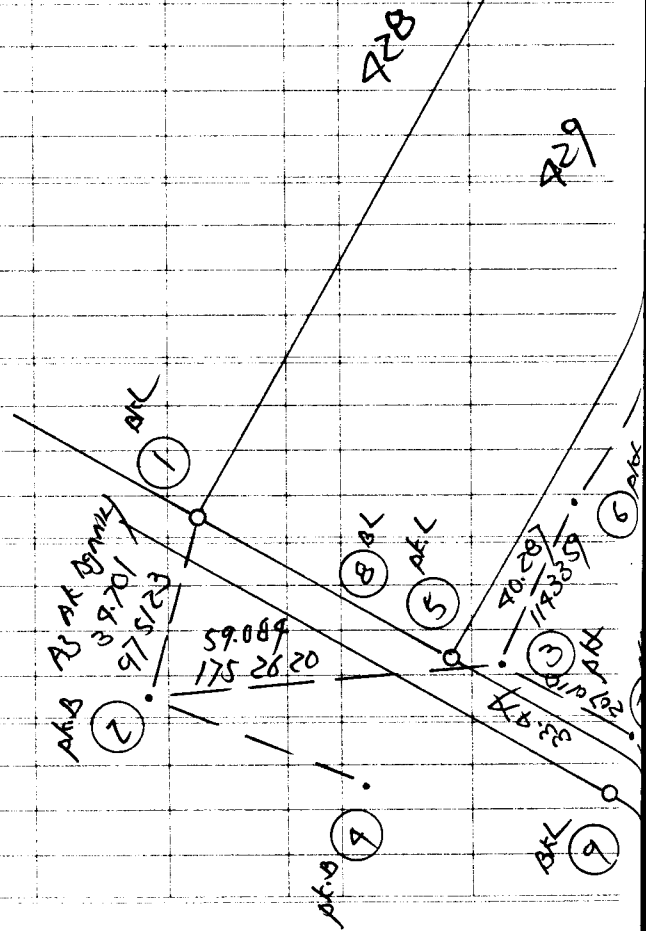

[illegible]