

No. Fail

WP198 Jln Inai (Dareel c)

Rajah di muka

[illegible]

No. Fail

Rajah di muka



Stesen	BEARING / SUDUT			Dari Stn.	GARISAN		Ke Stn.	Sudut Pukak (±)	Jarak	Suhu	Jarak Antara Tupang	Jarak Mukamat
	Penyilang Kiri	Penyilang Kanan	Purata		Bearing Mukamat							
11 - 12	22 19 49	202 19 49		11	22 19 49	12	4	73.761		pk.B (RM)	73.761	
11 - 13	302 47 06	122 47 06		11	302 47 06	13	4	52.358		pk.B (RM)	52.358	
11 - 19	12 22 32			11	12 22 32	19	4	80.657		pk.B	80.657	
10	207 5227	275227	291 36 99	11	291 36 99	15	4	186.996			186.996	
11												
15	291 36 99	111 36 99										
	pk.B											
11	111 36 99	291 36 99	292 30 31	15	292 30 31	16	4	92.187			92.187	
15												
16	292 30 31	112 30 31										
	pk.B											
15-17	202 52 00	22 52 00		15	202 52 00	17	4	76.097		Sp.L	76.097	
16-18	281 35 55			16	281 35 55	18	4	60.165		pk.L	60.165	
16-19	193 42 45			16	193 42 45	19	4	19.992		BL 277C	19.992	
15	112 30 31	292 30 31	22 37 05	16	22 37 05	20	4	73.991			73.991	
16												
20	22 37 05	202 37 05										
	pk.B											
16	202 37 05	22 37 05	110 35 16	20	110 35 16	19	4	269.933			269.933	
20												
19	110 35 16	290 35 16										
20	290 35 16	110 35 16	192 22 32	19	192 22 32	11		Sila Lihat m/s 30 R/				
19												
11	192 22 32	12 22 32										

Bearing 19-11 Di baca 192 22 32
 Sepatutnya Di baca 192 22 32
 Tikaian Nir/
 Pembetulan Nir/

No. Fail

Rajah di muka

Stesen	BEARING / SUDUT			Dari Stn.	GARISAN		Sudut Pukak (±)	Jarak	Suhu	Jarak Antara Tupang	Jarak Mukamat
	Penyilang Kiri	Penyilang Kanan	Purata		Bearing Mukamat	Ke Stn.					

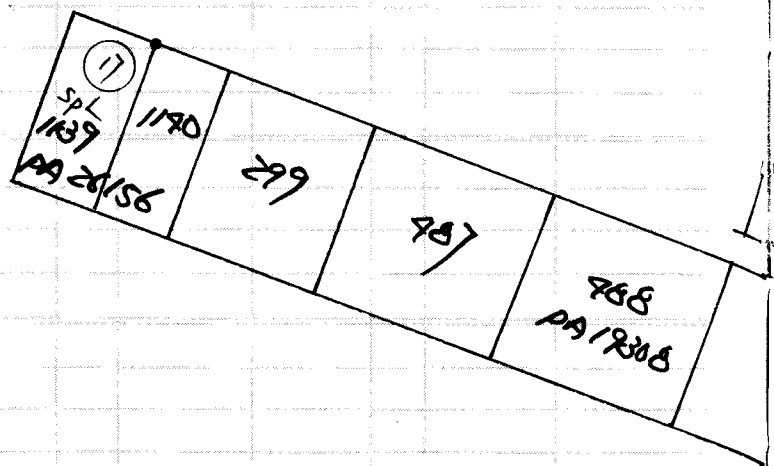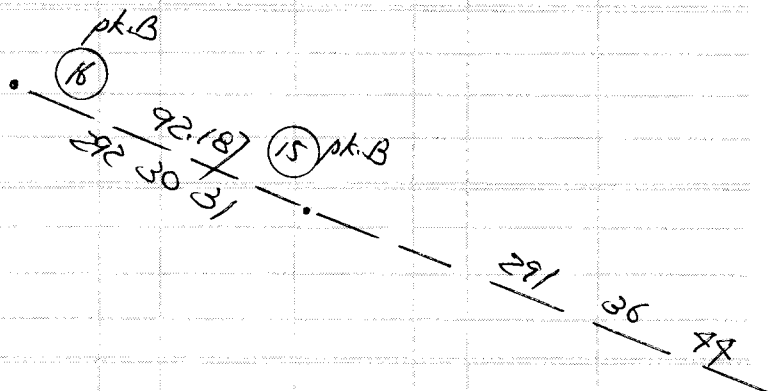


17-5 102 02 59 323.139 ~
 102 02 91 323.192 10
 +18° -0.003

17-9 119 16 13 332.391 ~
 119 15 53 332.365 20
 +20° +0.026

Stesen	BEARING / SUDUT			Dari Stn.	GARISAN Bearing Mukamat	Ke Stn.	Sudut Pukak (±)	Jarak	Suhu	Jarak Antara Tupang	Jarak Mukamat
	Penyilang Kiri	Penyilang Kanan	Purata								

BANDAR KUALA CUMPYR
SEKSYEN 67
TANPA SKALA

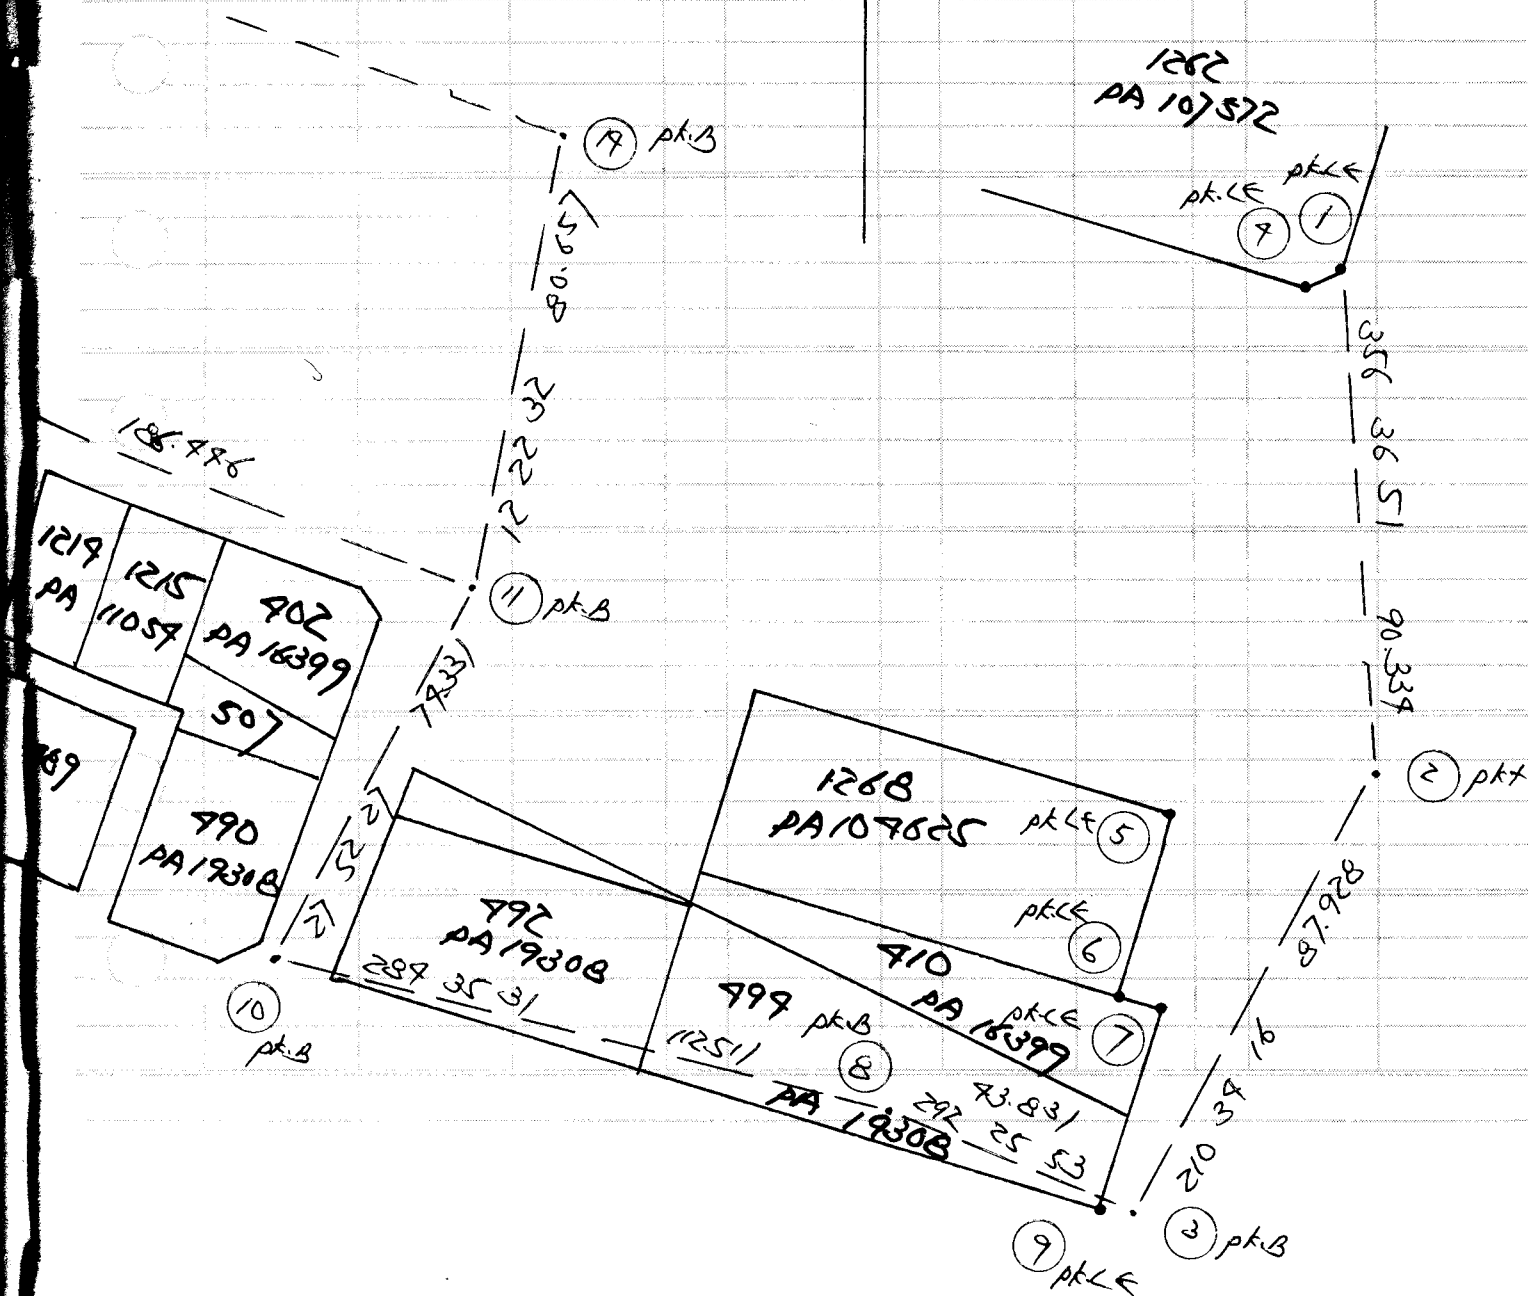

[illegible]

No. Fail

Rajah di muka

Stesen	BEARING / SUDUT		Dari	GARISAN	Ke	Sudut Pukak	Jarak	Suhu	Jarak Antara	Jarak Muktamat
	Penyilang Kiri	Penyilang Kanan	Stn.	Bearing Muktamat	Stn.	(±)			Tupang	

BAYDAR KUACA LUMPUR
SERSEVEN 67
TANPA SKALA