

SEL 757 Bkt Rimau.

No. Fail

Rajah di muka


No.	BEARING POINT			Dati- Stn	GARISAN		Ke St	Sudut P. duk St	Jarak		Jarak Muktamad
	Pasirang Kiri	Pasirang Kanan	Burata		Bearing Muktamad				Jarak 28/3/2011	Jarak Asas	
	Datum Daripada 9/1391			2	9/1391	1	4	80.086			80.086
				pkt	Aj At.	PL					
					Aj M4						
1	9/1391	2/1391	590926	2	590926	3	4	79.999			79.999
2											
3	590926	2390926									
				pkt							
1	Seperti Di Atas	3935916	2	3935916	7	4	123.259				123.259
2											
7	3935916	1635916									
				pkt.							
2	1635916	3935916	761039	7	761039	5	4	123.739			123.739
7											
5	761039	2281039									
				pkt							
7-6	2022329			7	2022329	6	4	10.071	BAL		10.071
5-7	2195501			5	2195501	7	4	56.288	BAL		56.288
5-8	1021132			5	1021132	8	4	5.107	BAL		5.107
3-9	390550			3	390550	9	4	357.002	BAL		357.002
7	2281039	761039	1769108	5	1769108	3	4	157.898			157.898
5											
3	1769108	3569108									
5	3569108	1769108	2390926	3	2390926	2	4	Sila Lihat Atas R.I.			
3											
2	2390926	590926									
					Bering						
					Terdapat						

Sis. Fud

Rajah di muka

Stesen	Bearing Sudut	Dari Stn	Ke Stn	Sudut Pukak	Jarak	Jarak Antara	Jarak Muktamad

DAERAH KLANG.
MUKIM KLANG.

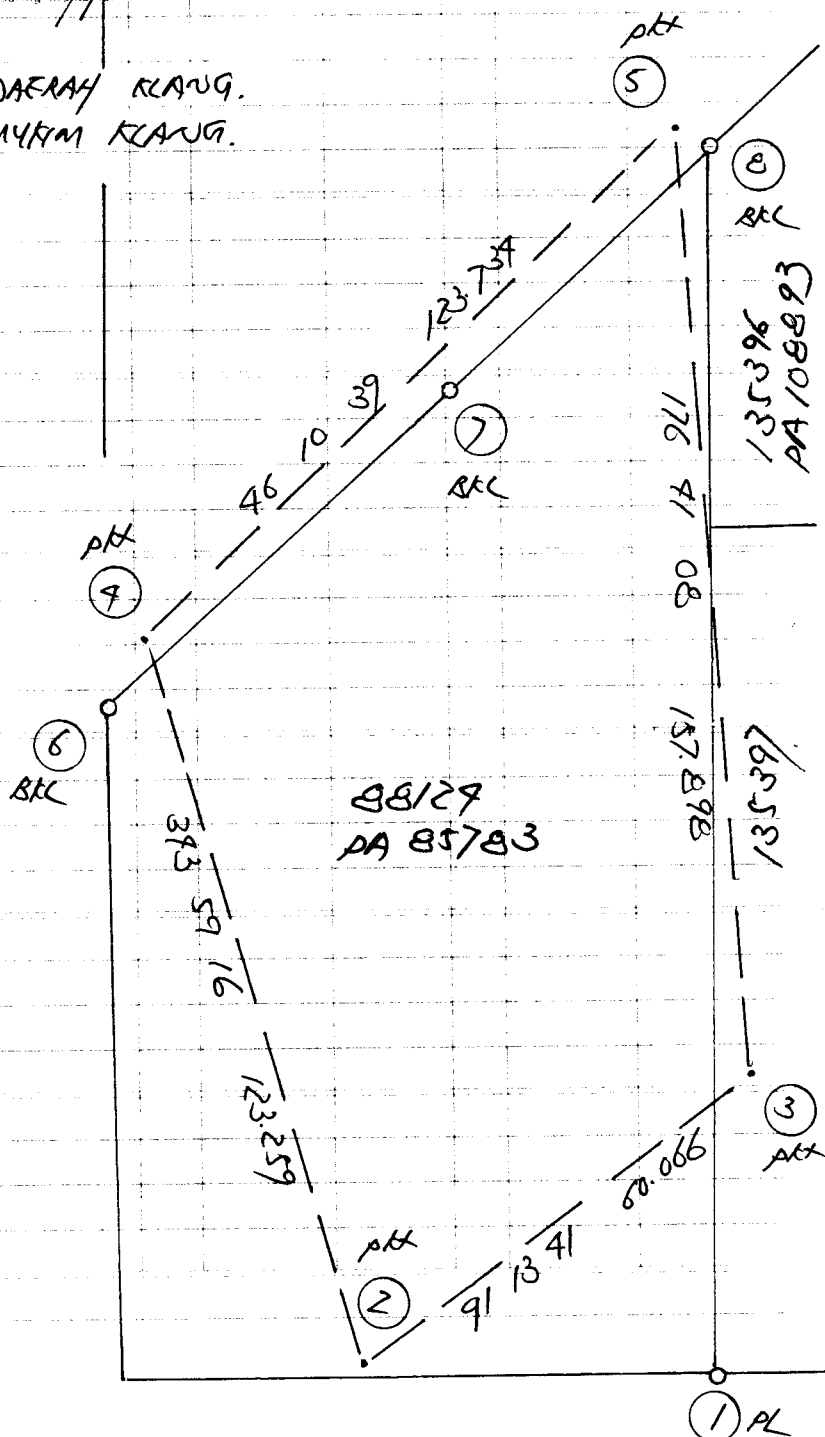

8-1 180 03 37 208.362 ~
180 03 75 208.365 ~
-11" -0.003

8-9 58 00 41 298.333 ~
58 00 17 298.350 ~
+27" -0.017

88/29
PA 85/83

135.397
135.396
PA 108.893

80.066
13 41
91