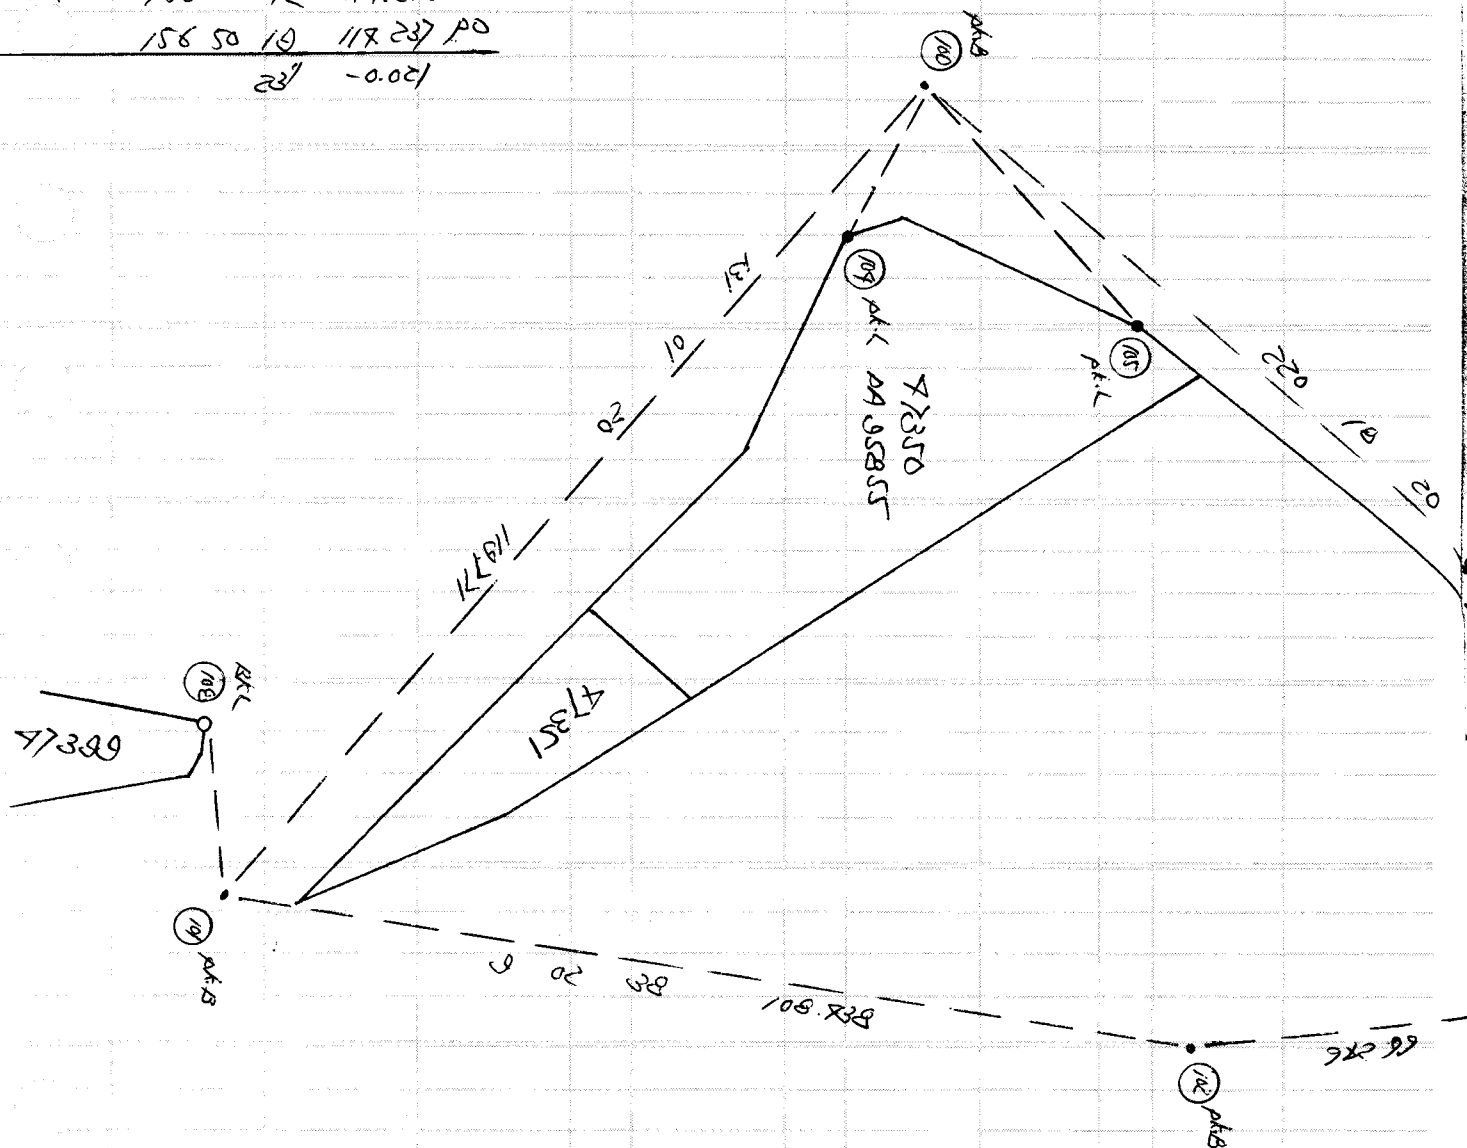


[illegible]

Rajah di muka

[illegible]