

MS 023 Cukur

19/6/08

Ditun Dapada 100 0000 2 32 0555 1 4 117.979 117.979
 Bring Andarin 1- 7 59 55 pk.B Aj At. pk.B
 Dgn M/L

1 100 0000 280 0000 80 86 86 2 72 52 91 3 4 29.613 29.813
 2 M- 7 59 55
 3 80 86 86 280 86 86

BKL
 1 Sepati Si Atas 307 3936 2 296 9531 7 4 29.037 29.037
 2 M- 7 59 55
 7 307 3936 296 9531
 BKL

1 Sepati Si Atas 293 0511 2 285 1106 5 4 180.107 180.109
 2 M- 7 59 55
 5 293 0511 113 0511
 pk.B

2 113 0511 293 0511 259 7717 5 251 5312 6 4 17.893 17.893
 5 M- 7 59 55
 6 259 7717 79 7717
 PL


2 280 0000 100 0000 199 7313 1 191 7908 7 4 76.979 76.979
 1 M- 7 59 55
 7 199 7313 329 7313
 BKL pk.B

2 Sepati Si Atas 332 5912 1 325 0517 8 4 23380 23380
 1 M- 7 59 55
 8 332 5919 152 5919
 BKL pk.L

2	2800000	100 0000	782112	1	702707	9	4	21.662	21.662
1			M-7 59 55						
9	782112	258212							
	BKL								
1	3299313	1999313	1392138	7	1312133	10	4	77.681	77.681
7			M-7 59 55						
10	1392138	1392138							
	pk.B								
1	Seperti Di Atas	320030	7	290625	11	4	21.690	21.690	
7		M-7 59 55							
11	320030	2120030							
	BKL								
2	1051106	2851106	2513029	5		12	4	18.309	18.309
5									
12	2513029	713029							
	BKL								
2	Seperti Di Atas	2570935	5		13	4	11.223	11.223	
5									
13	2570935	770935							
	BKL								
5-14	1222899		5	19	4	10.632	BKL	10.632	
5-15	991020		5	15	4	20.169	BKL	20.169	
2-16	2592316		2	16	4	28.825	BKL	28.825	
7-17	3970511		7	17	4	11.789	BKL	11.789	
7-18	1969803		7	18	4	31.099	BKL	31.099	

18-15 108 17 11 336.777 ✓
108 19 28 336.879 00

- 2 17' -0.097

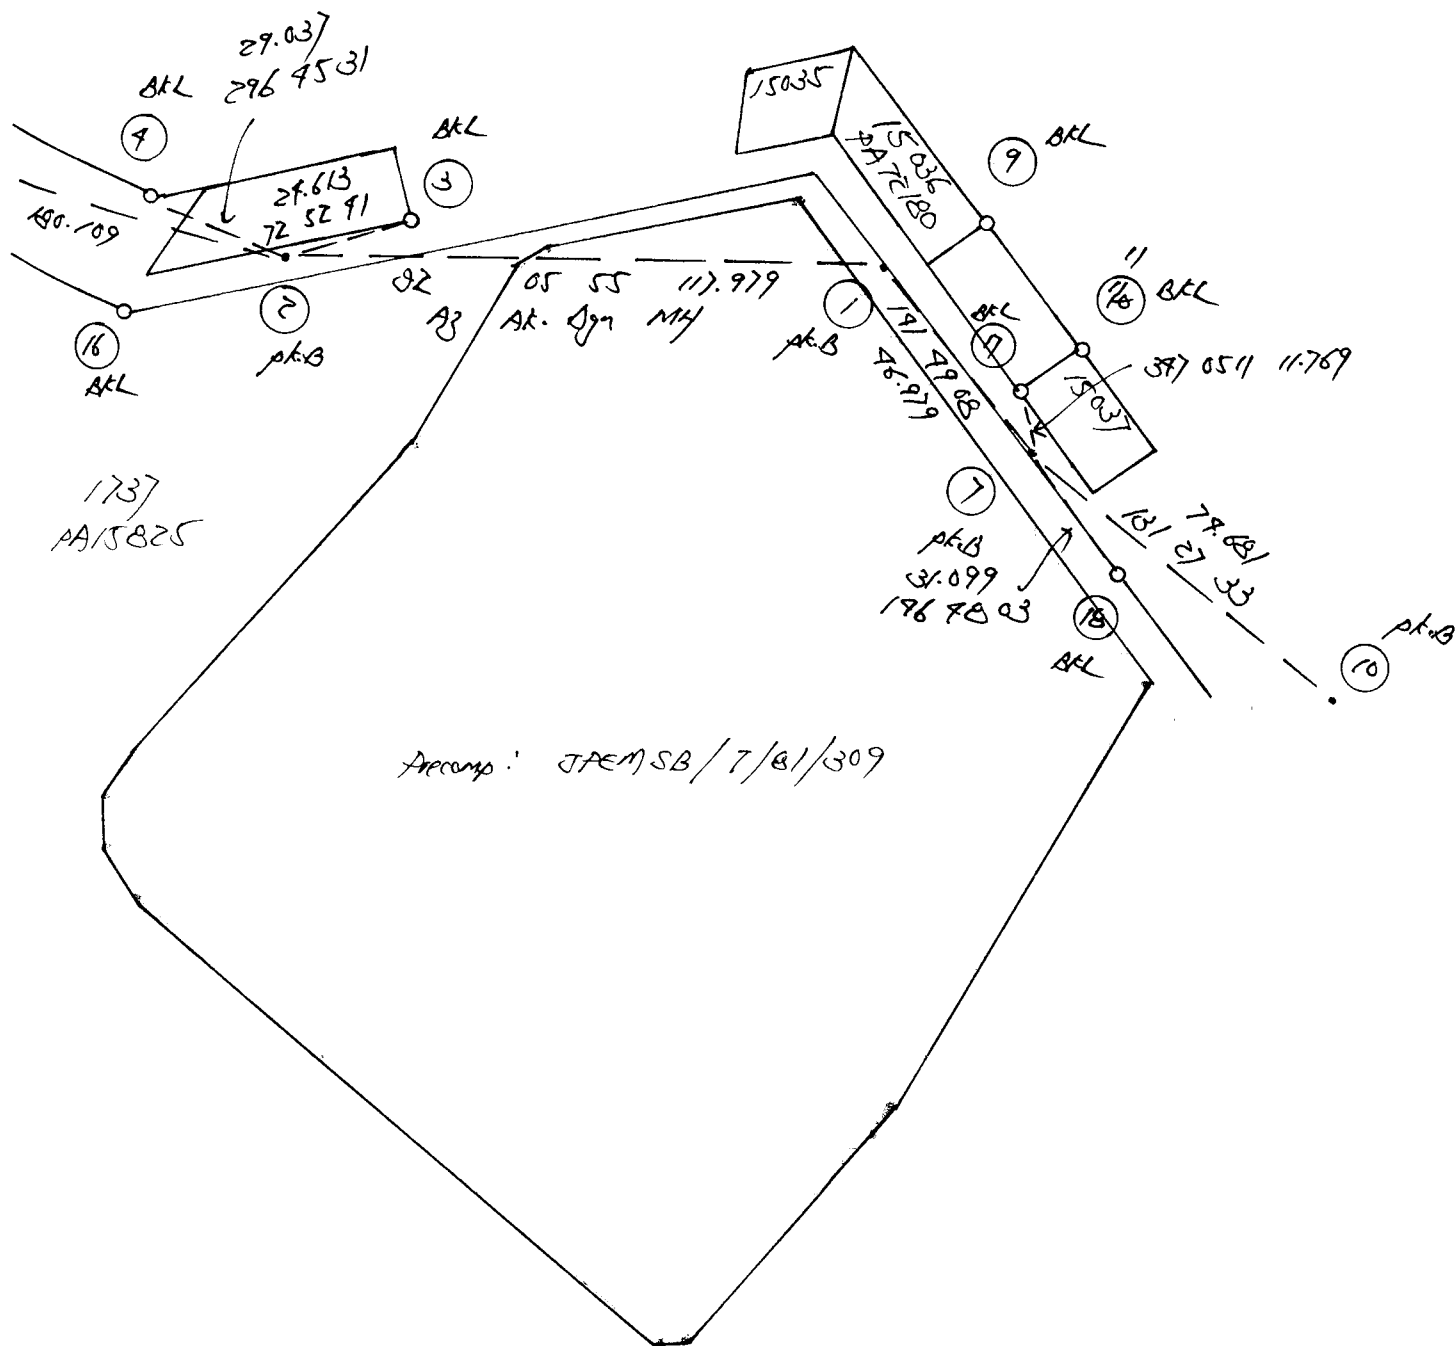

Penilik: NS023 Lukut Tesco Tarikh: 19/09/2008
 Stn. 2 Koordinat: S15795 B12054 Negeri Sembilan
 T.R. 1 B.K. Ms.
 Tiodolit Satu bah. aras ufuk:

Waktu	Sasaran	Ufuk	Gelembong	Puguk
	T.R.	100 00 00		
8 04	M.H.	97 20 45	76 14 44	Waktu purata 8 04 30
8 04	M.H.	96 48 15	76 05 59	Beza dari U.T. - 8 00 00
8 05	M.H.	276 48 30	284 00 22	U.T. 0 04 30
8 05	M.H.	277 21 36	284 04 55	Deklinasi 1 25 10
	T.R.	279 59 50		
	T.R.	100 00 00		
8 06	M.H.	97 21 54	75 47 03	Waktu purata 8 06 30
8 06	M.H.	96 49 06	75 42 06	Beza dari U.T. - 8 00 00
8 07	M.H.	276 49 25	284 25 34	U.T. 0 06 30
8 07	M.H.	277 22 33	284 29 11	Deklinasi 1 25 08
	T.R.	279 59 50		

	Set 1	Set 2
Sudut pugak	13 56 09	14 21 24
Pembetulan	- 0 03 22	- 0 03 15
Altitud	13 52 47	14 18 09
Jarak kutub	88 34 50	88 34 52
Latitud	2 34 41	2 34 41
Azimut M.H. yang dikira	89 10 26	89 11 31
Purata ke M.H.	97 04 47	97 05 45
Selisih:	- 7 54 21	- 7 54 14
Purata ke T.R.	99 59 55	99 59 55
Azimuth T.R. sebenar	92 05 34	92 05 41
Pembetulan aras	+ 0 00 00	+ 0 00 00
Tirusan	+ 0 00 17	+ 0 00 17
Bering grid T.R.	92 05 51	92 05 58
Purata bering grid T.R.	92 05 55	

Tarikh

Aras

Dibuat untuk

22

Daripada

不

Jarak	Catatan
TBM F1953 F2	
CP P/ F7 F10	
TBM F1954 (Aksi Bus stop) plat ONEM 7850	
TBM F1958 not at	Lukut TBM F1955 Sg. Pak mai Sipang
TBM F1955 not at bus Jember	
Bm US037 AC: 51540	