

No. Fail *SEK 020 Ampang Campuran* *Shore 2.*

Rajah di muka

Stesen	BEARING / SUDUT			Dari Stn.	GARISAN Bearing Muklamar	Ke Stn.	Sudut Pugak (±)	Jarak	Suhu 23/3/05	Jarak Antara Tupang	Jarak Mt
	Penyilang Kiri	Penyilang Kanan	Purata								
	<i>Baring Daripada FB</i>										
	<i>37 m/s B R1</i>										
			<i>181 20 33</i>	<i>116</i>		<i>115</i>	<i>1</i>	<i>127.072</i>			<i>127.</i>
								<i>127.072</i>			
<i>115</i>	<i>181 20 33</i>	<i>1 20 33</i>	<i>357 39 07</i>	<i>116</i>	<i>357 38 28</i>	<i>130</i>	<i>4</i>	<i>127.072</i>			<i>127.0</i>
<i>116</i>			<i>M- 357</i>		<i>357 38 31</i>			<i>127.072</i>			
<i>130</i>	<i>357 39 07</i>	<i>177 39 07</i>									
	<i>pt.B CNO 780, larang ikan emas 19)</i>										
<i>116</i>	<i>177 39 07</i>	<i>357 39 07</i>	<i>358 70 88</i>	<i>130</i>	<i>358 70 85</i>	<i>131</i>	<i>4</i>	<i>57.510</i>			<i>57.5</i>
<i>130</i>			<i>M- 357</i>		<i>358 70 88</i>			<i>57.510</i>			
<i>131</i>	<i>358 70 88</i>	<i>178 70 88</i>									
	<i>pt.B CNO 789, larang ikan emas 19)</i>										
<i>116</i>	<i>Seperti Di Atas</i>	<i>316 35 00</i>	<i>130</i>	<i>316 37 47</i>	<i>132</i>	<i>4</i>		<i>102.657</i>			<i>102.</i>
<i>130</i>			<i>M- 357</i>		<i>316 37 20</i>			<i>102.658</i>			
<i>132</i>	<i>316 35 00</i>	<i>136 35 00</i>	<i>C 4</i>								
	<i>pt.B (end of larang ikan emas 15)</i>										
<i>116</i>	<i>Seperti Di Atas</i>	<i>172 18 56</i>	<i>130</i>	<i>172 18 47</i>	<i>133</i>	<i>4</i>		<i>10.513</i>			<i>10.</i>
<i>130</i>			<i>M- 357</i>		<i>172 18 20</i>						
<i>133</i>	<i>172 18 56</i>	<i>352 18 56</i>									
	<i>BEL (20) CNO</i>										
<i>116</i>	<i>Seperti Di Atas</i>	<i>12 13 52</i>	<i>130</i>	<i>12 13 43</i>	<i>137</i>	<i>4</i>		<i>5.127</i>			<i>5.12</i>
<i>130</i>			<i>M- 357</i>		<i>12 13 16</i>						
<i>137</i>	<i>12 13 52</i>	<i>192 13 52</i>									
	<i>BEL</i>										
<i>130</i>	<i>178 70 88</i>	<i>358 70 88</i>	<i>1 79 29</i>	<i>131</i>	<i>1 78 58</i>	<i>135</i>	<i>4</i>	<i>23.</i>			<i>23.0</i>
<i>131</i>			<i>M- 357</i>		<i>1 78 53</i>			<i>23.697</i>			
<i>135</i>	<i>1 79 29</i>	<i>181 79 29</i>									
	<i>pt.L</i>										

No. Fail

Rajah di muka

No. Fail		BEARING / SUDUT			Dari	GARISAN		Ke	Sudut Pukak	Jarak	Suhu	Jarak Antara Tupang	Jarak Mukta
Stesen	Penyilang Kiri	Penyilang Kanan	Purata	Stn.	Bearing Mukamat	Stn.	(±)						
132	09 22 07	279 22 07	201 15 35	170	201 19 96	173	4		207.858				207.8
170			M- 351		201 19 98				207.859				
173	201 15 35	21 15 35	C- 11.										
	pk.B (R119)												
170	21 15 35	201 15 35	03 20 27	173	03 19 35	177	4		56.990				58.95
173			M- 351		03 19 36				56.990				112.91
177	03 20 27	273 20 27	C- 15						112.971				
	pk.B (R117)												
173	273 20 27	03 20 27	09 59 15	177	09 53 20	175	4		127.273				127.21
177			M- 351		09 53 21	116							
175	09 59 15	279 59 15	C- 10										
116													
177	279 59 15	09 59 15	357 39 29	116	357 38 31	130			Sila Rujuk M/S 1 R1				
116			M- 351		Bering								
130	357 39 29	177 39 29	C- 22		Tertutup.								
											26/9/85		
130	181 20 33	1 20 33		116		131							
116													
	131												
130	357 39 07	117 39 07	198 12 37	116	198 12 01	175	4		18.030				18.03
116			M- 351										
175	198 12 37	18 12 37											
BKL													
177	03 20 27	273 20 27	255 39 08	173	255 38 17	176	4		29.218				29.21
173			M- 351						(mini)				
176	255 39 08	75 39 08	M2- 15										
	pk.L												

Bering 11-6 - 130 Sibara 357 39 29
 Spatitum Sibara 357 39 07

Tikuan

Pembetulan

+ 221 ctk 6 stn
 - 0.42 per stn
 2.07

106 29 29 0.019
 L: 0.005 - 0.008
 CM 1:70.930

No. Fail

Surau


Rajah di muka


Stesen	BEARING / SUDUT			Dari Stn.	GARISAN		Ke Stn.	Sudut Pugak (±)	Jarak	Suhu	Jarak Antara Tupang	Jarak Mukamat
	Penyilang Kiri	Penyilang Kanan	Purata		Bearing Mukamat							
21	211 36 90	31 36 90	2 20 13	23			200	4	57.917 13/5/05 68.963			68.963
23									68.967	110%		700
200	2 20 13	182 20 13								100%		700
	pk. 8											
21	12. 4. A.	375 2237		23			201	4	50.232			50.232
23										100%		750
201	375 2237	165 2237								95%		700
	pk. 4											
23	182 20 13	2 20 13	113 00 12	200			202	4	87.673			87.673
200										107%		700
202	113 00 12	293 00 12								107%		615
	pk. 2.								87.675 25/5/05			
202	293 00 12	113 00 12		200			203	4	67.397			
200												
203	330 73 55											
									87.679			
202	113 00 12	293 00 12	150 73 55	200			203	4	67.397			67.397
200										107%		615
203	150 73 55	330 73 55								103%		615
	pk. 4											
130	357 39 07	177 39 07	80 55 15	116	80 57 39		207	4	52.738			52.738
116			m- 381		83 AK.							
207	80 55 18	280 55 15			83 AK.							
	pagu rumah.				83 AK.							

No. Fail

Stesen	BEARING / SUDUT	Dari	Ke	Sudut Pukak	Jarak	Suhu	Jarak
Penyilang Kiri	Penyilang Kanan	Stn.	Bearing Muktamat	(±)			
		Purata			7000	7000	7000

DAERAH ULU KANGAT
BANDAR AMPANG.
SEK 15
TAYPA SKACA.

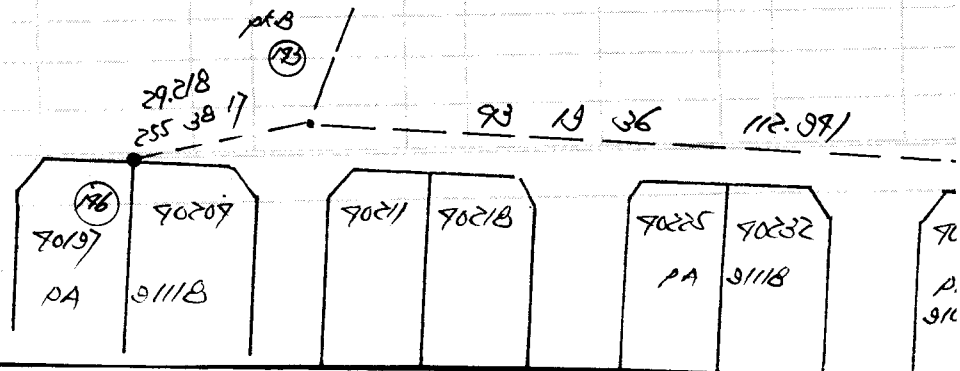

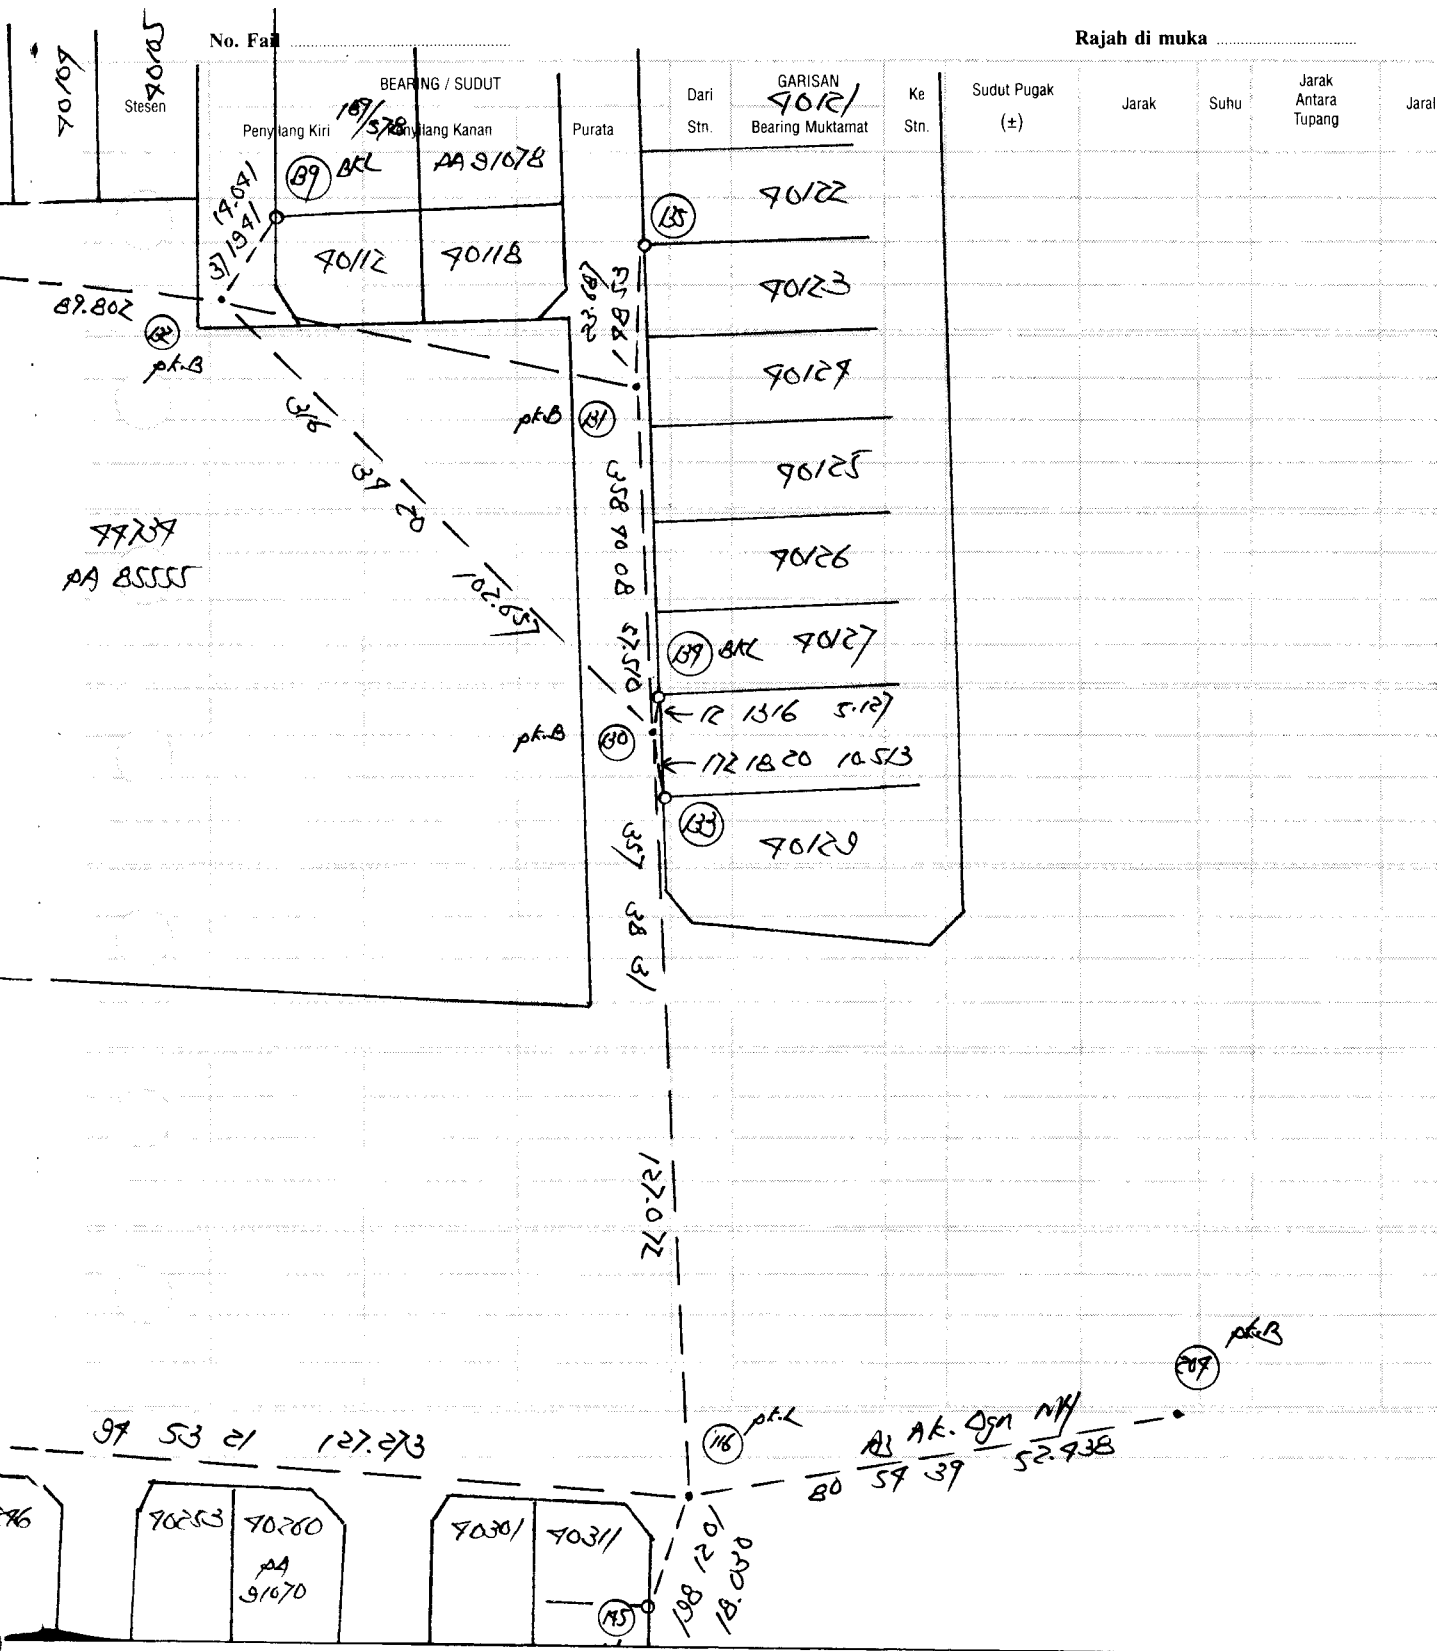

Formula:

$$\text{Kosain AZIMUT} = \frac{\text{Kos P} - \text{Sain} \phi \text{ Sain } \alpha}{\text{Kos } \phi \text{ Kos } \alpha}$$
[illegible]

W.U.	-	Waktu Un
W.T.K.	-	Waktu Te