

45017


Rajah di muka

Stesen	BEARING / SUDUT			Dari Stn.	GARISAN Bearing Mukhtamat	Ke Stn.	Sudut Pugak (±)	Jarak	Suhu 19/1/06	Jarak Antara Tumpang	Jarak M
	Penyilang Kiri	Penyilang Kanan	Purata								
1	Bering Daripada	7600 00	2	75 17 08	1	4	111.037	111.0			
2	PC Bering	M- 72 52'	pt.B	Aj At. Dgn MH	pt.B						
1	7600 00	25600 00	19/2550	2	190 92 58	3	4	89.882	89.885		89.9
2		M- 72 52'									
3	19/2550	321 2550	pt.B								
2	321 2550	19/2550	233 50 20	3	233 07 28	4	4	5838			5.8
3		M- 72 52'									
4	233 50 20	53 50 20	PL								
2	Seperti Di Atas	138 23 17	3	137 90 25	5	4	51.758	51.758			51.7
3		M- 72 52'									
5	138 23 17	318 23 17	pt.B								
3	318 23 17	138 23 17	179 25 32	5	173 92 40	6	4	10.559			10.5
5		M- 72 52'									
6	179 25 32	354 25 32	pt.L								
3	Seperti Di Atas	213 37 90	5	212 59 88	7	4	27.269				27.2
5		M- 72 52'									
7	213 37 90	33 37 90	PL								
3	Seperti Di Atas	226 25 50	5	225 92 58	8	4	76.859	76.861			76.8
5		M- 72 52'									
8	226 25 50	76 25 50	pt.B, pt.A								

[illegible]

No. Fail

Rajah di muka

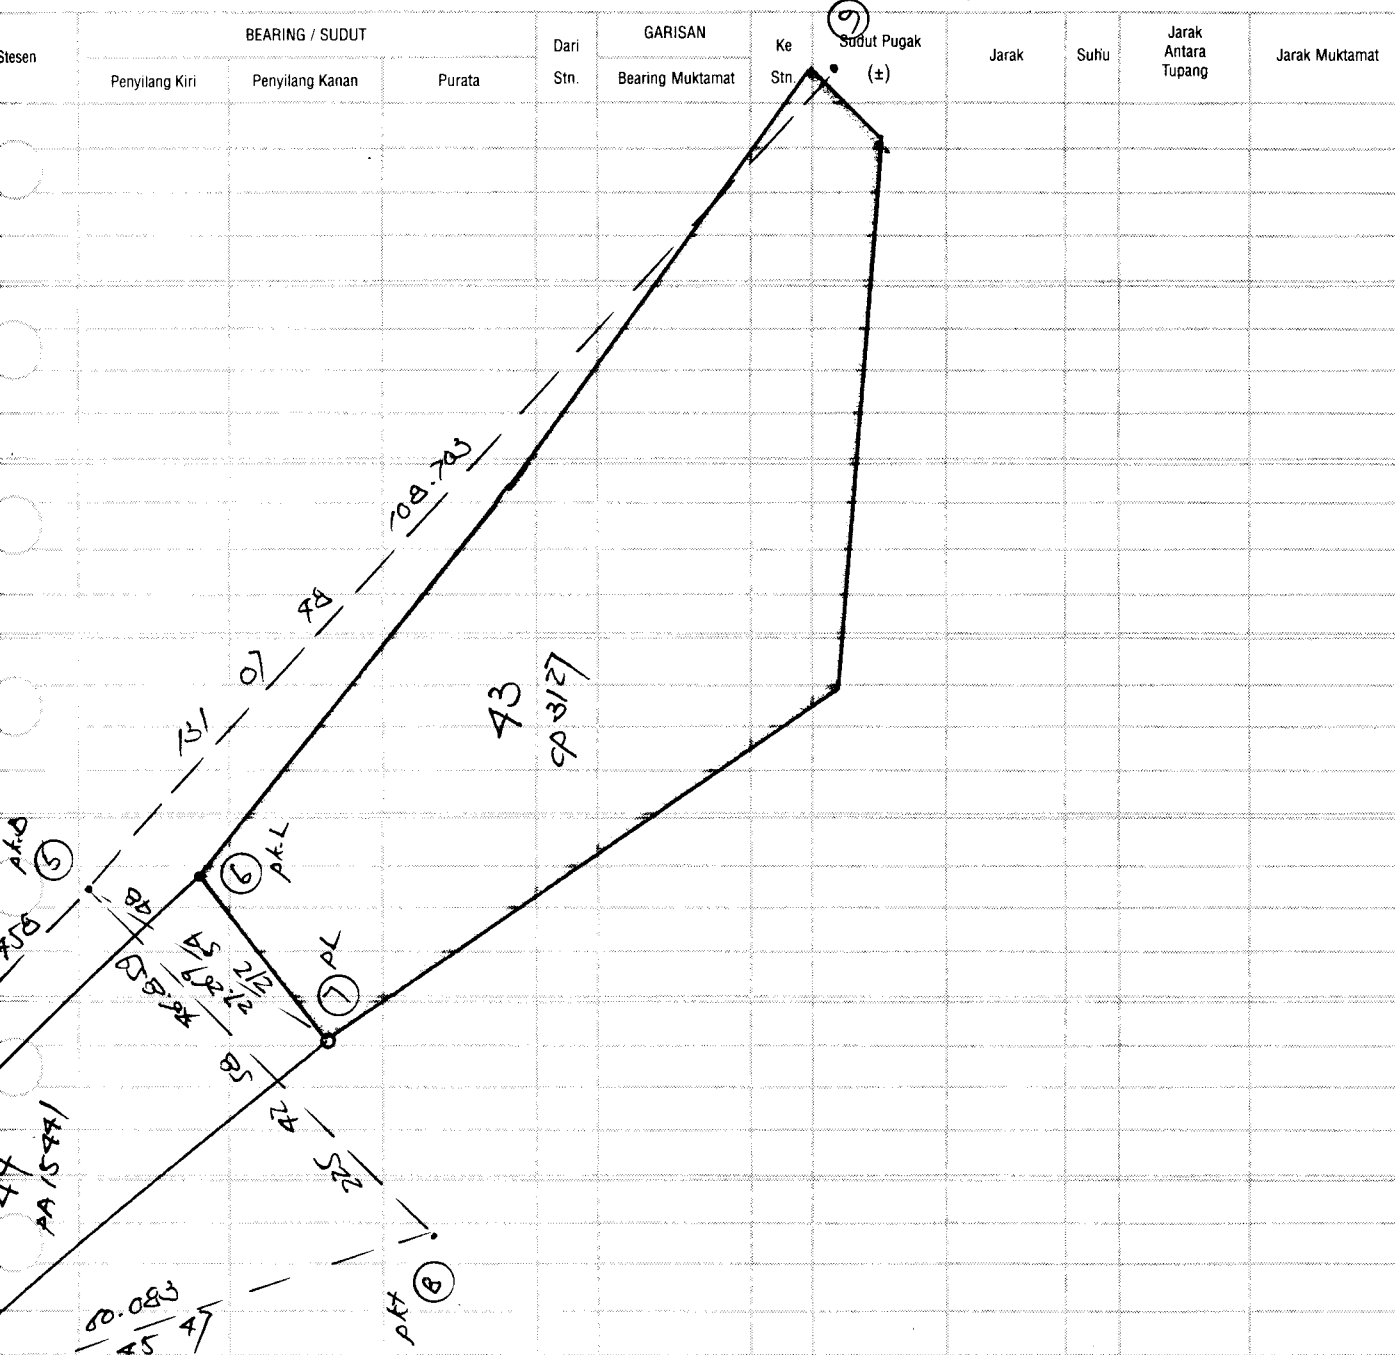

CERAPAN MATAHARI BAGI AZIMUT

Penilik Foo Chai Yang Hari Isnin Tarikh 18/9/66 Bulan 18/9/66 Tahun 1966

Stesen 2 T.R. 1 B.K. Ms. Tiodolait (Jenis) I Bah. Aras Ufuk - a 1

Formula:

$$\text{Kosain AZIMUT} = \frac{\text{Kos P} - \text{Sain } \phi \text{ Sain } \alpha}{\text{Kos } \phi \text{ Kos } \alpha}$$

$$\text{Pembetulan Aras} = \frac{2}{3} (\pm R - \pm L) \text{ tenjen } \alpha$$

Waktu	Ufuk			Gelem-bong		Pugak			Tilkan ①	Bila waktu jam tangan tidak dalam lingkungan 3 menit daripada waktu piawai Hitung waktu umum.	W.U. - 12 ^J + W.T.K. - G. Bu			
J m	P.Ki	T.R.	80	00	00	Ki	Ka						12 ^J	
		⊕	80	30	47		73	03	30					
		⊕	80	06	37		72	57	11					
	P.Ka	⊕	200	06	57		287	12	23					
		⊕	200	40	23		287	16	28					
Purata ①	T.R.													
J m														
86							17	07	00	Purata Tinjau				
	Purata Ke matahari		80	23	28		2	73		Biasan & Bedalihat				
	Purata Ke TR						17	07	17	Tinjau Dilaras				
J m	P.Ki	T.R.												
		⊕	80	41	06		72	30	30					
		⊕	80	07	45		72	29	48					
	P.Ka	⊕	200	08	08		287	46	02					
		⊕	200	41	56		287	51	58					
Purata ②	T.R.													
J m														
							17	40	41	Purata Tinjau				
	Purata Ke matahari		80	24	44		2	36		Biasan & Bedalihat				
	Purata Ke TR						17	08	05	Tinjau Dilaras				
Kordinat Origin 1/S	979			m		Kordinat Origin 1/B	292			m		Purata Bg. Gerid T.R.	75 17 08	
Stesen 1/S	23032			m		Stesen 1/B	11081			m		Ditilik oleh	18/9/66 <i>[Signature]</i>	
Jumlah/Sel.	22883			m		Jumlah/Sel.	11730			m				
Jumlah/Sel. × 0.03256 ±	-0 12 25					Sel. G. Bujur - $\frac{\text{Jum. Sel.}}{\text{Sel.}} \times 0.03246 \pm$	5' 21"					Dihitung oleh		
G. Lintang Origin U	2 42 47					Sel. G. Bujur × Sain G. Lintang -								
G. Lintang Stesen U	2 30 19					T (-) / B (+) Tirusan	- 17'					Tarikh		

P.Ki - Penyilang Kiri
P.Ka - Penyilang Kanan

T.R. - Tanda Rujuk
Sel - Selisih

W.U. - Waktu Umum
W.T.K. - Waktu Tempatan Ketara

Tarikh *MSU/*
Pantai Sayang
 Daripada

Aras
 Dibuat untuk
 Ke

13

Pandangan Belakang	Pandangan Antara	Pandangan Hadapan	Naik	Turun	Aras Yang Dilaras	Jarak	Catitan
1.289 (1923)					5.283		BM 110216 (RC: 5.383m)
1.388 (1959)		1.586 (1518)					
1.916 (1968)		1.776 (1583)					
1.967 (1981)		1.881 (1617)					
1.612 (1529)		1.291 (1801)					
7.182 /		1.065 (1399)			5.036		78m 11035 awal di bu stop, bertukar dgn masjid kariah bgsn pinggir.
		7.329					di hadapan kompleks seni priary.
1.291 (1928)					5.036		78m 1035 di kuarang jln pd ke Linggi.
1.397 (1958)					7.930		BM 110222 (18m 11035) di hadapan masjid
2.118 (1675)		1.095 (1383)					di
2.777 (1911)		0.891 (1185)					kanis bgsn priary.
1.975 (1688)		0.903 (1296)					
3.315 (11088)		0.638 (1202)					
1.518 (1897)		0.195 (1068)					
1.187 (1390)		2.228 (1730)					
14.17 -		1.728 (1545)			11.387		SM KL
		7.226					
0.828 (1272)					11.387		SM KL
0.791 (1243)		2.380 (1781)			10.735		SM KL
		1.767 (1560)			9.709		SM KL