

[illegible]

[illegible]

Rajah di muka

[illegible]

Stesen	BEARING / SUDUT			Dari	GARISAN	Ke	Sudut Pukak	Jarak	Suhu	Jarak Antara Tupang	Jarak Muklumat
	Penyilang Kiri	Penyilang Kanan	Purata	Stn.	Bearing Muklumat	Stn.	(±)				
25	267/3311	87/3311	77/3611	26	47/1733	29	11	21.8/7			21.8/7
26			MT 2 91 22								
29	77/3611	227/3611									
	BLK										
25	129 02 20	309 02 20	350 21 86	6	353 03 08	2		Lihat m/s 1 R5			
6			MT 2 91 22								
2	350 21 86	170 21 86									
Boring 5-2 Dibaca 350 21 86 Sepatutnya Dibaca 350 21 86 Tikaian Nij Ambukan. Nij											

Rajah di muka

No. Fail

BEARING / SUDUT

Stesen

Penyilang Kiri

Penyilang Kanan

Purata

Dari
Stn.

GARISAN

Bearing Muktamat

Ke
Stn.Sudut Pukak
(±)

Jarak

Suhu

Jarak
Antara
Tupang

Jarak Muktamat

889

AA 87139

Rajah di muka

pt.L 3

288

88.10 /
32 18

PL 5

pt.B 2

89 91 22

DAERAH RETAKING.
BANDAR SHAH ALAM
SEKSYEN 6.

SYIT 32A
TANPA SKALA

718
FLAT
AA 87296

pt.L 8

123.03 08

103.221

pt.B 6

26.67 /
34 37

pt.L 9

396

pt.L 10

383

AA 72950

pt.B 11


382

pt.B 7

169/516

9-12 175 151 73.323 N
175 1739 73.911 PO
732' 70.012

3-9 190 5910 181.335 N
190 5870 181.375 PO
730' N1/

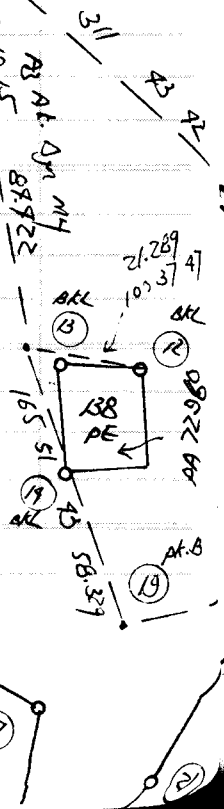

888
PA 87/99

No. Fail

Rajah di muka

[illegible]

CERAPAN MATAHARI BAGI AZIMUT

 Penilik Foo Chee Yeng Hari Khamis Tarikh 2/11/06 Bulan 2/11/06 Tahun 2006

 Stesen 11 T.R. 6 B.K. Ms. Tiodolait (Jenis) I Bah. Aras Ufuk - a

Formula:

$$\text{Kosain AZIMUT} = \frac{\text{Kos P} - \text{Sain } \phi \text{ Sain } \phi}{\text{Kos } \phi \text{ Kos } \phi}$$

SEC 283 Sta Akm Sec 6 PMS.

$$\text{Pembetulan Aras} = \frac{2}{8} (\pm R - \pm L) \text{ tenjen } \phi$$

Waktu		Ufuk			Gelem-bong		Pugak			Tilkan ①	Bila waktu jam tangan tidak dalam lingkungan 3 menit daripada waktu piawai Hitung waktu umum.	W.U. - 12 ^J + W.T.K. - G. Bujur - E		
J	m	P.Ki	T.R.		Ki	Ka						12 ^J		00 ^m
				376	28	53								
		⊕		109	16	90		70	90	10				
		⊕		103	93	28		70	33	38				
		P.Ka	⊕	283	95	00		289	36	16				
		⊕		289	20	29		289	99	06				
Purata ①		T.R.		376	29	03								
J	m													
8 ²³								19	31	39				
		Purata Ke matahari		109	01	29		2	21					
		Purata Ke TR						19	29	18				
J	m	P.Ki	T.R.											
		⊕		109	27	10		69	38	07				
		⊕		103	53	58		69	29	30				
		P.Ka	⊕	283	55	05		290	37	33				
		⊕		289	30	96		290	99	07				
Purata ②		T.R.												
J	m													
8 ²⁷								20	33	31				
		Purata Ke matahari		109	11	95		2	12					
		Purata Ke TR						20	31	19				
Kordinat Origin U/S		55961			m		Kordinat Origin Y/B		21759			m		
Stesen Y/S		9633			m		Stesen Y/B		21799			m		
Jumlah/Sel.		Y/S 65599			m		Jumlah/Sel.		T/B 10			m		
Jumlah/Sel. x 0.03256 ±		3 90 99					Sel. G. Bujur = $\frac{\text{Jum.}}{\text{Sel.}} \times 0.03246 \pm$		32					
G. Lintang Origin U		0 35 36					Sel. G. Bujur x Sain G. Lintang -							
G. Lintang Stesen U		3 5 13					T (-) / B (+) Tiruan		- 21					
P.Ki - Penyilang Kiri							T.R. - Tanda Rujuk							
P.Ka - Penyilang Kanan							Sel - Selisih							
							W.U. - Waktu Umum							
							W.T.K. - Waktu Tempatan Ketara							

 2/11/06. 

Tarikh Aras

Dibuat untuk

26

Daripada

Ke

Pandangan Belakang	Pandangan Antara	Pandangan Hadapan	Naik	Turun	Aras Yang Dilaras	Atas	Catatan
1.518	(496)	(6.58)				100.000	78M 5-02
	1.993					99.525	1.025
2.832	(9.29)	0.038	(0.11)			101.989	1.19
	2.523	(8.28)				101.783	78M 5-01
2.589	(8.73)	0.952	(1.98)			103.869	CP
	4.729	(7.67)				103.709 103.709	1.11
2.899	(9.10)	0.906	(1.33)			106.027	CP
0.985	(3.16)	0.211	(0.59)			108.710	1.26
2.399	(7.70)	2.098	(6.88)			107.557	CP
	0.098	(2.29)				109.208	78M 1.10.59
		1.329	(8.35)			108.577	1.22
13.47		7.530					78M 5-03