

Tarikh

Dibuat untuk

W/P 0083 MOKWA Ckms

Daripada


Ke

dekung

Pandangan Belakang	Pandangan Antara	Pandangan Hadapan	Naik	Turun	Aras Yang Dilaras	Jarak	Catitan
1.705 (18.61)	1.273 (17.08)				78.377 78.559		TBM F112 nail on top of cult. sat F2
0.590 (1.98)	1.200 (11.85)						2 sty. Rince hua.
0.095 (0.31)	3.289 (11.15)						
0.126 (0.41)	3.200 (11.15)						
1.755 (18.77)	1.501 (17.92)						
1.325 (18.05)	1.538 (15.03)						
1.622 (15.32)	1.917 (16.29)						
1.725 (17.68)	1.529 (15.02)						TBM F112 2 sty. fence
1.888 (15.59)	1.398 (14.55)						TBM F112 nail on top of cult.
7.231	16.957				71.171		
1.873 (16.15)					71.171		TBM F112
1.594 (15.23)	1.289 (17.23)						
1.911 (16.27)	0.869 (12.85)						
1.365 (17.94)	1.222 (17.01)						TBM F112 nail on top of drain.
6.781	5.581				72.338		

Daripada Ke

Pandangan Belakang	Pandangan Antara	Pandangan Hadapan	Naik	Turun	Aras Yang Dilaras	Jarak	Catitan
0.061 (2.82)					72.339		78M F1122 STAKE
0.075 (0.25)	2.739	(18.99)					
0.080 (0.26)	3.850	(12.63)					
0.072 (0.24)	3.611	(11.85)					
0.787 (1.60)	7.015	(13.11)					
0.222 (0.73)	3.789	(12.92)					
0.097 (0.32)	3.120	(10.29)					
0.178 (0.59)	2.962	(9.72)					
0.216 (0.71)	3.271	(10.73)					
2.288 /	1.549	(5.07)			75.726 /		78M F1123 nailed on top of vump bar.
1.549					75.726		78M F1123
1.371 (4.50)	1.711	(5.61)					
1.762 (7.80)	1.992	(8.09)					
1.685 (5.53)	1.130	(3.70)					
1.039 (3.91)	1.819	(5.97)					
1.158 (3.80)	2.109	(6.92)					
1.371 (4.90)	1.785	(5.85)			73.939		78M F1129 nailed on house skirt
8.259 /	10.076 /						4100g (Ats Motor Load) fat pen oak pengany

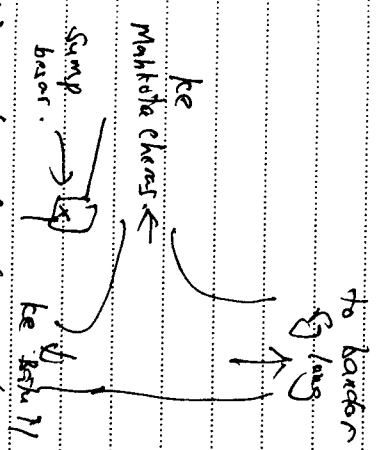

Tarikh Aras

Dibuat untuk

Daripada

Ke

Pandangan Belakang	Pandangan Antara	Pandangan Hadapan	Naik	Turun	Aras Yang Dilaras	Jarak	Catitan
1.371 (1.740)		1.844	(15.05)		23.839		78M R1124
1.281 (1.720)							
1.079 (1.354)		1.947	(16.39)				
2.542 (18.34)		1.380	(17.76)				
3.005 (19.86)		0.330	(1.08)				
3.712 (11.90)		0.330	(1.08)				
3.726 (12.23)		0.293	(0.96)				
3.381 (11.09)		0.233	(0.76)				
3.235 (10.62)		0.083	(0.18)				
0.869 (12.85)		1.398	(14.59)				
23.921/		1.826	(15.99)		58.286		78M R1125 everyhome (EVERHOME show room) main path.
0.530 (1.17)					58.286		R1125
0.355 (1.16)		2.952	(19.69)				
0.189 (0.62)		2.645	(18.66)				
0.383 (1.25)		3.746	(11.18)				
0.357 (1.18)		3.727	(12.23)				
0.097 (0.16)		3.310	(10.86)				
0.880 (2.89)		2.967	(19.74)				
2.711/		2.796	(18.19)		39.504		57M R2 (Ayahat Alora Cheras) PC: 39.504 R208 N/S 76
		21.503					