

No. Fail DEL 338 Gasing Church.

Rajah di muka

Stesen	BEARING / SUDUT		Dari Stn.	GARISAN Bearing Mukhtamat	Ke Stn.	Sudut Pukak (±)	Jarak	Suhu	Jarak Antara Tupang	Jarak Mukhtamat
	Penyilang Kiri	Penyilang Kanan								
	206 00 00	206 00 00								
	205 79 37	205 58 26	3	205 58 26	3	4	73.878 BKL		73.878	
	206 00 16	206 09 05	9	206 09 05	9	4	73.708 PL		73.708	
	206 01 20	206 10 09	5	206 10 09	5	4	62.029 PL		62.029	
	236 76 09	236 59 58	6	236 59 58	6	4	5.012 BKL		5.012	
	237 51 32	238 00 21	7	238 00 21	7	4	5.072 PL		5.072	
	299 12 03	299 20 52	8	299 20 52	8	4	92.013 PL		92.013	
	288 17 16	288 26 05	9	288 26 05	9	4	31.198 BKL		31.198	
	300 28 35	300 37 29	10	300 37 29	10	4	91.910 BKL		91.910	
	127 10 27	127 28 16	11	127 28 16	11	4	22.212 BKL		22.212	
	107 05 29	107 18 18	12	107 18 18	12	4	32.052		32.052	
	287 05 29	287 05 29					32.055			
	39 05 26	39 05 26	13	39 17 98	13	4	52.781		52.781	
	202 52 07	203 00 56	17	203 00 56	17	4	60.699		60.699	

No. Fail

Rajah di muka

Stesen	BEARING / SUDUT			Dari Stn.	GARISAN		Ke Stn.	Sudut Pukak (±)	Jarak	Suhu	Jarak Antara Tupang	Jarak Mukamat
	Penyilang Kiri	Penyilang Kanan	Purata		Bearing	Mukamat						
12	22 5207	202 5207										
19												
15	123 4236	} MT 8' 49"		19	123 5125	15	4	7.227	BKL		7.227	
16	352 4755			19	352 5649	16	4	13.785	PL		13.785	
17	257 5323			19	255 0212	17	4	10.290	PL		10.290	
18	223 2928			19	223 3317	18	4	26.258	PL		26.258	
19	223 5851			19	229 0740	19	4	26.286	BKL		26.286	
20	202 83 2			19	202 5151	20	4	69.809	BKL		69.809	
12	219 0526	39 0526	35 3149	13	35 7828	21	4	37.773			37.773	
13			MT 8' 49"									
21	25 3139	215 3139										
	pk.B											
12	Sipat di Atas	278 2649		13	278 3538	22	4	55.036			55.036	
13			MT 8' 49"					55.039				
22	278 2649	98 2649										
	pk.B											
13	98 2649	278 2649		22		23	4					
22												
23	200 3701	} MT 8' 49"		22	200 7550	23	4	10.963	PL		10.963	
24	199 3757			22	199 7373	24	4	10.965	BKL		10.965	
25	357 5025			22	357 5917	25	4	30.099	BKL		30.099	

Rajah di muka


[illegible]

No. Fail

Rajah di muka

Stesen	BEARING / SUDUT	Purata	Dari Stn.	GARISAN	Ke Stn.	Sudut Pukak (±)	Jarak	Suhu	Jarak Antara Tupang	Jarak Mukamat
	Penyilang Kiri	Penyilang Kanan		Bearing Mukamat						

TOWN OF RETAKING JAYA
DISTRICT OF KUALA LUMPUR
85-10-111-13
NOT TO SCALE

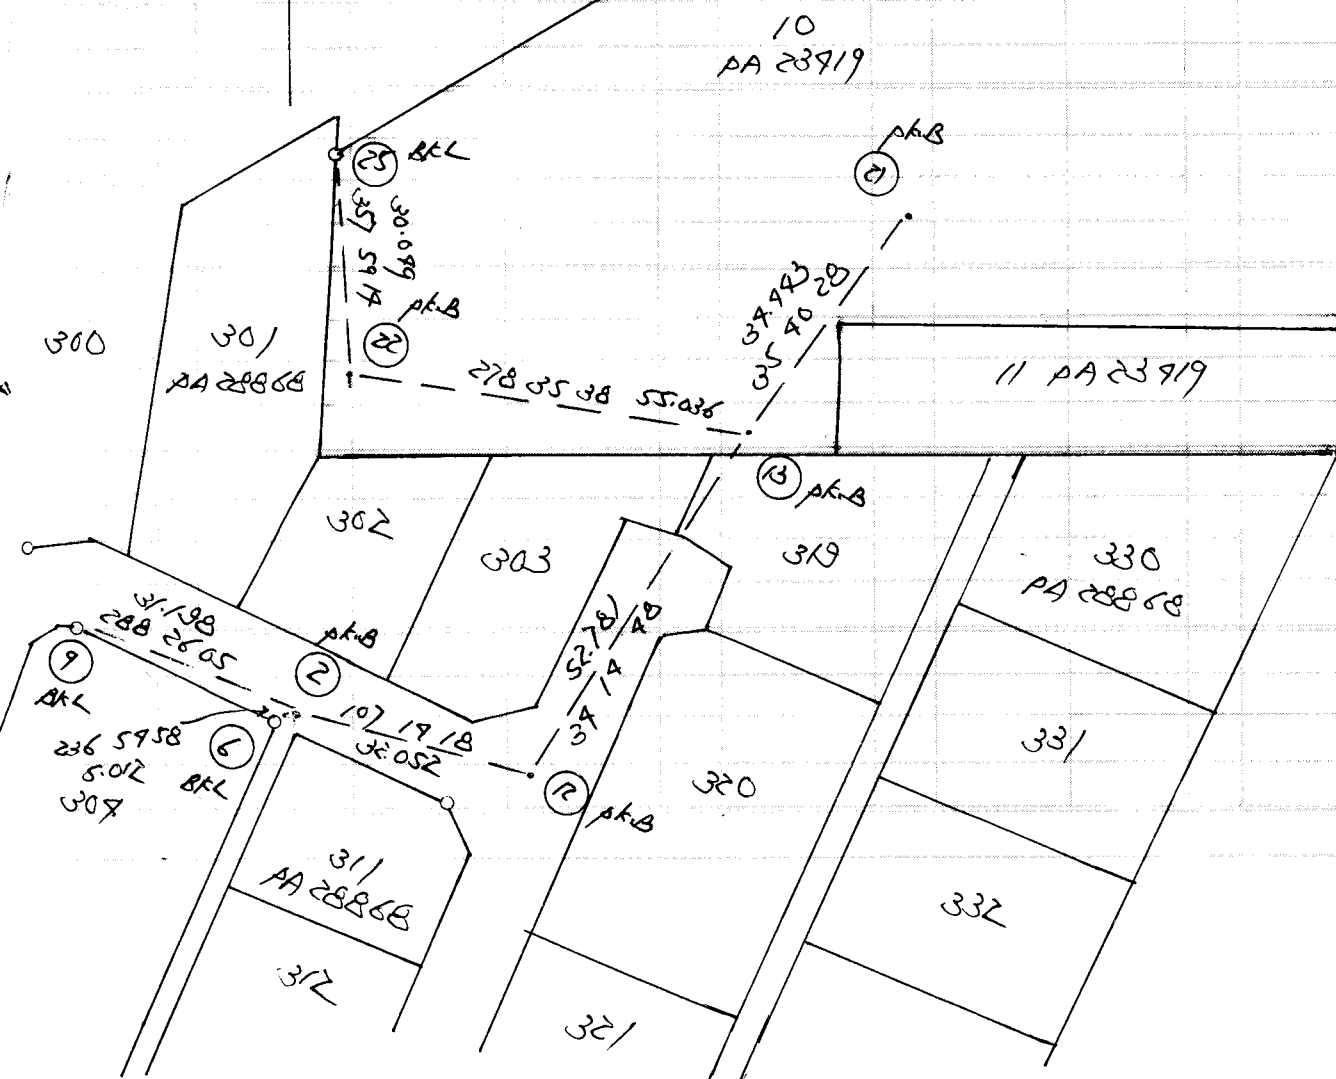

CERAPAN MATAHARI BAGI AZIMUT

 Penilik Foo Chee Yong Hari _____ Tarikh _____ Bulan _____ Tahun _____

 Stesen 12 T.R. 13 B.K. Ms. _____ Tiodolait (Jenis) _____ I Bah. Aras Ufuk - a _____

Formula:

$$\text{Kosain AZIMUT} = \frac{\text{Kos P} - \text{Sain } \phi \text{ Sain } \phi \text{C}}{\text{Kos } \phi \text{ Kos } \phi \text{C}}$$

56338

7/11 Gwiny

$$\text{Pembetulan Aras} = \frac{1}{8} (\pm R - \pm L) \text{ tenjen } \phi \text{C}$$

Waktu		Ufuk			Gelem-bong		Pugak			Tilkan ①	Bila waktu jam tangan tidak dalam lingkungan 3 menit daripada waktu piawai Hitung waktu umum.			W.U. - 12 ^J + W.T.K. - G. Bujur - E			
J	m	P.Ki	T.R		Ki	Ka					J	m		12 ^J	00 ^m		
				37 05 29													
			⊕	105 16 58			73	75	15								
			⊕	109 73 52			73	70	00								
		P.Ka	⊕	289 77 73			286	26	51								
			⊕	285 13 21			286	31	37								
Purata ①		T.R															
J	m																
87							16	23	18	Purata Tinjau							
		Purata Ke matahari		105 01 17			2	50		Biasan & Bedalihat							
		Purata Ke TR					16	20	28	Tinjau Dilaras							
J	m	P.Ki	T.R														
			⊕	105 20 77			73	18	15								
			⊕	109 77 33			73	13	07								
		P.Ka	⊕	289 78 17			286	52	73								
			⊕	285 23 01			286	58	08								
Purata ②		T.R															
J	m																
877							18	49	57	Purata Tinjau							
		Purata Ke matahari		105 07 53			2	75		Biasan & Bedalihat							
		Purata Ke TR					16	47	09	Tinjau Dilaras							
Kordinat Origin U/S		55961			m		Kordinat Origin f/B		21759			m		Purata Bg Gerid T.R		39 17 12	
Stesen f/S		7630			m		Stesen f/B		5512			m		Ditilik oleh		117 8' 49"	
Jumlah/Sel.		63851			m		Jumlah/Sel.		16271			m		Dihitung oleh			
Jumlah/Sel. x 0.03256 ±		- 0 37 32					Sel. G. Bujur - $\frac{\text{Jum. Sel.}}{\text{Sel.}}$ x 0.03246 ±		8' 47"					Tarikh			
G. Lintang Origin U		3 70 79					Sel. G. Bujur x Sain G. Lintang -										
G. Lintang Stesen U		3 06 16					T (-) / B (+) Tirusan -		29"								

 P.Ki - Penyilang Kiri
 P.Ka - Penyilang Kanan

 T.R. - Tanda Rujuk
 Sel - Selisih

 W.U. - Waktu Umum
 W.T.K. - Waktu Tempatan Ketara

Tarikh 27th Geoging Church Aras

355 338

Daripada

Dibuat untuk

22

Ke

Pandangan Belakang	Pandangan Antara	Pandangan Hadapan	Naik	Turun	Aras Yang Dilaras
3.955	(12.97)				38.862
	3.978	(13.05)			38.839
2.016	(16.61)	0.999	(13.12)		41.868
	1.579	(15.94)			42.355
1.996	(16.55)	0.333	(11.09)		43.551
0.792	(26.0)	0.591	(11.84)		44.956
	1.177	(15.64)			44.037
		2.311	(12.58)		43.4871
8.789		4.184			
1.854	(15.92)				43.437
3.028	(9.93)	0.822	(26.6)		
2.828	(9.28)	0.423	(11.39)		
1.993	(16.54)	0.388	(11.21)		
		2.125	(16.98)		49.1821
2.5031		3.788			
0.938	(13.08)				49.192
0.330	(11.09)	2.568	(8.43)		
0.193	(10.46)	2.799	(9.88)		
		0.941	(3.09)		44.095
1.7411		8.508			

Jarak	Catitan
422	
78M F1350	nailon top of sump Geokang huseh.
F13	
F21	
94	
94	
94	
94	
78M F1356	
78M F1355	
78M F1357	Di bawah tangkapan GMR
	pada kat ada panyang.
78M F1357	
	to university
78M F1356	
78M F1356	di atas s/b Geok di samping.
	7th universiti dgn p/kegung.
	pada X ada panyang.

Tarikh Aras

Dibuat untuk 23

Daripada

Ke

Pandangan Belakang	Pandangan Antara	Pandangan Hadapan	Naik	Turun	Aras Yang Dilaras	Jarak	Catitan
0.202 (10.67)					78.095	78M 1.1308	
0.908 (22.97)		2.557	(28.37)			8M 1.5085	
		2.600	(8.13)				
1.087 (33.57)	1.076 (33.53)				78.636	8M 1.0506	
1.752 (51.75)	0.009 (0.13)				78.687	78M 1.357	avail/aku spot light gantung dntu skema/
1.877 (56.16)	0.809 (22.65)				75.688	8M 1.0506	↓ paku x ada panyang. 11/12/20
1.514 (49.92)	1.567 (51.12)						
0.865 (22.83)	2.283 (72.35)						
0.782 (22.57)	2.185 (71.17)						
	1.581 (55.19)				78.095	78M 1.1358	
2.877 /		8.918					