

No. Laji

PUT 8590 Selayang.


Rajah di muka

No. Laji		LADANG		No. Laji		LADANG		No. Laji		LADANG		No. Laji		LADANG		No. Laji		LADANG	
No. Laji		LADANG		No. Laji		LADANG		No. Laji		LADANG		No. Laji		LADANG		No. Laji		LADANG	
Dahur Dapada		2	20 7909	1	4	33.165		11/9/09		33.165									
			A. A. BCL																
			Dg 1 M4																
1	20 7909 170 7909	57 3350	2	57 3350	3	4	111.573					111.573							
2	57 3350	237 3350																	
3	ptt.																		
2	237 3350 57 3350	205 2029	3	205 2029	4	4	8.737					8.737							
3	205 2029	25 2029																	
4	ptt.																		
2	Seperti Di Atas	157 5372	3	157 5372	5	4	87.903					87.903							
3	157 5372	237 5372																	
5	ptt.																		
2	Seperti Di Atas	318 3210	3	318 3210	6	4	98.719					98.719							
3	318 3210	138 3210																	
6	ptt.																		
3-7	330 1658		3	330 1658	7	4	75.926					64cy pagen	75.926						
3-8	77 5950		3	77 5950	8	4	7.075					64cy pagen	7.075						
2	Seperti Di Atas	77 3926	3	77 3926	9	4	79.612					79.612							
3	77 3926	227 3926																	
9	ptt.																		

No. 10

Rajah di muka

5-10	3383913	5	3383913	10	4	31.827	HWP	31.827
5-11	3519291	5	3519291	11	4	16.732	HWP	16.732
5-12	292926	5	292926	12	4	7.512	HWP	7.512
9-13	175932	9	175932	13	4	32.699	ALL	32.699
9-14	800975	9	800975	14	4	35.759	ALL (10/681)	35.759
9-15	782731	9	782731	15	4	35.169	PL	35.169
32	1383210	3183210	3270731	6	3270731	16	4	51.737
6								
16	3270731	1970731						
pk								
1	3209909	1909909	2950900	2	2950900	17	4	38.953
2								
17	2950900	650900						
pk								
2	650900	2950900	2081055	17	2081055	18	4	102.226
17								
18	2081055	881055						
pk								

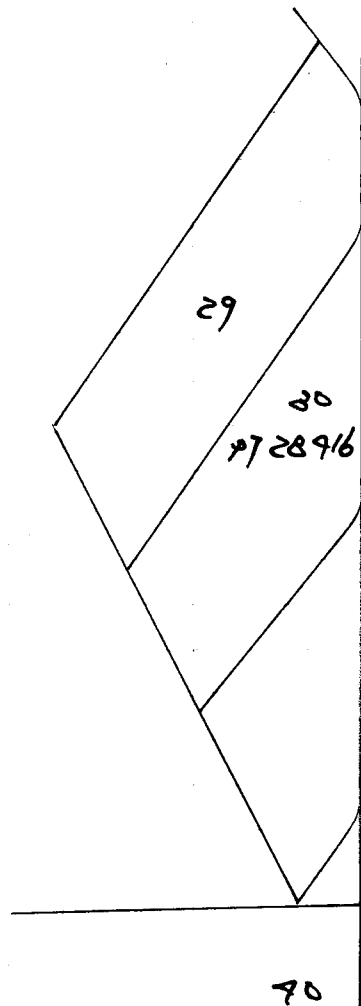

• ——— $\frac{102.226}{268 \quad 13 \quad 55}$ ———

(B) pk-B

AD SEL	95-66
C.L.R. K.L	2-3773-62

