

047 2761 LCC

21/5/2010

|     |                |         |   |            |   |   |         |         |
|-----|----------------|---------|---|------------|---|---|---------|---------|
| 1   | Antim Sanipada | 2832623 | 2 | 2832602    | 1 | 4 | 157.638 | 157.638 |
| 2   |                | M- 21"  |   |            |   |   |         |         |
| 2-3 | 12 16 20       |         | 2 | 12 1559 3  | 4 | 4 | 211.991 | 211.911 |
| 2-4 | 13 39 33       |         | 2 | 13 39 12 4 | 4 | 4 | 192.357 | 192.357 |
| 2-5 | 16 12 57       | M- 21"  | 2 | 16 1236 5  | 4 | 4 | 199.907 | 199.907 |
| 2-6 | 117 49 17      |         | 2 | 117 4356 6 | 4 | 4 | 31.777  | 31.777  |
| 2-7 | 280 03 58      |         | 2 | 280 0337 7 | 4 | 4 | 50.395  | 50.395  |
| 1-8 | 319 58 25      |         | 1 | 319 5809 8 | 4 | 4 | 93.757  | 93.757  |
| 1-9 | 312 05 39      |         | 1 | 312 0518 9 | 4 | 4 | 38.929  | 38.929  |

|    |                 |         |         |         |         |    |         |         |         |
|----|-----------------|---------|---------|---------|---------|----|---------|---------|---------|
| 2  | 103 28 23       | 2832623 | 2923553 | 1       | 2923532 | 10 | 4       | 172.681 | 172.681 |
| 1  |                 |         | M- 21"  |         | Aj Ak.  |    |         |         |         |
| 10 | 2923553         | 1123553 |         |         | Aj M4   |    |         |         |         |
|    | pt.B            |         |         |         |         |    |         |         |         |
| 1  | 1123553         | 2923553 | 2862089 | 10      | 2862023 | 11 | 4       | 150.679 | 150.679 |
| 10 |                 |         | M- 21"  |         |         |    |         |         |         |
| 11 | 2862089         | 562089  |         |         |         |    |         |         |         |
|    | pt.B            |         |         |         |         |    |         |         |         |
| 1  | Seperti Di Atas | 3253187 | 10      | 3253126 | 12      | 4  | 200.092 | 200.092 |         |
| 10 |                 |         | M- 21"  |         |         |    |         |         |         |
| 12 | 3253187         | 1953187 |         |         |         |    |         |         |         |
|    | pt.B            |         |         |         |         |    |         |         |         |
| 10 | 1953187         | 3253187 | 2862089 | 12      | 2862028 | 13 | 4       | 197.770 | 197.770 |
| 12 |                 |         | M- 21"  |         |         |    |         |         |         |
| 13 | 2862089         | 562089  |         |         |         |    |         |         |         |
|    | pt.A            |         |         |         |         |    |         |         |         |

12 562089 2862089 1962150 13 1962129 11 H 200.080 200.080  
13 M- 21'  
11 1962150 3262150


13 2862150 1962150 582089 11 562023 10 Sika Liket mks 15 R 9  
11 M- 21' Being  
10 582089 2862089 Tentup.



DAERAH SEPANG.  
BANDAR KLIA  
128A  
TANDA SKAKA

|     |           |            |
|-----|-----------|------------|
| 9-8 | 325 29 26 | SS. 753 N  |
|     | 325 29 72 | SS. 771 10 |
|     | <hr/>     |            |
|     | -18"      | -0.018     |

|     |           |            |
|-----|-----------|------------|
| 8-7 | 121 16 17 | 191.889 N  |
|     | 121 16 19 | 191.928 10 |
|     | <hr/>     |            |
|     | +3"       | -0.039     |

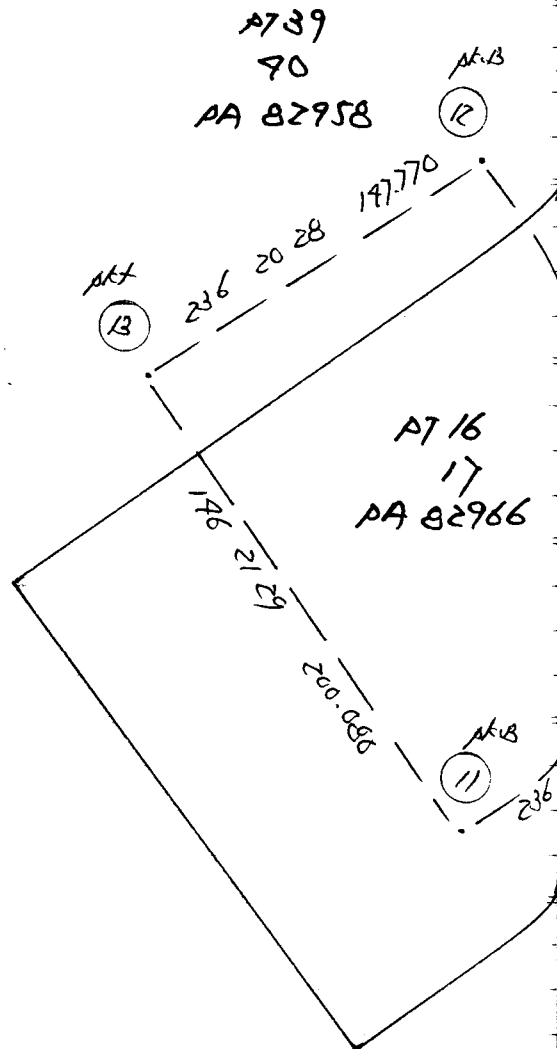

St. L.

(12)


9-8 325 29 26 55.753 ~  
325 29 42 55.771 10  
-18" -0.018

8-7      121 1617      191.8892  
 121 1619      191.92810  
 +3"      -0.039

Penilik: PUT2461 LCCT Tarikh: 21/05/2010

Stn. Koordinat: S50260.866 T2267.676 Selangor

T.R. B.K. Ms.

Tiodolit Satu bah. aras ufuk:

| Waktu | Sasaran | Ufuk      | Gelembong | Puguk                    |
|-------|---------|-----------|-----------|--------------------------|
|       | T.R.    | 112 35 54 |           |                          |
| 9 21  | M.H.    | 68 21 10  | 58 50 35  | Waktu purata 9 21 30     |
| 9 21  | M.H.    | 67 42 26  | 58 44 09  | Beza dari U.T. - 8 00 00 |
| 9 22  | M.H.    | 247 40 37 | 301 26 54 | U.T. 1 21 30             |
| 9 22  | M.H.    | 248 16 45 | 301 33 30 | Deklinasi 20 07 51       |
|       | T.R.    | 292 35 54 |           |                          |
|       | T.R.    | 112 35 54 |           |                          |
| 9 23  | M.H.    | 68 15 13  | 58 19 11  | Waktu purata 9 23 30     |
| 9 23  | M.H.    | 67 36 25  | 58 12 34  | Beza dari U.T. - 8 00 00 |
| 9 24  | M.H.    | 247 34 20 | 301 56 33 | U.T. 1 23 30             |
| 9 24  | M.H.    | 248 10 44 | 302 03 51 | Deklinasi 20 07 52       |
|       | T.R.    | 292 35 54 |           |                          |

|                         | Set 1     | Set 2     |
|-------------------------|-----------|-----------|
| Sudut pugak             | 31 21 25  | 31 52 10  |
| Pembetulan              | - 0 01 18 | - 0 01 17 |
| Altitud                 | 31 20 07  | 31 50 53  |
| Jarak kutub             | 69 52 09  | 69 52 08  |
| Latitud                 | 2 43 10   | 2 43 10   |
| Azimut M.H. yang dikira | 68 00 30  | 67 54 24  |
| Purata ke M.H.          | 68 00 15  | 67 54 10  |
| Selisih:                | 0 00 15   | 0 00 14   |
| Purata ke T.R.          | 112 35 54 | 112 35 54 |
| Azimuth T.R. sebenar    | 112 36 09 | 112 36 08 |
| Pembetulan aras         | + 0 00 00 | + 0 00 00 |
| Tirusan                 | - 0 00 37 | - 0 00 37 |
| Bering grid T.R.        | 112 35 32 | 112 35 31 |

Purata bering grid T.R. 112 35 32