

No. Fail

No. Fail 047398 7.71094959.

Rajah di muka

[illegible]

No. Fail


Rajah di muka

Stesen	BEARING / SUDUT			GARISAN		Ke Stn.	Sudut Pukak (±)	Jarak	Suhu	Jarak Antara Tupang	Jarak Mukamat
	Penyilang Kiri	Penyilang Kanan	Purata	Dari Stn.	Bearing Mukamat						
107	358 0933	178 0933	87 7017	106	87 7030	107	4	29.732			39.732
106			MT 9"								
107	87 7017	267 7017									
	PKT										
106	267 7017	87 7017	3 2928	107	3 29 40	108	4	70.295			70.295
107			MT 9"								
108	3 29 28	183 2928									
	PKT										
107	183 2928	3 29 28	107 5627	108	107 56 40 09		4	7.033			70.33
108			MT 9"								
109	107 5627	287 5627									
	BKL										
107	Seperti Di Atas	95 1139	108	95 1150 110		4		75.792			75.792
108			MT 9"								
110	95 1139	275 1139									
108	275 1139	95 1139	332 2901	110	332 29 10	111	4	8.578			8.578
110			MT 9"								
111	332 2901	152 2909									
	BKL										
108	Seperti Di Atas	157 35 110	157 40 101			4		57.370			57.370
110			MT 9"								
101	157 35	181 5735									
110	181 5735	157 35	275 4130	101	275 41 40	100	Sila	Rujuk m/s 29 R1			
101			MT 9"								
100	275 4130	95 4130									

Bearing 101-100 Dibaca 275 41 30
 Sepertinya Dibaca 275 41 30
 Tikaian Ni/
 Pembetulan Ni/

	No. Fail	Rajah di muka
Stesen	BEARING / SUDUT	DARI GARISAN K _a Sudut Pukak Jarak Suhu Jarak Antara Tupang Jarak Mukamat
Penyilang Kiri Penyilang Kanan Purata	Stn. Bearing Mukamat Stn.	(±)

Rajah di muka

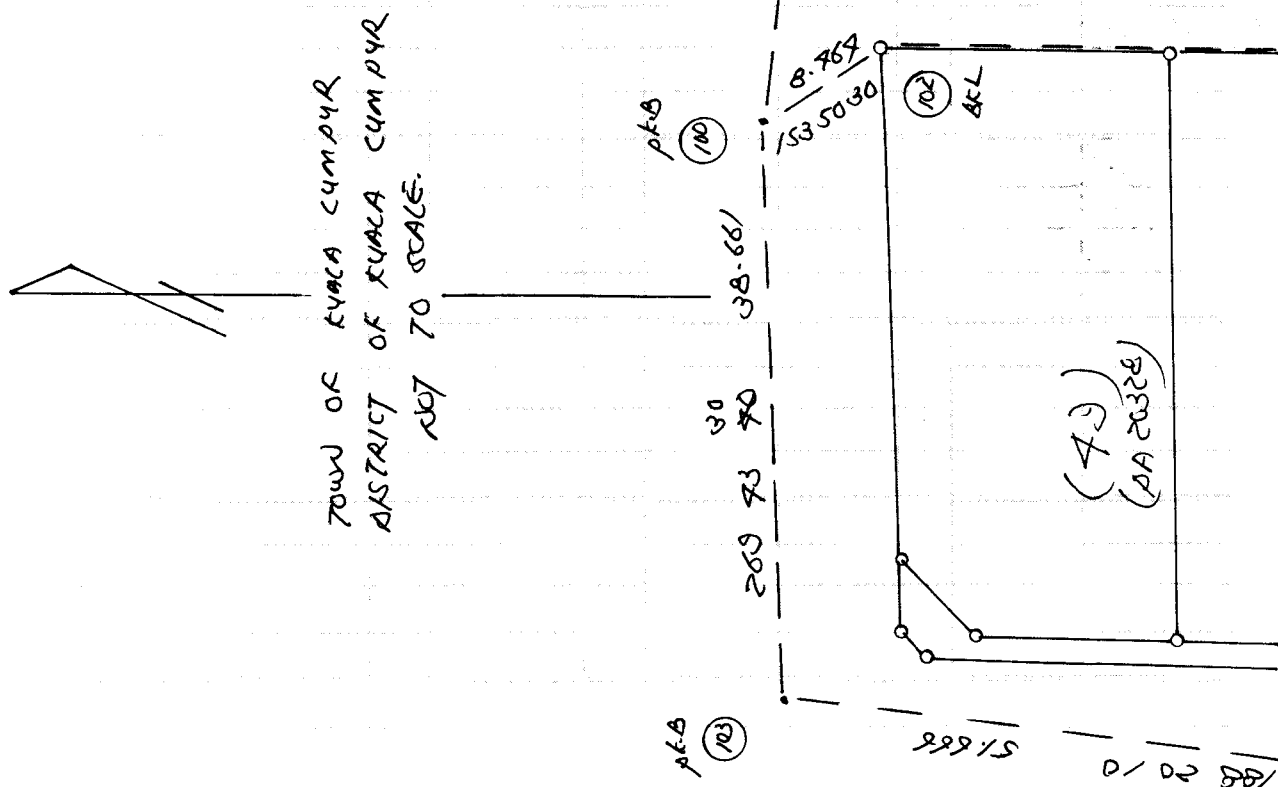

Rajah di muka

[illegible]