


Datum		Desimpul		23/2/37		2 100 0798 1		4		68.633		68.633	
		MT 23/17 TBM 1				pk.B.							
				20.32805									
23/2/37	23/2/37	350 7536	2	353 2250	3	4	27.837	27.837					
		MT 2 37 17											
		350 7536 170 7536											
		pk.B											
170 7536	350 7536	87 3320	3	90 1037	4	4	73.087	73.087					
		MT 2 37 17											
		87 3320 287 3320											
		pk.B											
Seperti	Di Atas	88 2256	3	91 0010	5	4	98.172	98.172					
		MT 2 37 17											
		88 2256 288 2256											
		pk.B											
288 2256	88 2256	357 7721	5	357 2735	6	4	38.370	38.370					
		MT 2 37 17											
		357 7721 177 7721											
		pk.B											
Seperti	Di Atas	97 7055	5	100 1809	7	4	80.719	80.719					
		MT 2 37 17											
		97 7055 277 7055											
		pk.B											
277 7055	97 7055	17 2016	7	19 5730	8	4	37.537	37.537					
		MT 2 37 17											
		17 2016 197 2016											
		TBM 2 pk.L											

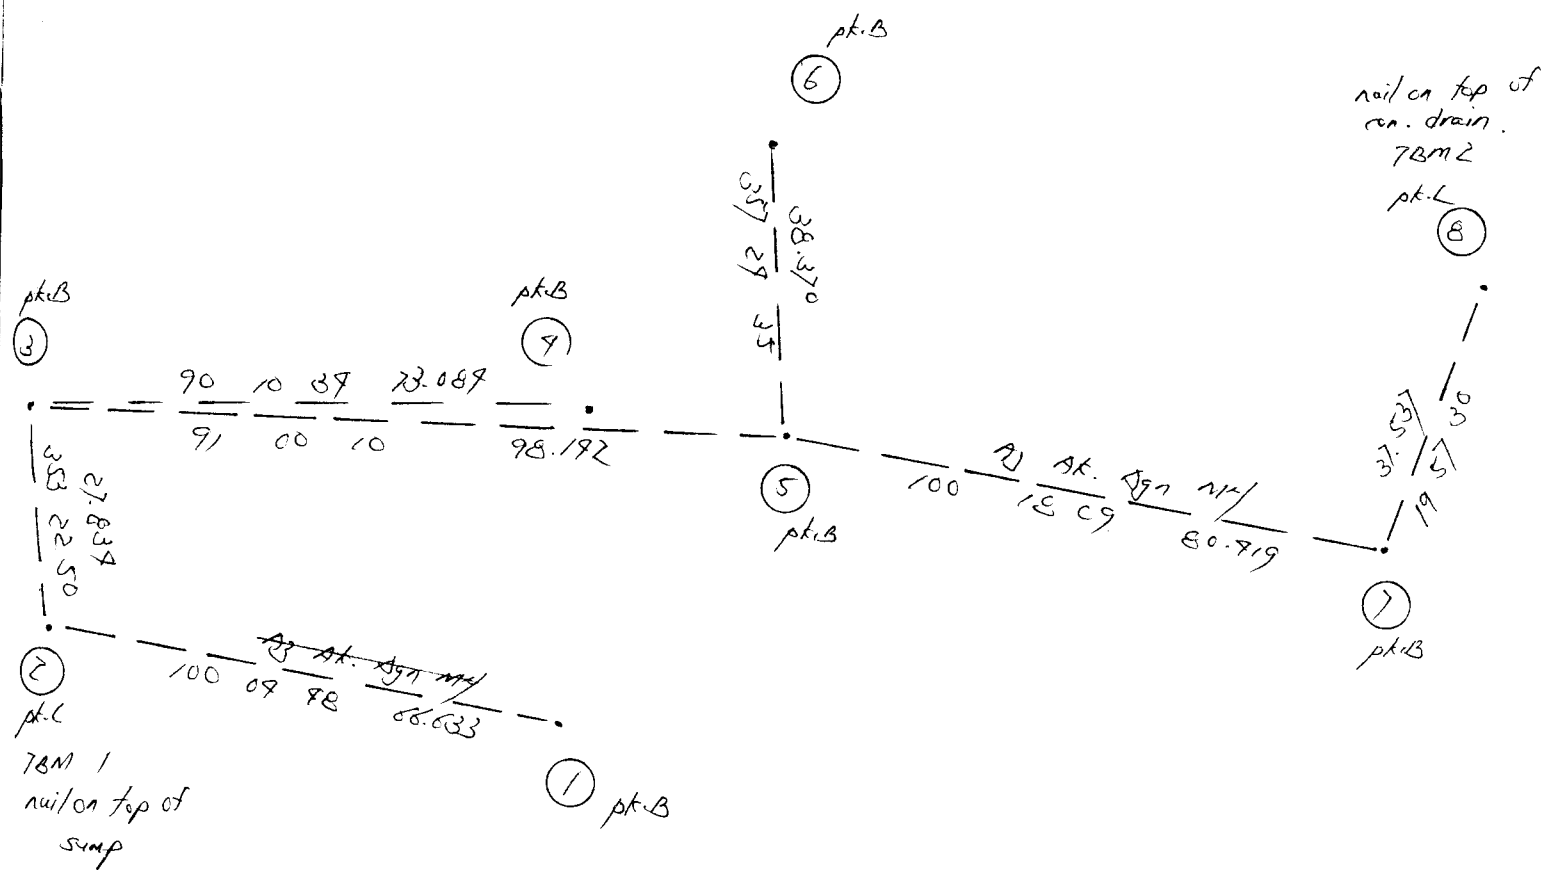

Penilik: PUT2290 Jln Kuchai Lama Tarikh: 14/01/2009
 Stn. 7 Koordinat: S9053 B1507 W.P. Kuala Lumpur
 T.R. 5 B.K. Ms.
 Tiodolit Satu bah. aras ufuk:

Waktu	Sasaran	Ufuk	Gelembong	Puguk		
	T.R.	277 40 55				
8 30	M.H.	110 35 25		75 31 52	Waktu purata	8 30 30
8 30	M.H.	110 02 34		75 27 21	Beza dari U.T. -	8 00 00
8 31	M.H.	290 03 12		284 38 22	U.T.	0 30 30
8 31	M.H.	290 37 46		284 43 44	Deklinasi	- 21 18 52
	T.R.	97 40 55				
	T.R.	277 40 55				
8 32	M.H.	110 39 24		75 08 45	Waktu purata	8 32 30
8 32	M.H.	110 06 22		75 04 42	Beza dari U.T. -	8 00 00
8 33	M.H.	290 07 06		285 01 22	U.T.	0 32 30
8 33	M.H.	290 41 38		285 06 22	Deklinasi	- 21 18 51
	T.R.	97 40 55				

	Set 1	Set 2
Sudut pugak	14 35 43	14 58 34
Pembetulan	- 0 03 12	- 0 03 07
Altitud	14 32 31	14 55 27
Jarak kutub	111 18 52	111 18 51
Latitud	3 05 32	3 05 32
Azimut M.H. yang dikira	112 57 33	113 01 27
Purata ke M.H.	110 19 44	110 23 38
Selisih:	2 37 49	2 37 49
Purata ke T.R.	277 40 55	277 40 55
Azimuth T.R. sebenar	280 18 44	280 18 44
Pembetulan aras	+ 0 00 00	+ 0 00 00
Tirusan	- 0 00 35	- 0 00 35
Bering grid T.R.	280 18 09	280 18 09
Purata bering grid T.R.	280 18 09	

247 2290

Aras

Dibuat untuk

54

Tarikh
 Daripada

Ke

Pandangan Belakang	Pandangan Anlara	Pandangan Hadapan	Naik	Turun	Aras Yang Dilaras	Jarak	Catitan
1.590 (15.22)	1.527 (15.01)				32.805	12 / 78m 2 78m 1	RC: 32.805m
1.977 (14.89)	1.525 (14.90)				32.870	9	
1.533 (15.03)	1.627 (14.52)				32.853	19	
	1.377 (14.52)				32.723	15	
1.952 (14.76)	1.900 (14.52)				32.879	16	
	1.572 (14.52)				32.356	14	
6.052	6.621				32.286	78m 2	