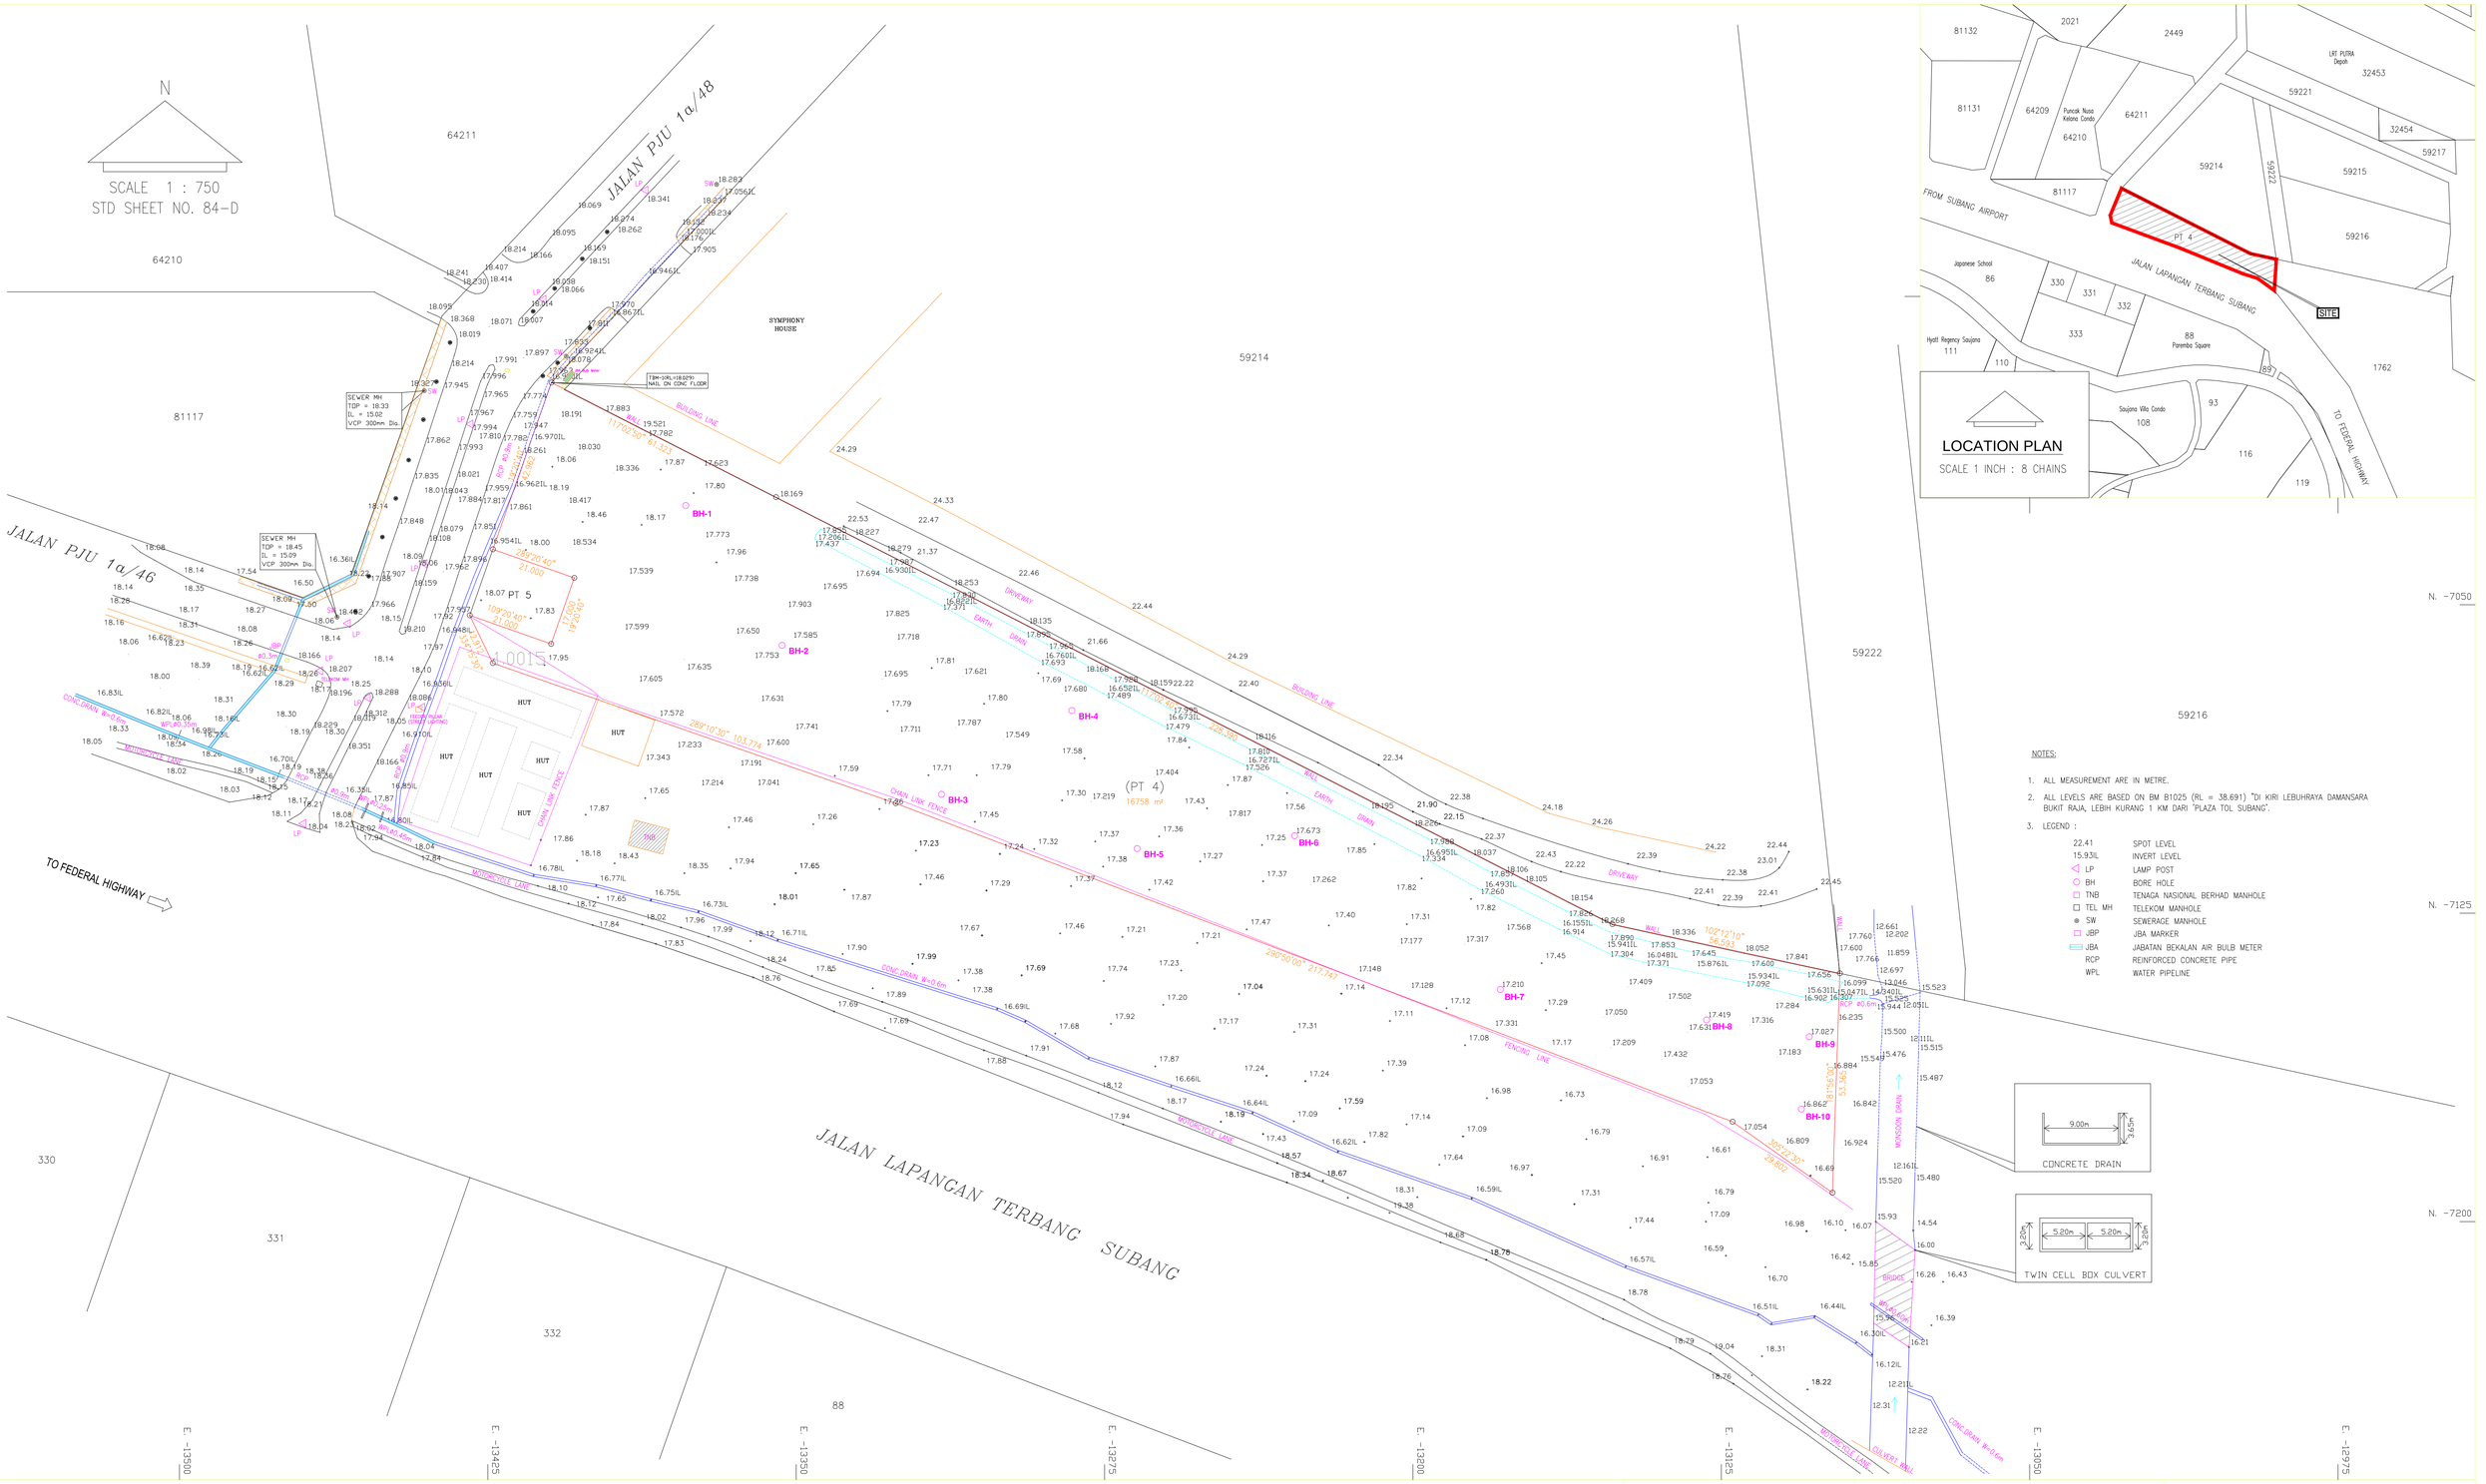


NOTES:

1. ALL MEASUREMENT ARE IN METRE.
2. ALL LEVELS ARE BASED ON BM B1025 (RL = 38.691) "DI KIRI LEBUHRAYA DAMANSARA BUKIT RAJA, LEBIH KURANG 1 KM DARI "PLAZA TOL SUBANG".
3. LEGEND :

22.41	SPOT LEVEL
15.93IL	INVERT LEVEL
LP	LAMP POST
BH	BORE HOLE
TNB	TENAGA NASIONAL BERHAD MANHOLE
TEL MH	TELEKOM MANHOLE
SW	SEWERAGE MANHOLE
JBP	JBA MARKER
JBA	JABATAN BEKALAN AIR BULB METER
RCP	REINFORCED CONCRETE PIPE
WPL	WATER PIPELINE

DETAIL AND SPOT LEVEL SURVEY ON PT 4,
MUKIM OF DAMANSARA, DISTRICT OF PETALING,
SELANGOR DARUL EHSAN.

SURVEYED	BY :	MICHAEL TAN 19.04.2013
COMPUTED	BY :	KHAIRI 22.04.2013
DRAWN	BY :	AHMAD 14.05.2013
CHECKED	BY :	KHAIRI 14.05.2013

NG BOON CHYE
Jurukur Tanah Berlesen
M.Sc. Land Admin & Dev., B.Surv.(Land)(Hons), M.R.I.S.M., M.A.A.L.S.
Berlesen di bawah Akta 458 (di semak 1991)

JURUKUR GEOMARK CONSULT
1-3A, 1st Floor, Plaza KLH Business Centre,
Bandar Puchong Jaya,
47100 Selangor.
Tel: 03-80709921 Fax: 03-80709931
Email : jgc.selangor@gmail.com

PLAN NO : JGC/581/SEL/2013/TP/4

Digital data : D:\AHMAD\2013\JGC581\JGC581-TP4.dwg