
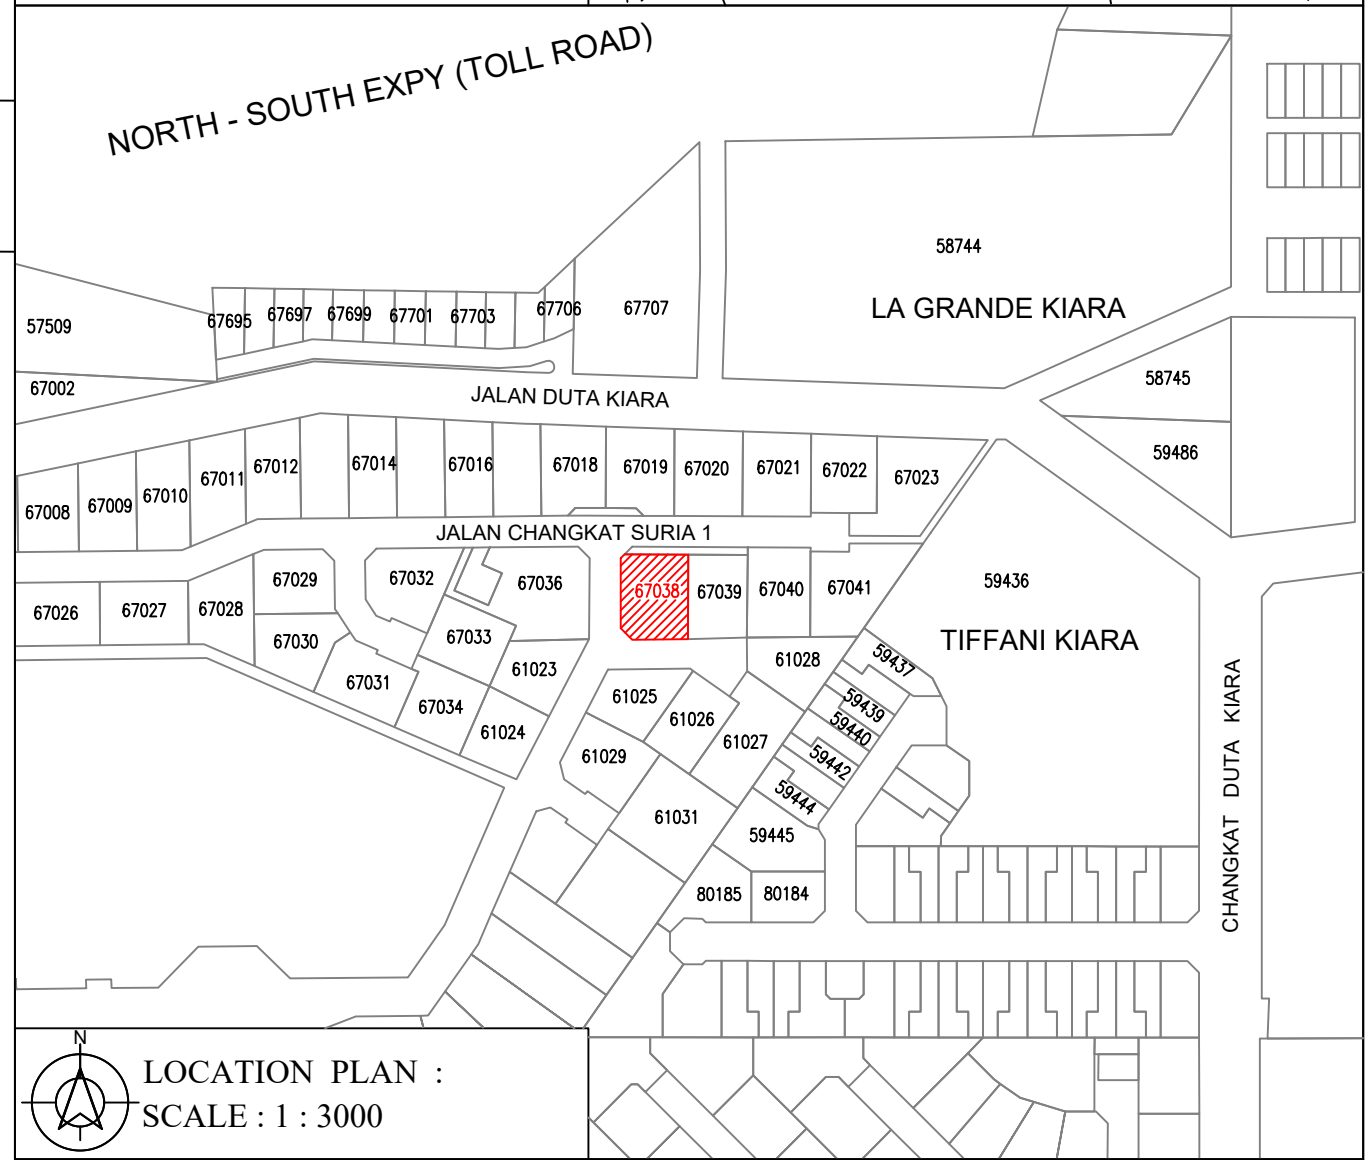
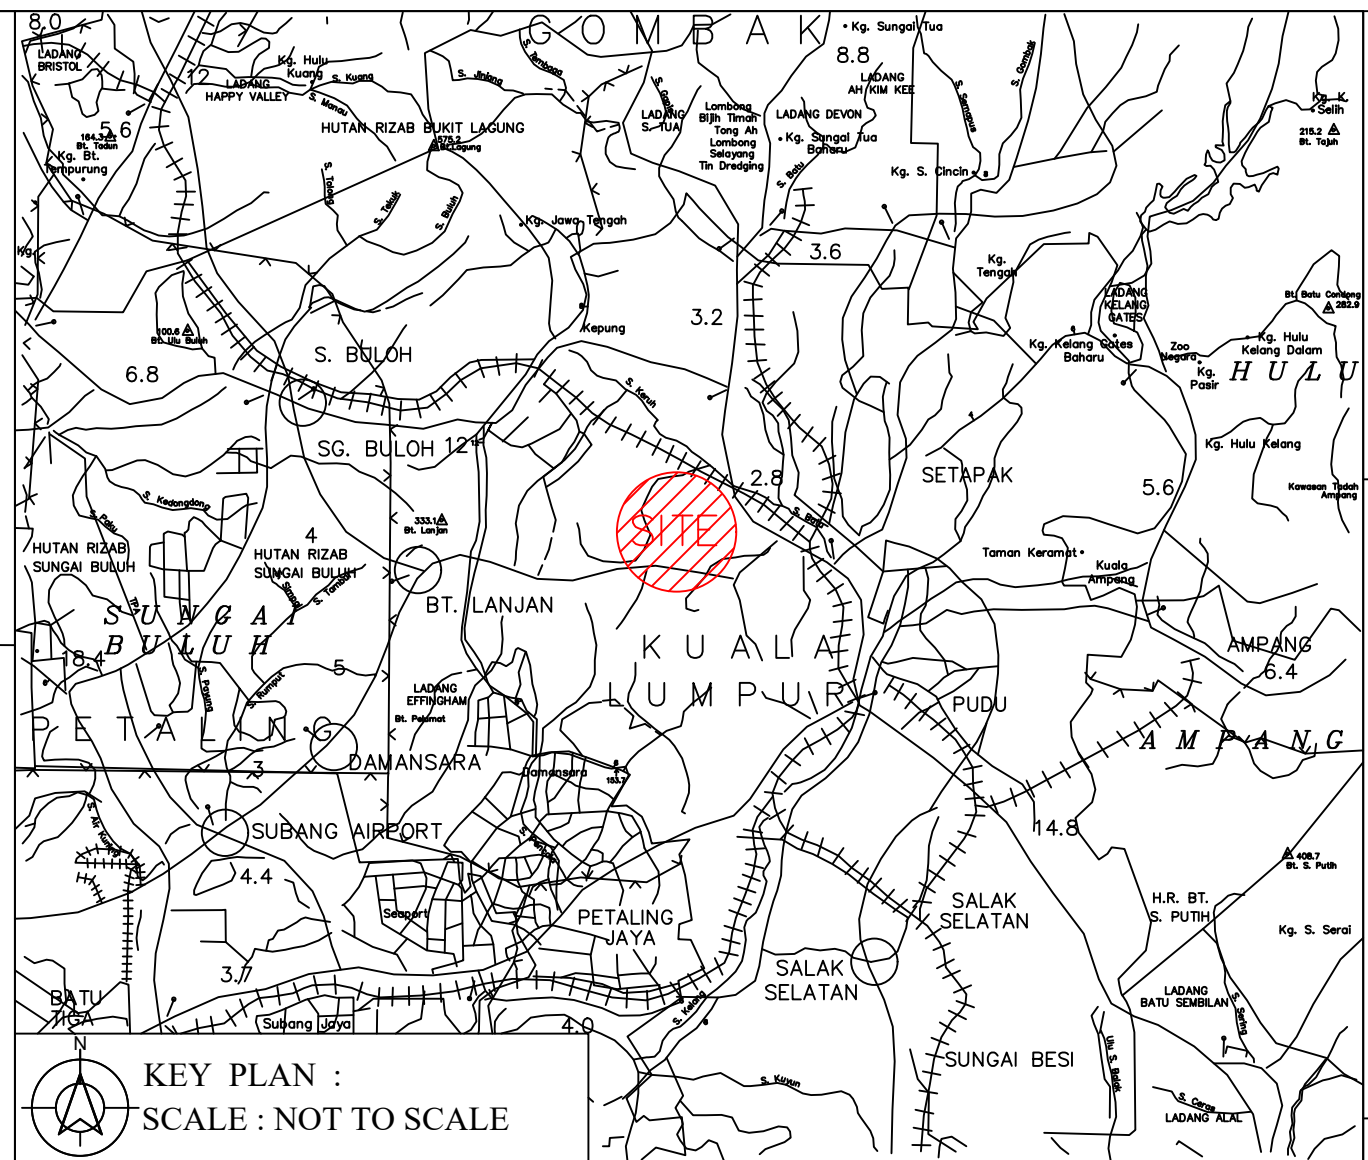


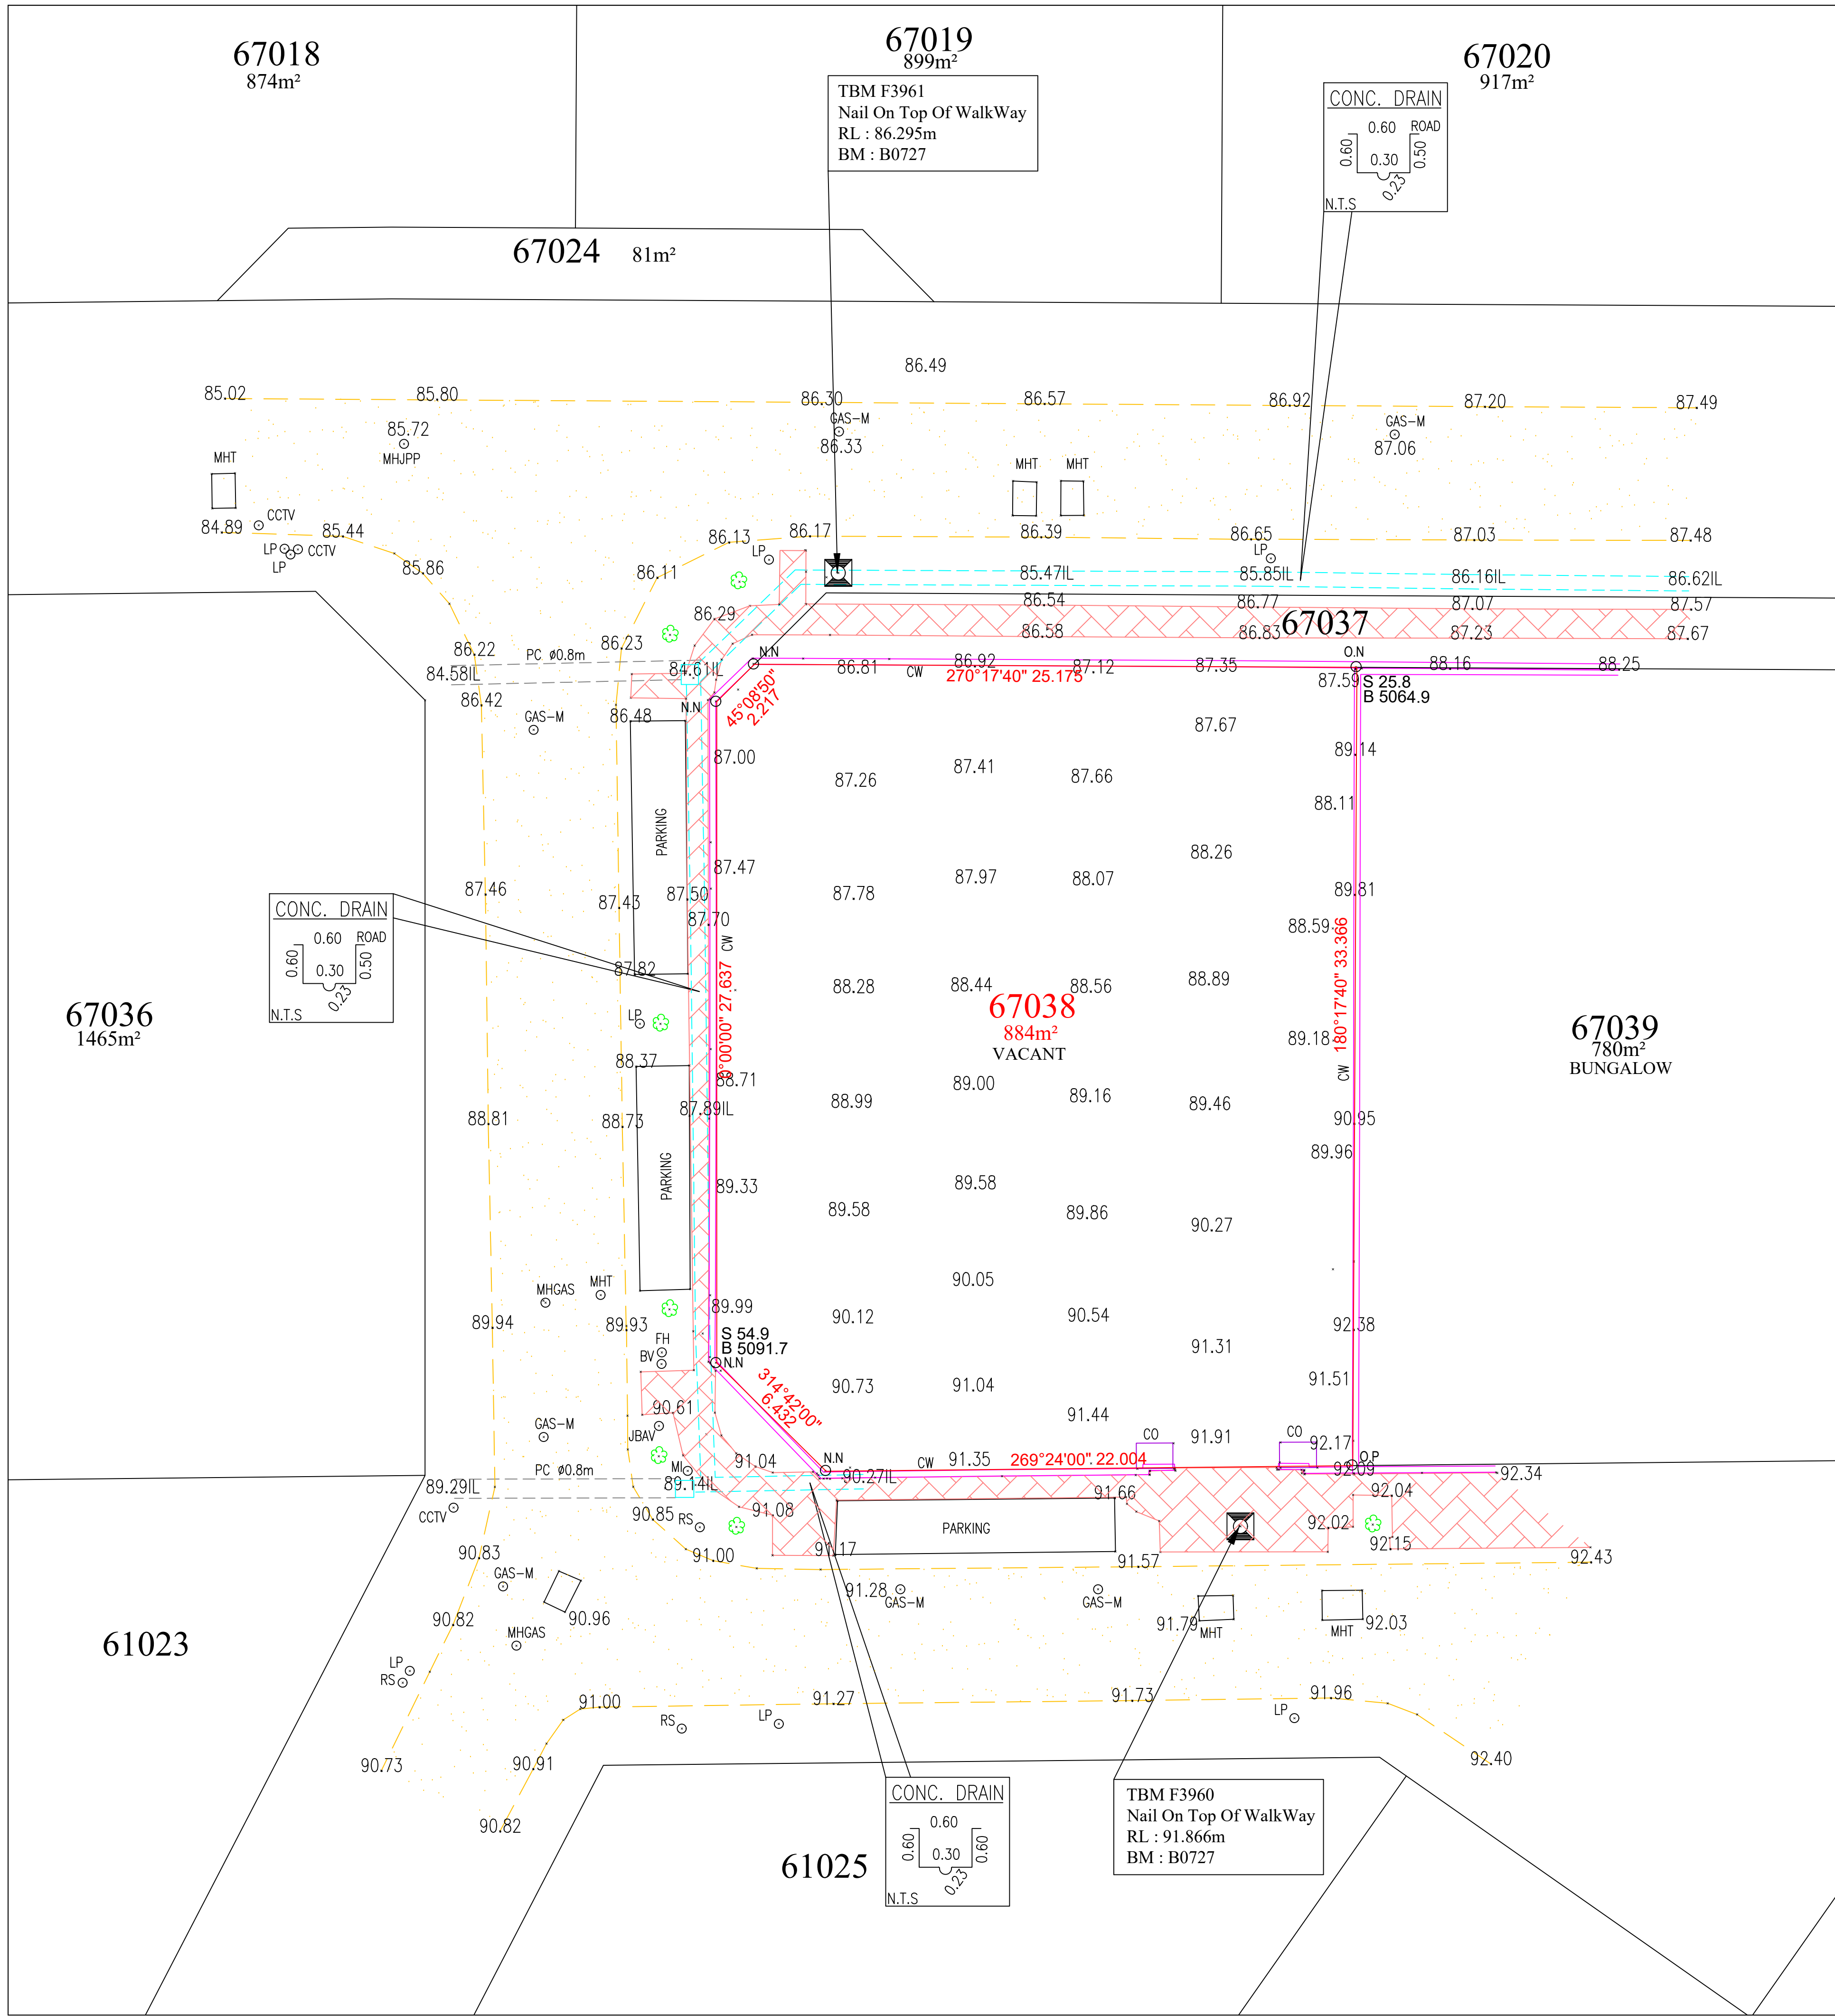

SCALE 1 : 150
STD. SHEET : 85-B

PROJECT :

TOPOGRAPHICAL SURVEY
AND DEMARCATION WORK ON
LOT 67038, MUKIM BATU,
DAERAH KUALA LUMPUR,
WILAYAH PERSEKUTUAN
KUALA LUMPUR.

LEGENDS :-

1.	N.N	NEW NAIL
2.	O.N	OLD NAIL
3.	O.P	OLD PIPE
4.	LP	LAMP POST
5.	JBAV	SLUICE VALVE
6.	BV	BOMBA VALVE
7.	FH	FIRE HYDRANT
8.	MHJPP	MANHOLE JABATAN PERKHIDMATAN
9.	MHT	MANHOLE TELEKOM
10.	MHGAS	MANHOLE GAS
11.	GAS-M	GAS MARKER
12.	PC	PIPE CULVERT
13.	CW	CONCRETE WALL
14.	MI	MIRROR
15.	CCTV	CLOSED CIRCUIT TELEVISYEN
16.	RS	ROAD SIGN
17.	CO	COLUMN
18.		COVERED DRAIN
19.		METALLED ROAD
20.		TREE

NOTE :-

- ALL MEASUREMENTS ARE IN METRES.
- ALL LEVELS ARE BASED ON BM B 0727 (RL=45.773m)
- ALL BEARING DISTANCES AND AREA ARE BASED ON CP111925.

SURVEYED BY :
FOO AUG.2021

DRAWN BY :
IRA AUG.2021

CHECKED BY :
VINCENT

LICENSED LAND SURVEYOR :

ST. LAU WEI SENG
B. GEOMATICS (MRLB) HONS. R.I.S.M (M)
Jurukur Tanah Yang Dilemah Di bawah Akta 458
20-2, JALAN PUU 5/15
DATARAN SUNWAY
KOTA DAMANSARA
47810 PETALING JAYA
Tel : 03-61579888 Fax : 03-61572145 E-mail : main@put.com.my

PLAN NO : PUT/W4241/2021/DD/P1