



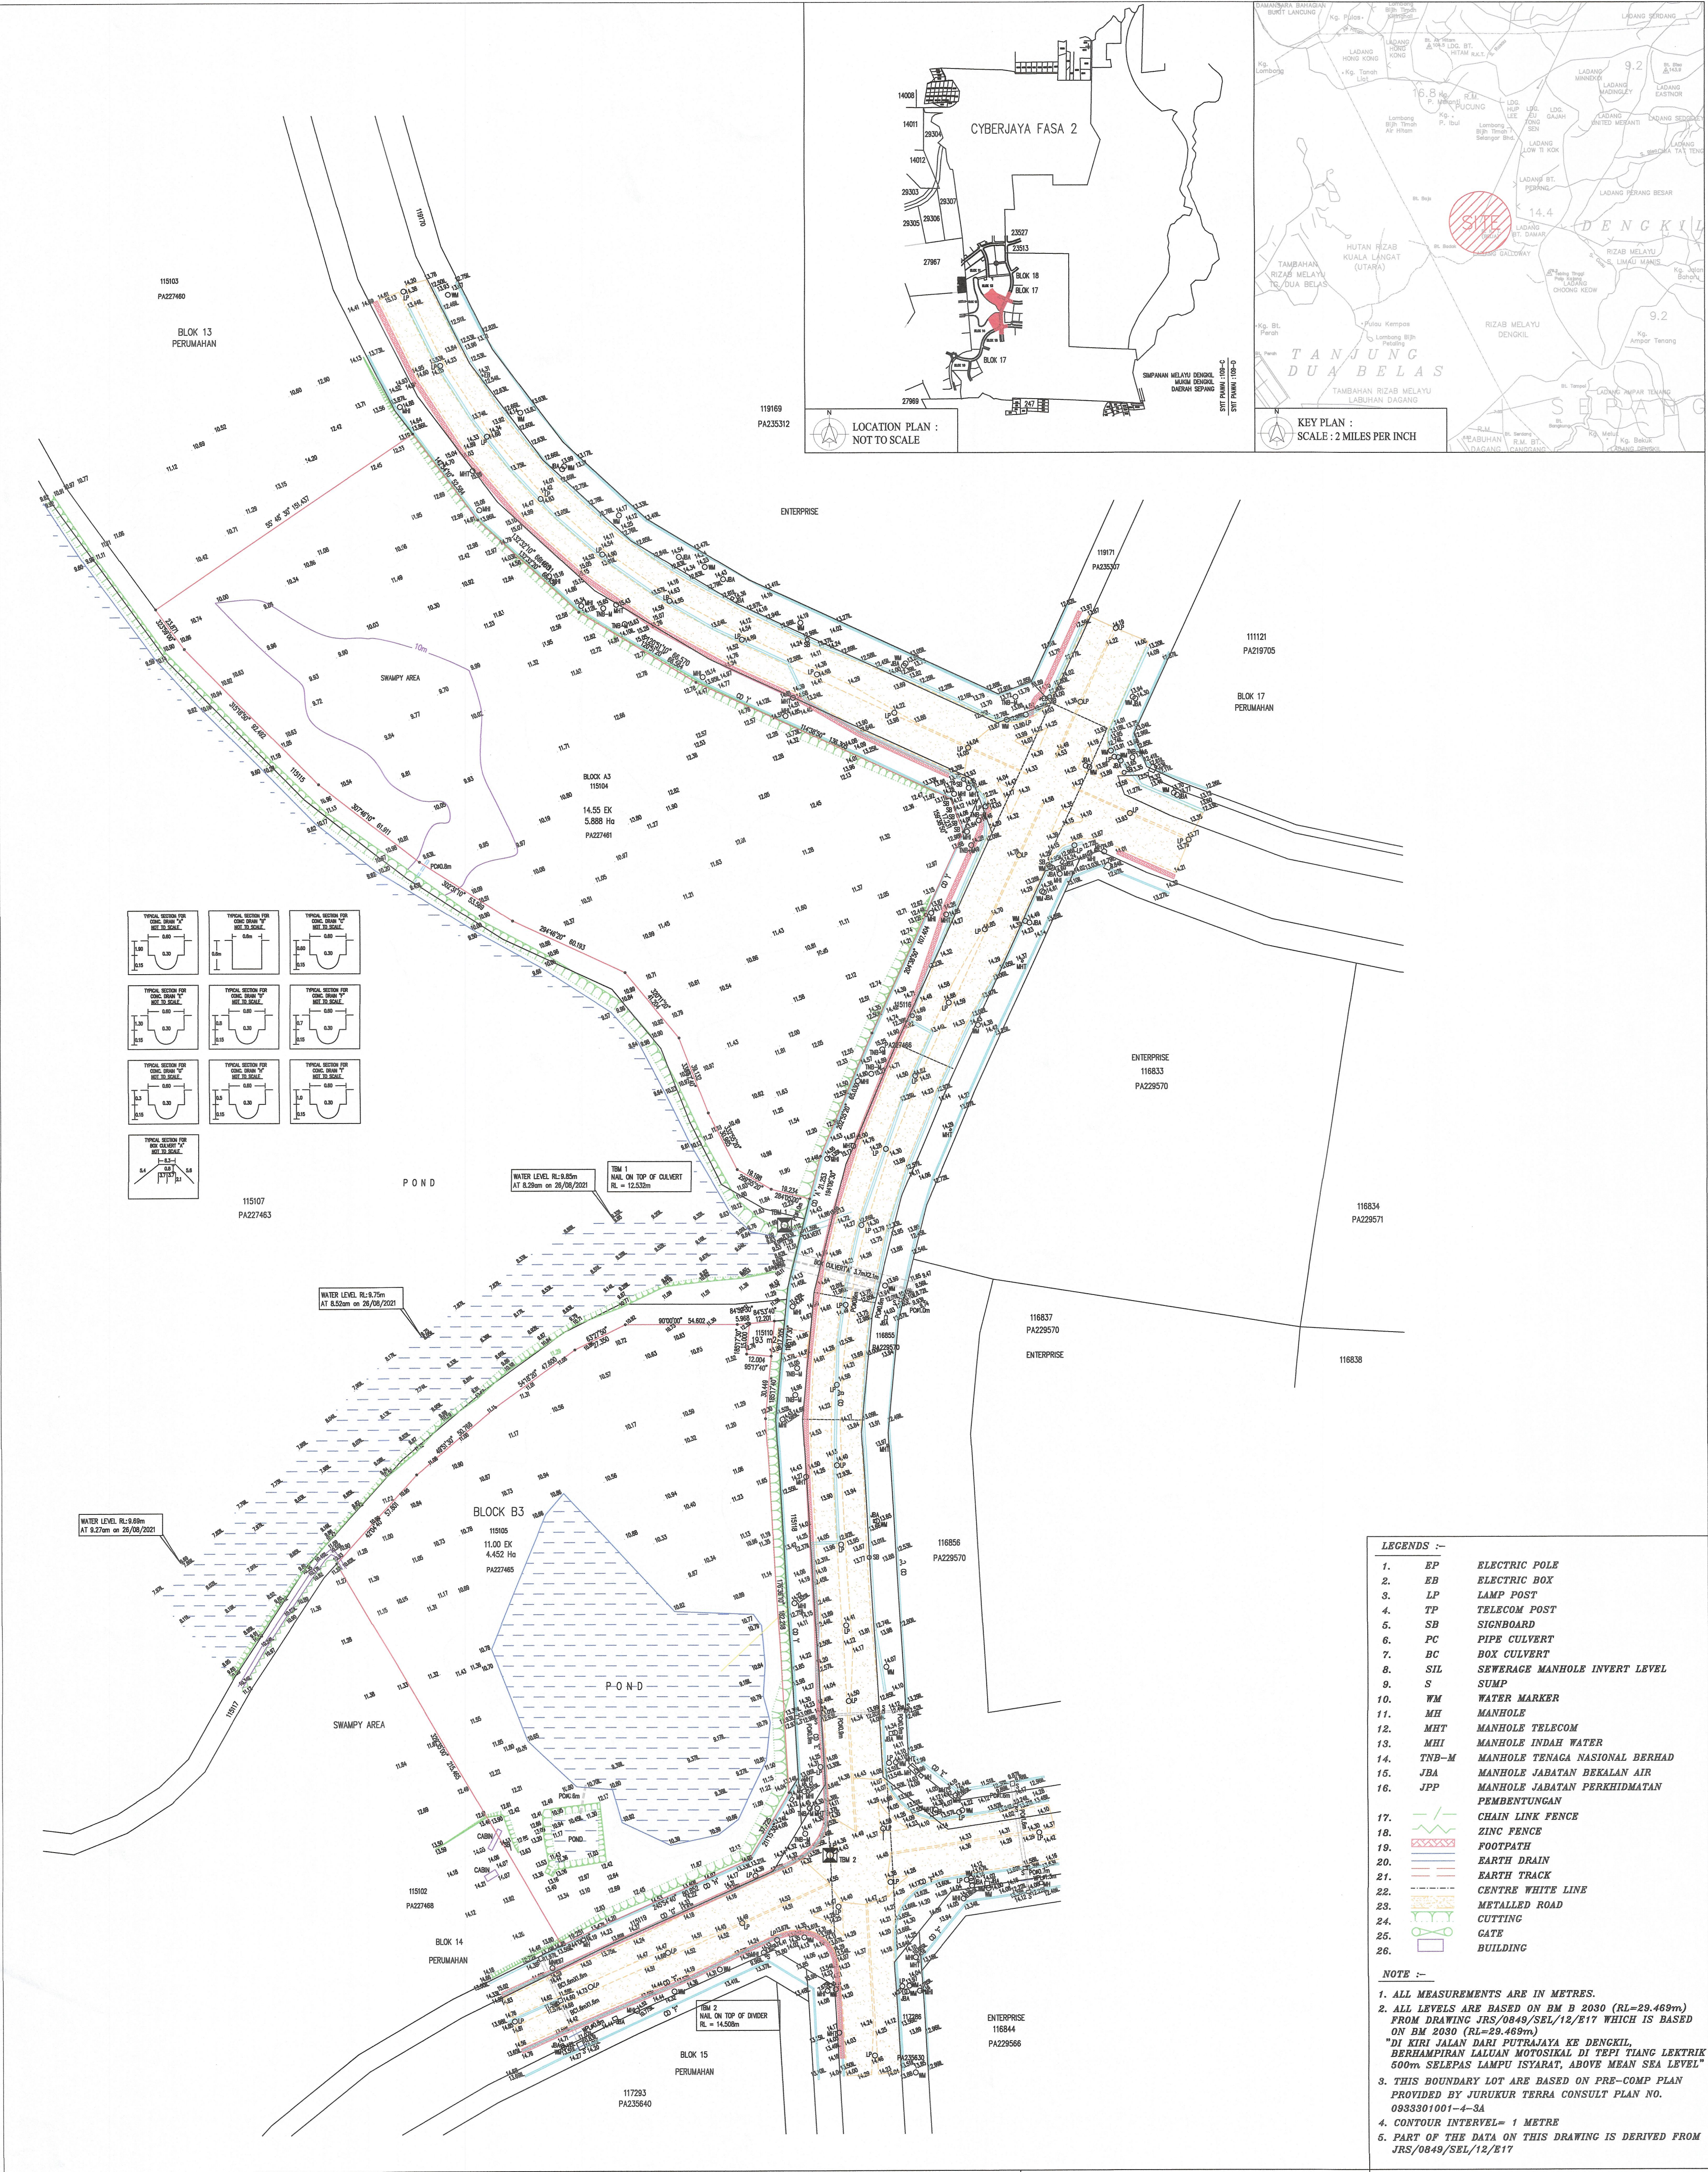

PROJECT :

DETAIL AND LEVELLING SURVEY FOR LOT 115104
AND 115105 MUKIM OF DENGKIL, DISTRICT OF
SEPANG, SELANGOR DARUL EHSAN.

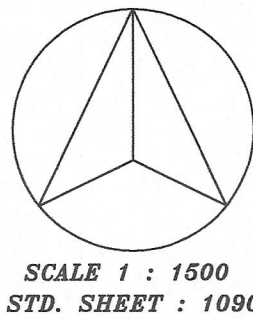

SURVEYED BY :
DRAWN BY : HAZIRAH DEC.2024
CHECKED BY : VINCENT
DRAWING NO : 241218- BLOK A3 & B3-ADDITIONAL-UPDATE-LOT

LICENSED LAND SURVEYOR :

UKUR TEKUN SDN. BHD.
20-2, JALAN PUJ 5/15
DATARAN SUNWAY
KOTA DAMANSARA
47010 PETALING JAYA
Tel : 03-61579988 Fax : 03-61572145 E-mail : main@put.com.my

PLAN NO : PUT/B4922/2024/TD/P1