

JM 2287 Sg Buluh Actan.

|   |              |          |         |         |         |   |         |        |         |
|---|--------------|----------|---------|---------|---------|---|---------|--------|---------|
|   |              |          |         |         |         |   |         | 6/5/17 |         |
|   | Datum        | Daripada | 2       | 3392903 | 1       | 4 | 71.737  |        | 71.737  |
|   |              |          |         | A7 Ak.  |         |   |         |        |         |
|   |              |          |         | Sgn MY  |         |   |         |        |         |
| 1 | 3392903      | 1592903  | 1700821 | 2       | 1700821 | 3 | 4       | 77.019 | 77.019  |
| 2 |              |          |         |         |         |   |         |        |         |
| 3 | 1700821      | 3200821  |         |         |         |   |         |        |         |
|   |              | pkB      |         |         |         |   |         |        |         |
| 1 | Sgn. Di Atas | 555826   | 2       | 555826  | 7       | 4 | 192.651 |        | 192.651 |
| 2 |              |          |         |         |         |   |         |        |         |
| 7 | 555826       | 2355826  |         |         |         |   |         |        |         |
|   |              | pkB      |         |         |         |   |         |        |         |
| 2 | 2355826      | 555826   | 1930501 | 7       | 1930501 | 5 | 4       | 57.585 | 57.585  |
| 7 |              |          |         |         |         |   |         |        |         |
| 5 | 1930501      | 3230501  |         |         |         |   |         |        |         |
|   |              | pkB      |         |         |         |   |         |        |         |
| 7 | 3230501      | 1930501  | 581218  | 5       | 581218  | 6 | 4       | 28.667 | 28.667  |
| 5 |              |          |         |         |         |   |         |        |         |
| 6 | 581218       | 2381218  |         |         |         |   |         |        |         |
|   |              | pkB      |         |         |         |   |         |        |         |
| 7 | Sgn. Di Atas | 2365350  | 5       | 2365350 | 7       | 4 | 161.868 |        | 161.868 |
| 5 |              |          |         |         |         |   |         |        |         |
| 7 | 2365330      | 565350   |         |         |         |   |         |        |         |
|   |              | pkB      |         |         |         |   |         |        |         |
| 5 | 565330       | 2365350  | 2513570 | 7       | 2513570 | 3 | 4       | 30.179 | 30.179  |
| 7 |              |          |         |         |         |   |         |        |         |
| 3 | 2513570      | 713570   |         |         |         |   |         |        |         |

7 713590 25/3590 320 082/ 3 320 082/ 2 Sila Lihai m/s 15 R 2  
 3 2 320 082/ 180 082/ Bring Tentatup.

Bring 3-2 Diberan 320 082/

Spatulaya Diberan 320 082/

Tikuan N/

Ambatula N/

5 238 1218 58 1218 98 0920 6 98 0920 8 H 73.636 73.636

6 8 98 0920 278 0920

pk

8-9 239 9099

8 239 9099 9

H

33.582

PL

33.582

8-10 51 2720

8 51 2720 10

H

57.790

PL

57.790

Demarcat.

6-11 313 0638

6 313 0638 11

H

60.280

PB

60.280

6-12 303 3926

6 303 3926 12

H

20.197

PB

20.197

6-13 225 9919

6 225 9919 13

H

7.989

PB

7.989

2-19 128 1913

2 128 1913 19

H

56.112

pkL

56.112

2-15 27 2005

2 27 2005 15


H

12.889

pkL

12.889

7

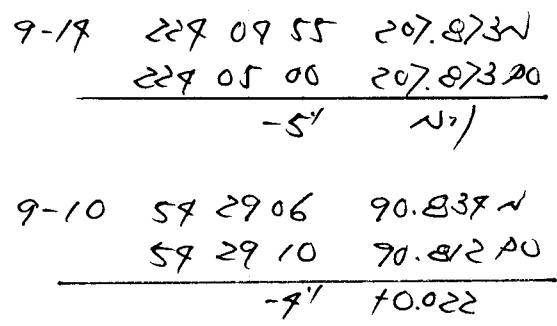

Jan 2287

Acton 29 Bu/h

Location

## Purpose

[illegible]